Hamrick Addition

Carl Barbee Addition

North Elementary School Addition

MASCOT STA 1+60.55
CONSTRUCT STANDARD DRIVE
MATCH TOP OF ROLL CURB.
(W = 12.0')

MASCOT STA 2+17.15
CONSTRUCT STANDARD DRIVE
MATCH TOP OF ROLL CURB.
(W = 12.0')

MASCOT STA 3+33.55
CONSTRUCT STANDARD DRIVE
MATCH TOP OF ROLL CURB.
(W = 12.0')

MASCOT STA 3+81.20
CONSTRUCT STANDARD DRIVE
(W = ~~12.0'~~) 25.0'

MOVE THIS DRIVE 2.0' TO THE NORTH TO COMPLY WITH 6.0' PROPERTY LINE SETBACK.

REMOVE AND RESET EXISTING "NO OUTLET" SIGN AS NECESSARY FOR CONSTRUCTION.

REMOVE AND RELOCATE EXISTING STOP SIGN TO STA 5+76, 33' LT

EXISTING SNS SIGN

CONCRETE PAVING SEE GRADING DETAILS SHEET 13

FOR INTERSECTION DETAILS SEE SHEET 13

6.0' SETBACK

MOVE 2.0' N

OHE CTV OVERHEAD

Existing Telephone (3)

Existing Gas

Existing Overhead Electric

Existing Water

Mascot

33rd Street N

1+00 2+00 3+00 4+00 5+00 6+00

25.00' 25.00' 60' ROW 35' 25.00'

33RD ST N, STA 2+26.21 = MASCOT STA 6+04.65

STA 1+40 BEGIN TYPICAL 31'
7"AC ON 6" CR BASE SECTION
SEE SECTION DETAILS SHEET 2

MASCOT STA 3+11.10
CONSTRUCT STANDARD DRIVE
(W = 21.0')

CONSTRUCT COMBINED
ROLL TYPE CURB (3 9/16")
(BOTH SIDES)


STA 5+69.63 END TYPICAL 31'
7"AC ON 6" CR BASE SECTION
SEE SECTION DETAILS SHEET 2

REMOVE AND RELOCATE
EXISTING STOP SIGN
TO STA 5+70, 22'RT

EXISTING STOP SIGN

Proposed SWS

(1)

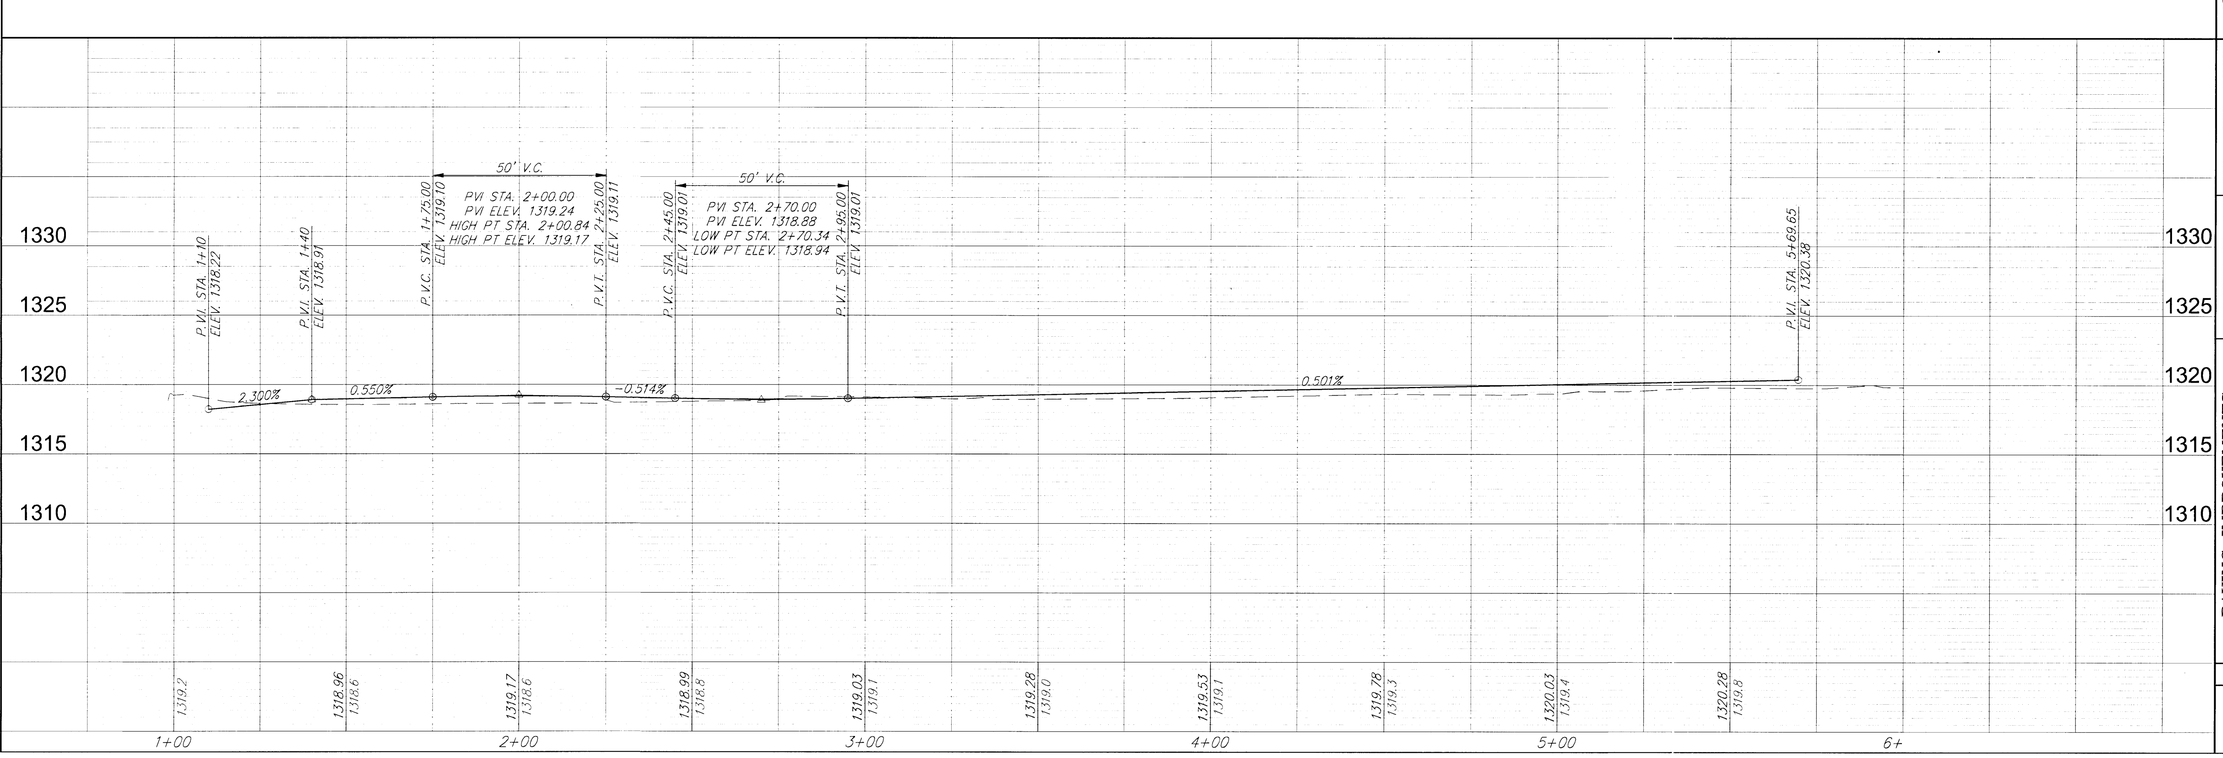

Ruggles & Bohm P.A.
Engineering, Surveying, Land Planning
105 North Main
Wichita, Kansas 67203
(316) 264-6300
FAX (316) 264-1589
E-mail: info@rbwichita.com
www.rbwichita.com

DESIGN	DRAWN	REVISED
LJS	EJG	
UTILITY	DATE	REVIEW
		June 4, 2010

PROJECT NUMBER 472-84901

DRAWING FILE ENGINEERING BASE [MASCOT-1]

PAVING IMPROVEMENTS
Mascot
WICHITA, KANSAS

RB JOB 3614T

SHEET 11 of 30