WALMART MARKET

STA. 18+60.56
PUBLIC W.L.
blow-off - V45182 ~~1-8" PLUG~~

N=1681926.26
E=1677364.44

LIMITS OF CITY RESPONSIBILITY

718.55' TO ℄ OF HARRY STREET

N=1681923.89
E=1677514.42

N=1681923.55
E=1677536.47

clow (storz) - H14197
V45181

STA. 17+10.56~PUBLIC W.L.
1-FIRE HYDRANT ASSEMBLY
L=~~1~~ 3
VB ELEV=1366.68
HYDRANT BURY=1366.59
(POSITION NOZZLE WEST)

S00°54'10"E
11.00' OF 8" W.L.

N=1681922.53
E=1677528.63

STA. 16+88.56~PUBLIC W.L.
1-8"x8"x8" TEE
2-8" G.V. & BOX
LW - V45178
LS - V45179

S00°54'10"E
11.00' OF 8" W.L.

STA. 16+99.56~PUBLIC W.L.
1-2" WATER METER SETTING & TAP BY WICHITA UTILITIES (WALMART CONTRACTOR TO REIMBURSE)

NOTE: THE GENERAL CONTRACTOR IS RESPONSIBLE FOR MAKING ALL ADJUSTMENTS OF EXISTING UTILITIES TO ALLOW THE DESIGN TO BE BUILT.

Sta. 12+00 Test Station

25' U/E

35' B/S

PROP. ELECTRIC
PROP. TELEPHONE
PROP. GAS LINE

S00°54'10"E
688.56 OF 8" W.L.

SITE BENCHMARK-1
"O" Chiseled on Top of Curb
Elevation=1354.80
(NAVD 88)

HARRY STREET

N=1681912.69
E=1678224.89

STA. 10+00.00~PUBLIC W.L.
CONNECT TO EXIST. 20" W.L.
1-20"x20"x8" TAPPING TEE
1-8" G.V. & BOX
FURNISHED & INSTALLED BY CITY OF WICHITA. CONTRACTOR TO REIMBURSE.

existing wl 8' from pavement to top of pipe 5' back of curb

R 2 E
HARRY STREET
PROJECT LOCATION
T 27 N
WEBB ROAD
GREENWICH ROAD
33
PAWNEE AVENUE
LOCATION MAP
NOT TO SCALE

SCALE: 1" = 40'

UTILITY STATEMENT:

THE CONTRACTOR IS SPECIFICALLY CAUTIONED THAT THE LOCATION AND/OR ELEVATION OF EXISTING UTILITIES AS SHOWN ON THESE PLANS IS BASED ON A COMBINATION OF FIELD SURVEY INFORMATION, EXISTING DRAWINGS AND RECORDS OF THE VARIOUS UTILITY COMPANIES. THE ENGINEER MAKES NO GUARANTEE THAT THE UNDERGROUND UTILITIES SHOWN COMPRISE ALL SUCH UTILITIES IN THE AREA, EITHER IN SERVICE OR ABANDONED. THE ENGINEER FURTHER DOES NOT WARRANT THAT THE UNDERGROUND UTILITIES SHOWN ARE IN THE EXACT LOCATION INDICATED ALTHOUGH HE DOES CERTIFY THAT THEY ARE LOCATED AS ACCURATELY AS POSSIBLE FROM INFORMATION AVAILABLE. THE ENGINEER HAS NOT PHYSICALLY LOCATED THE UNDERGROUND UTILITIES. THE CONTRACTOR MUST CALL THE APPROPRIATE UTILITY COMPANY AT LEAST 48 HOURS BEFORE ANY EXCAVATION TO REQUEST EXACT FIELD LOCATION OF UTILITIES. IT SHALL BE THE RESPONSIBILITY OF THE CONTRACTOR TO RELOCATE ALL EXISTING UTILITIES WHICH CONFLICT WITH THE PROPOSED IMPROVEMENTS SHOWN ON THE PLANS.

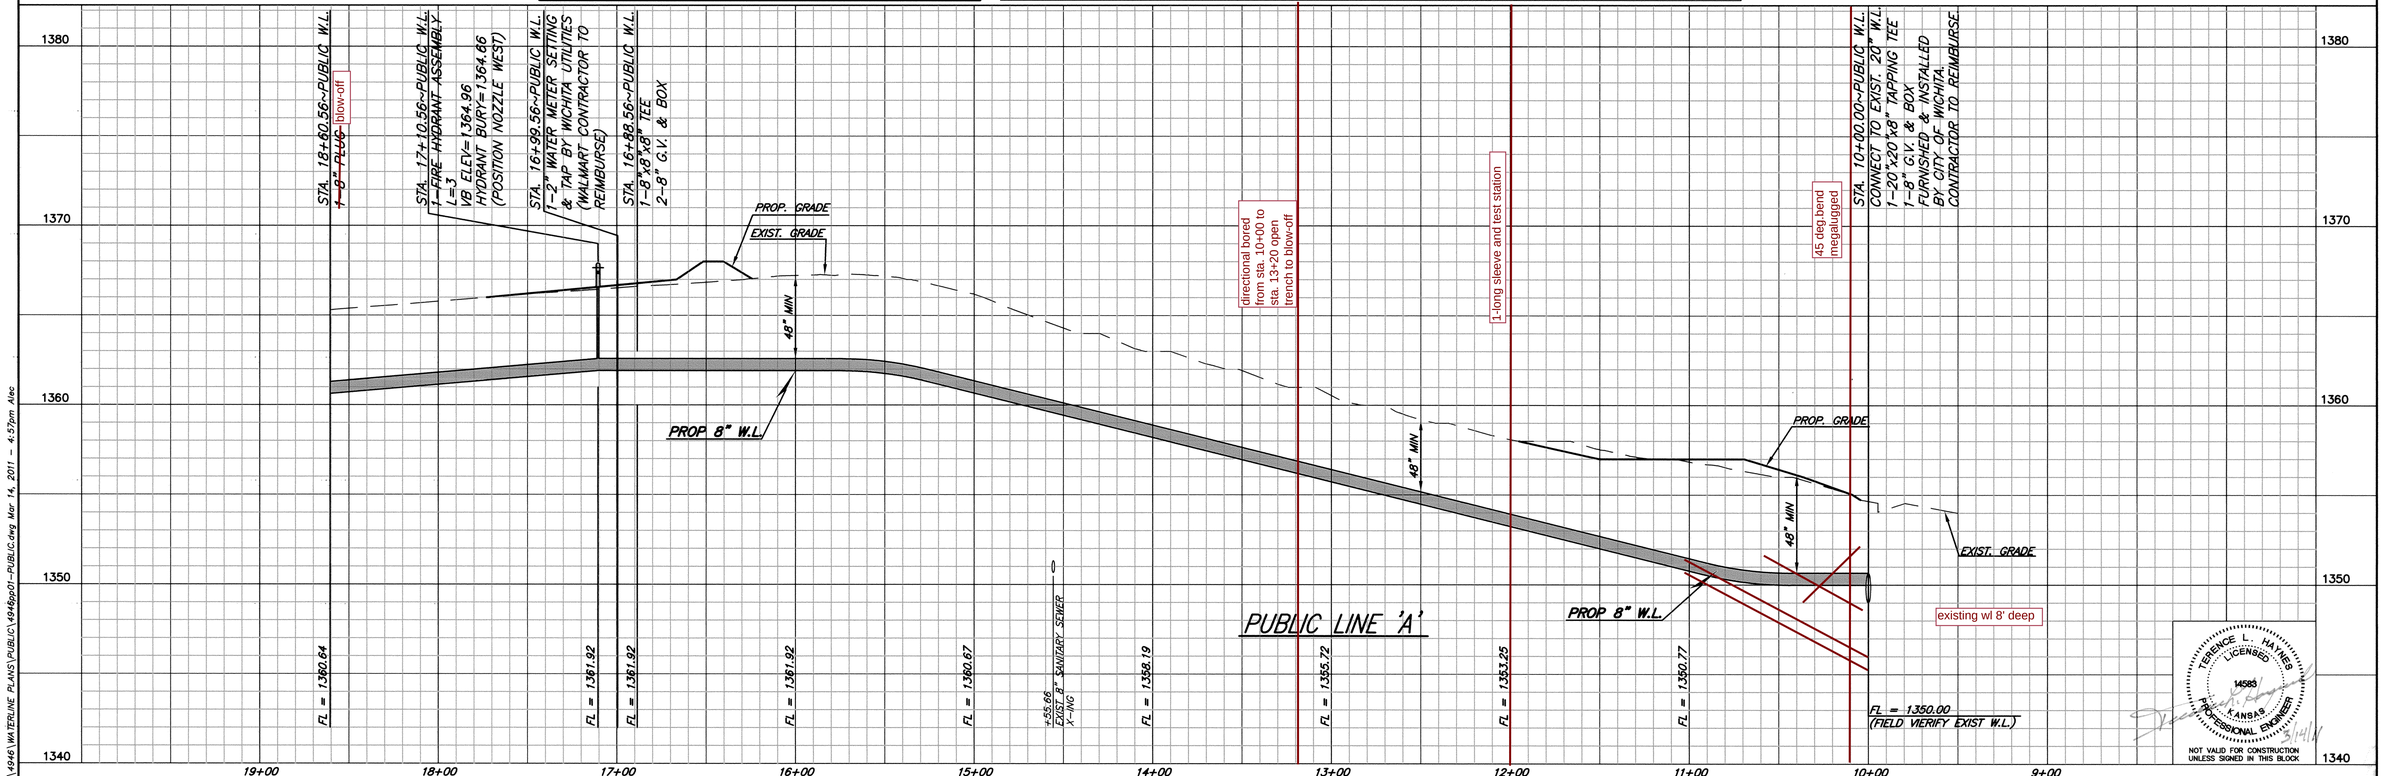

TERENCE L. HAYNES
LICENSED
14583
KANSAS
PROFESSIONAL ENGINEER
NOT VALID FOR CONSTRUCTION UNLESS SIGNED IN THIS BLOCK

G:\4946\WATERLINE PLANS\PUBLIC\4946pp01-PUBLIC.dwg Mar 14, 2011 - 4:37pm Alec

SMC Consulting Engineers, P.C.	815 WEST MAIN, OKLAHOMA CITY, OK 73106 PHONE: 405-232-7715 FAX: 405-232-7859	SMC, P.C. KANSAS CERTIFICATE OF AUTHORIZATION NO. E-335 EXP. DEC. 31, 2011	MARKET STORE #5860-00, WICHITA, KANSAS	PUBLIC WATER LINE PLAN & PROFILE LINE 'A'	NO/DATE/BY	3 01/31/11 KST	4 03/07/11 TAB	5 03/14/11 TAB	SCALE	HORIZ. SCALE: 40' VERT. SCALE: 4'	DATE: 10/04/10	SHEET NO. C-12.3
					REVISION	WM OTB	Revised Per City's Comments	Revised Per City's Comments				