




Line 1

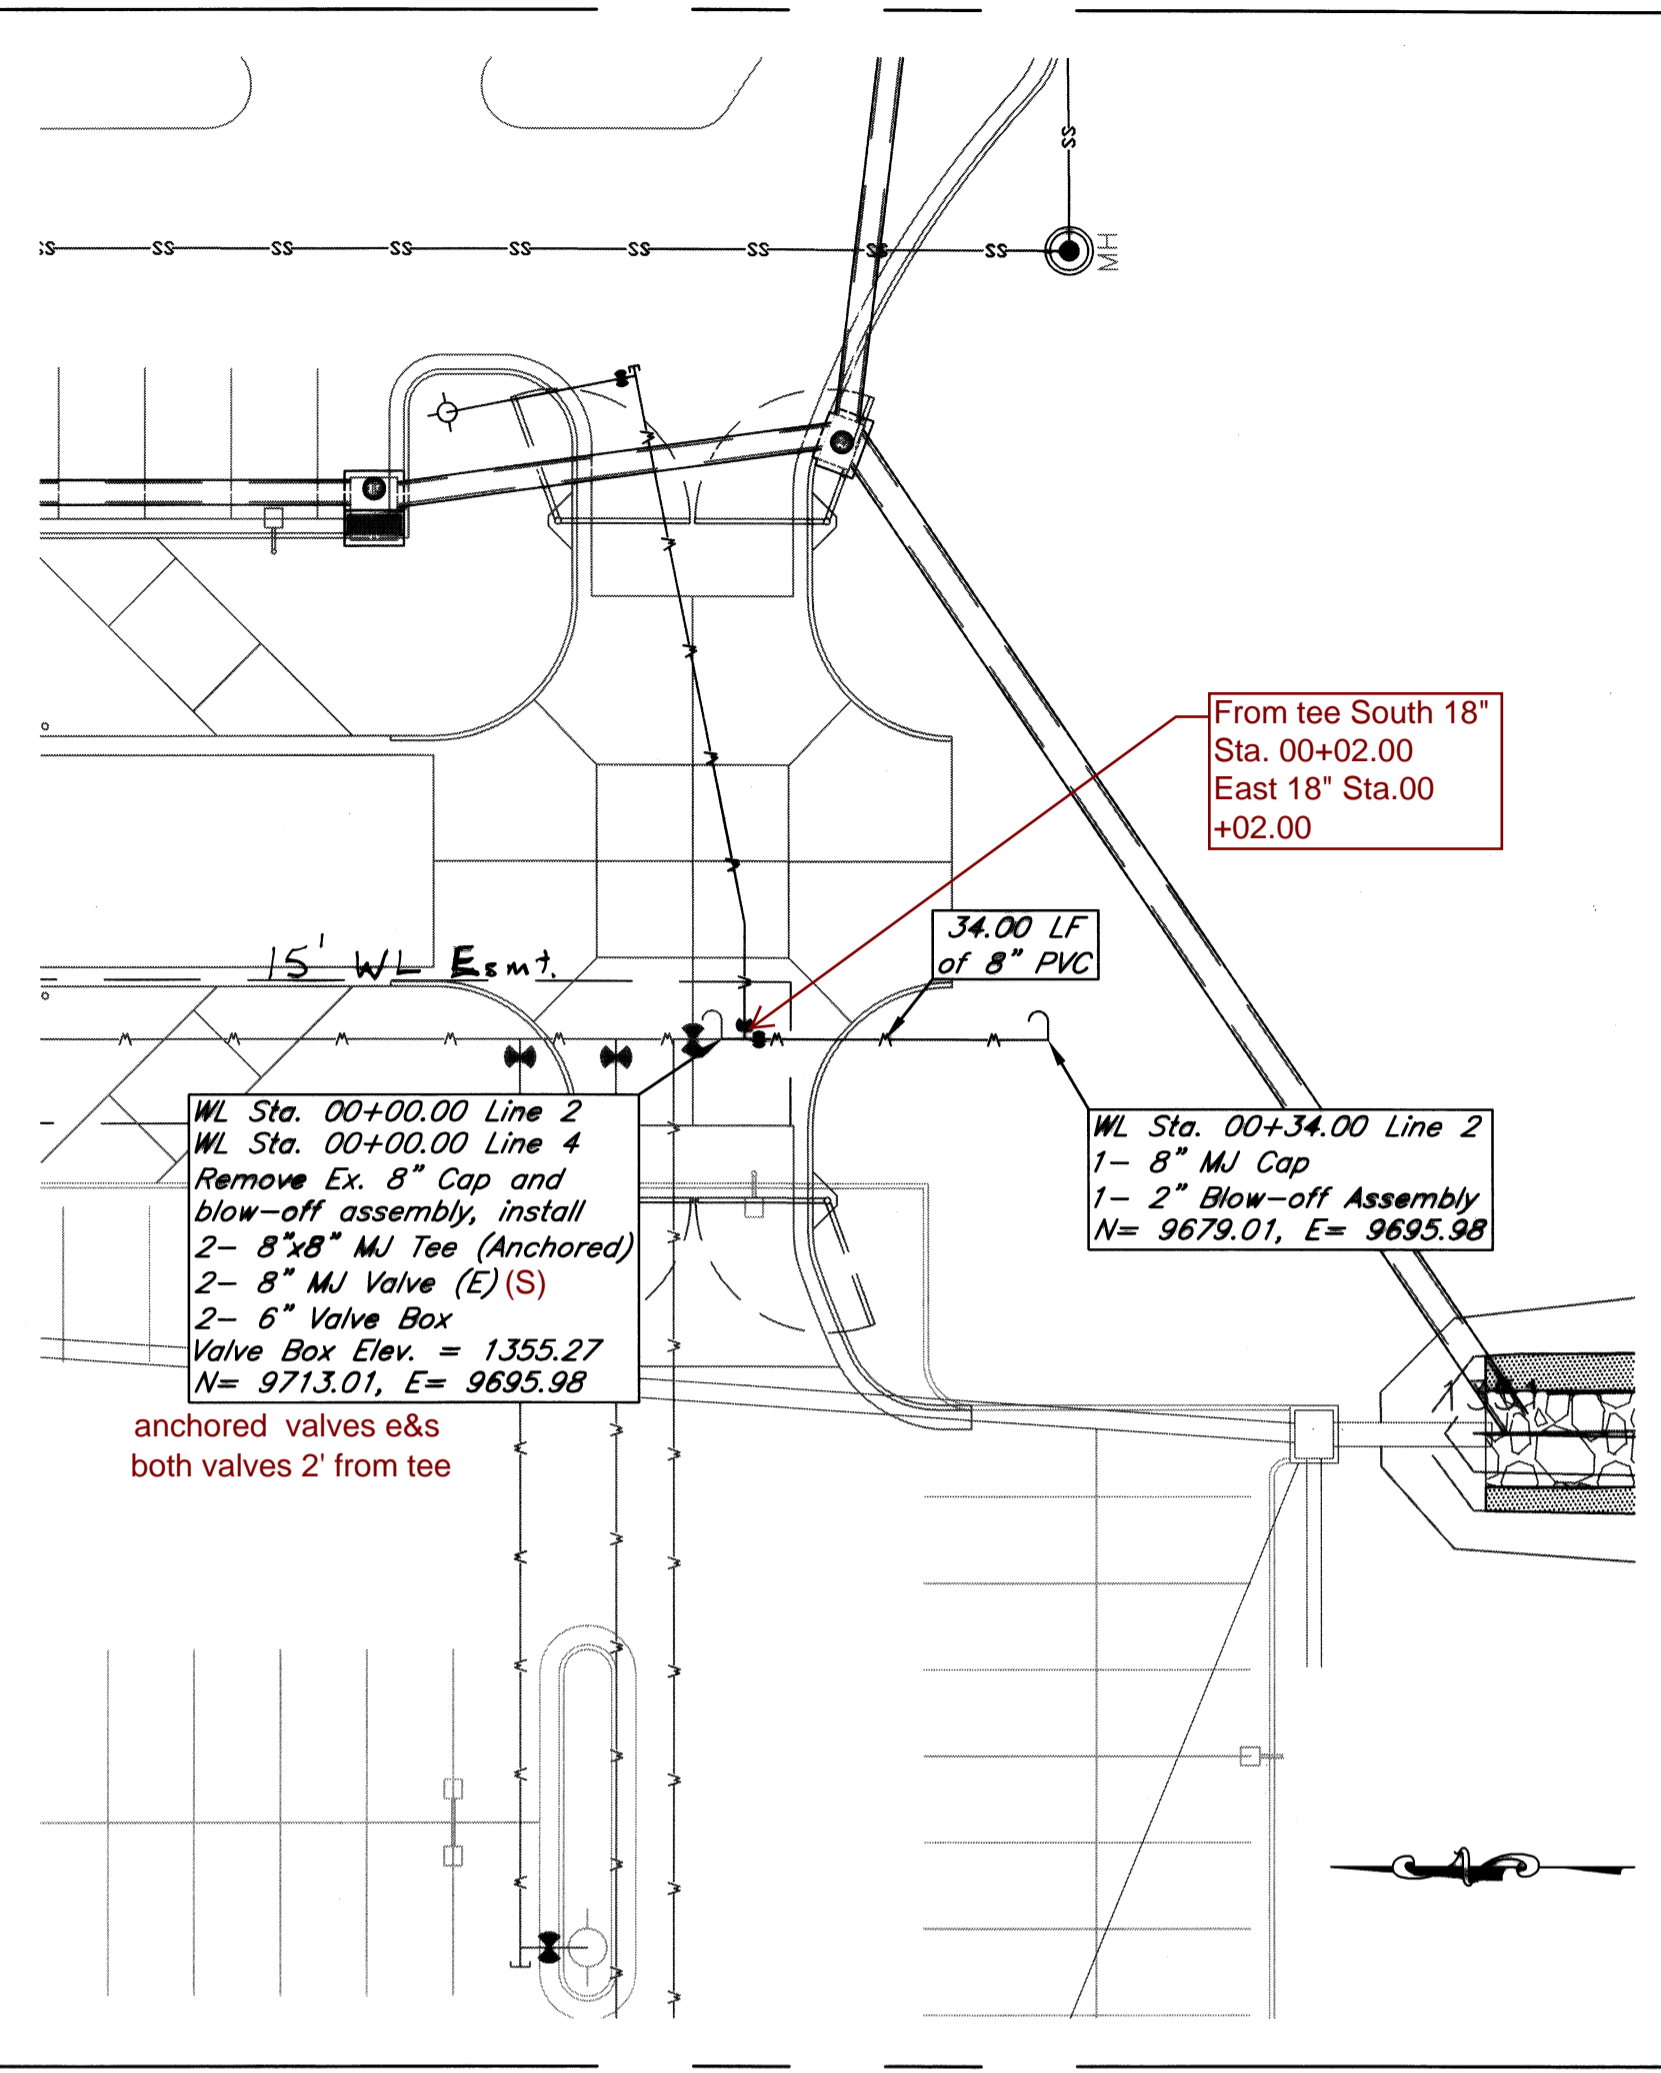

Line 2

Notes:

- Pipe Backfill / Bedding**  
 1. All pipe back fill and pipe bedding to meet City of Wichita specifications, unless otherwise stated by engineer.
- Water & Sanitary Sewer Crossings**  
 1. A minimum of 2.0 feet of vertical separation shall be kept between pipes and all water and sanitary sewer line crossings.

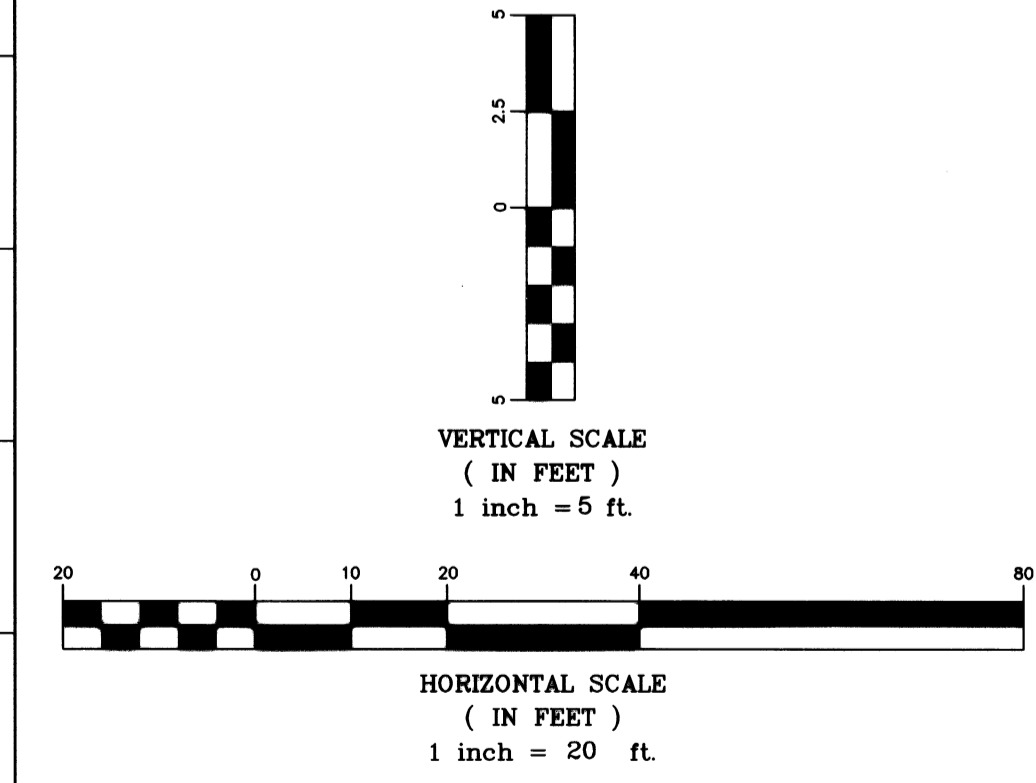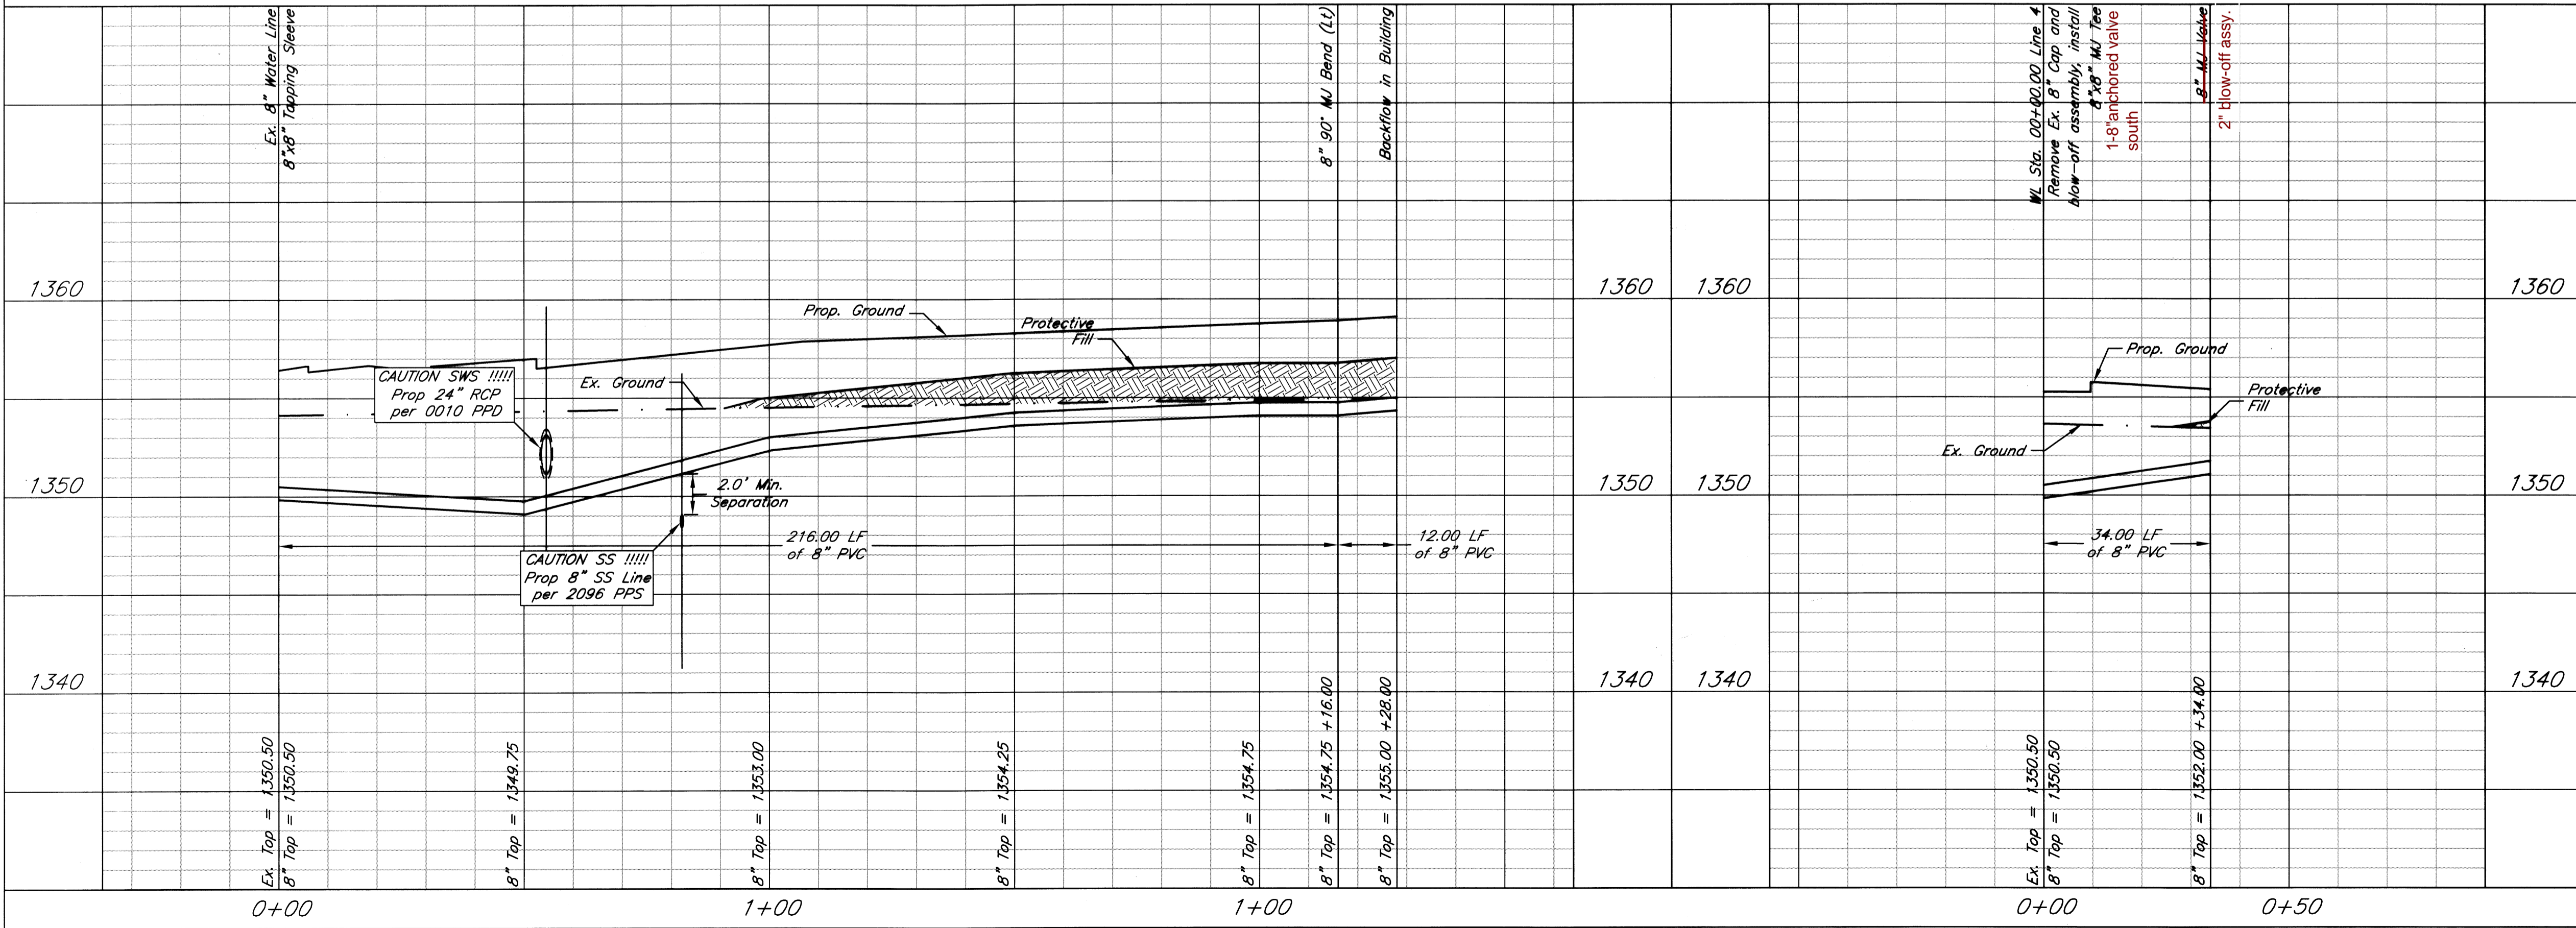

Water Lines 1 & 2

PROJECT NUMBER		
KEM NO. 10152	FILE	DATE 02/17/2011
DESIGN KM	DRAWN NS	REVISED

