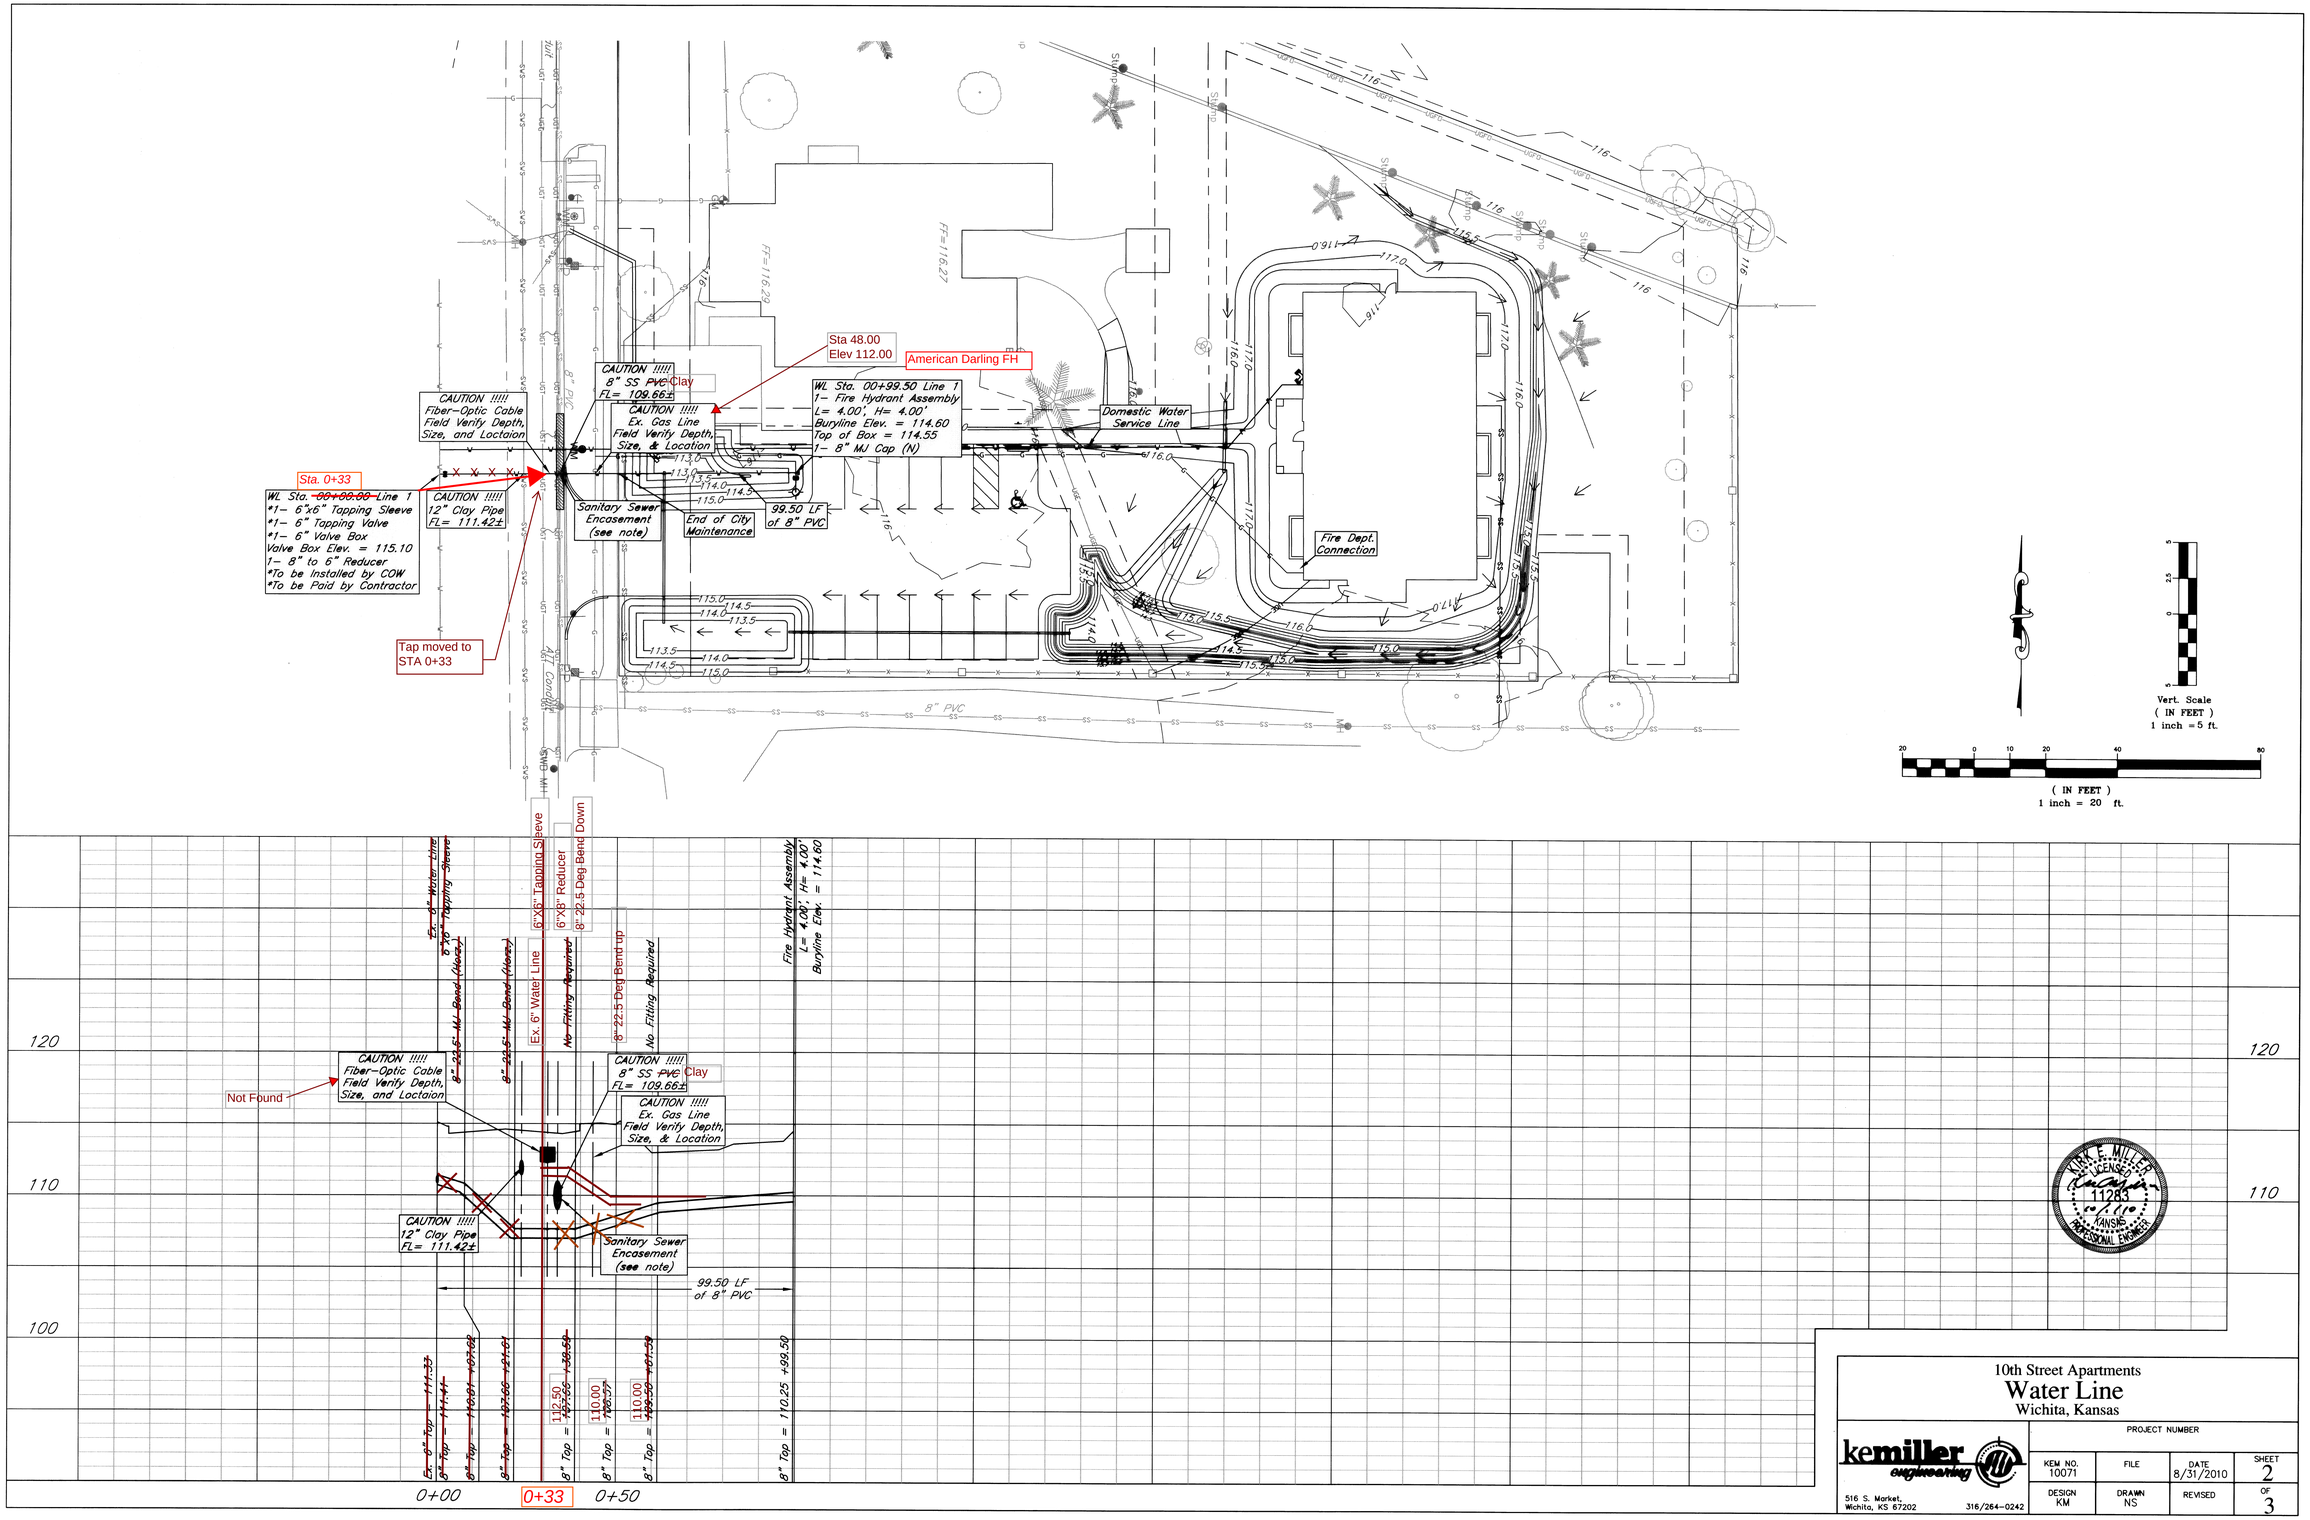

10th Street Apartments

Water Line

Wichita, Kansas

kemiller engineering

516 S. Market,
Wichita, KS 67202
316/264-0242

PROJECT NUMBER			
KEM NO. 10071	FILE	DATE 8/31/2010	SHEET 2
DESIGN KM	DRAWN NS	REVISED	OF 3

KIRK E. MILLER
LICENSED
11283
KANSAS
PROFESSIONAL ENGINEER