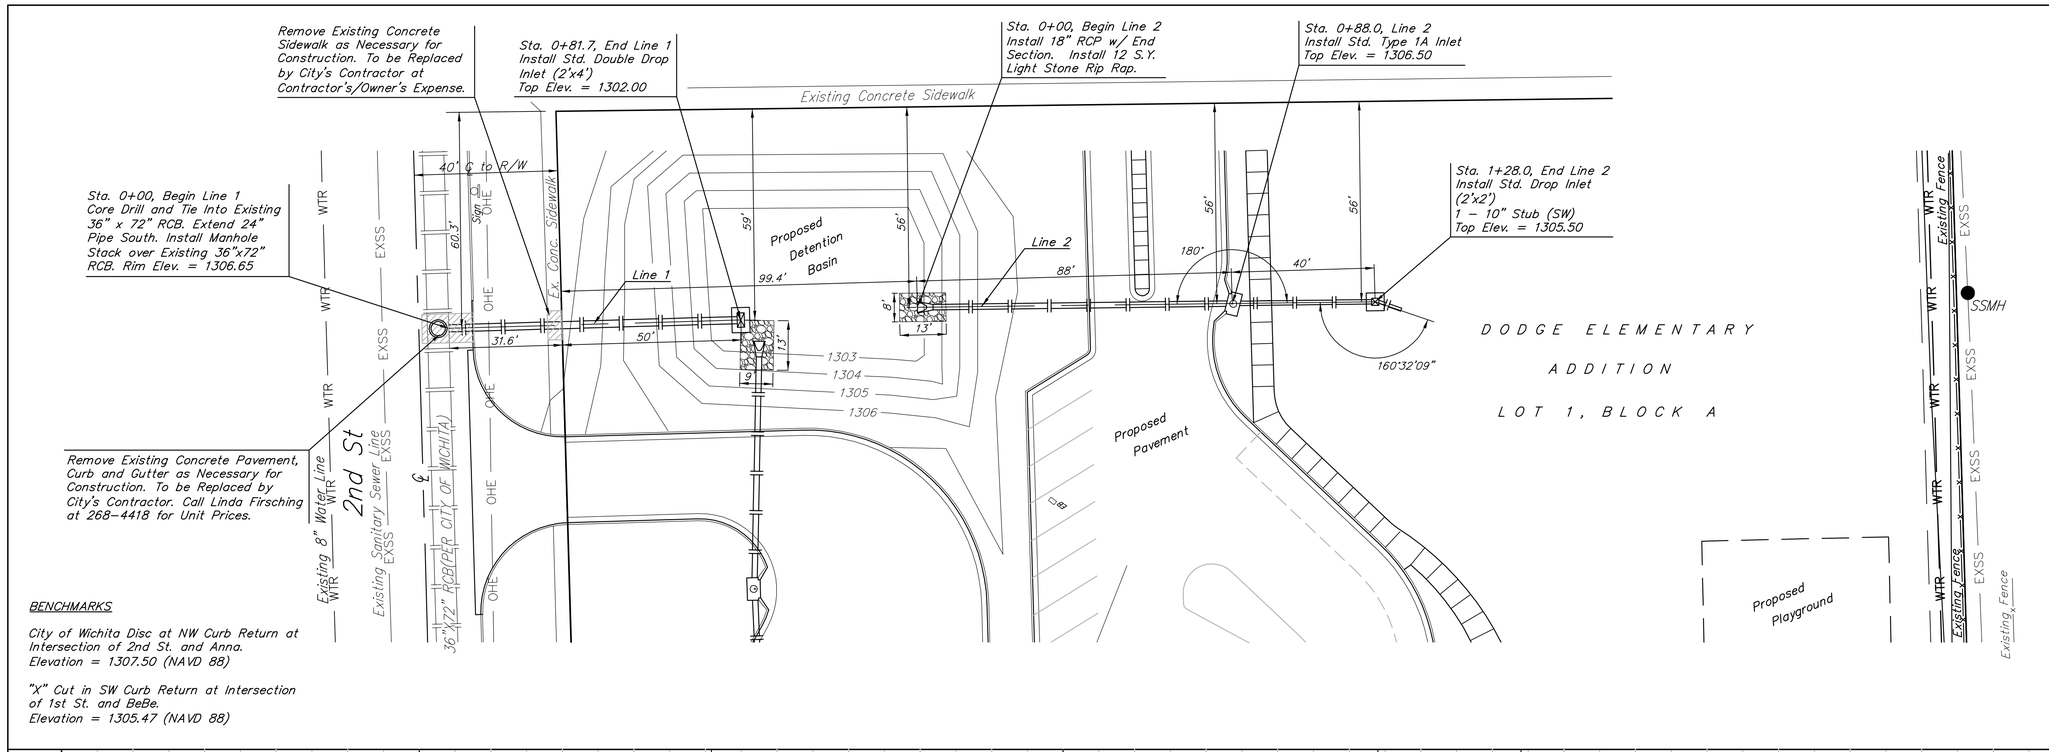

SCALE:
1" = 20' HORIZONTAL
1" = 5' VERTICAL

AS BUILTS
kemiller engineering
516 S. Market, Wichita, KS 67202 (316)264-0242

Contractor Shall Follow All Applicable Best Management Practices (BMP) For Erosion Control.

Contractor To Use Extreme Caution When Excavating Near Utility Lines. Contractor To Hand Dig To Expose All Utility Lines Prior To Construction. Verify Depth To Determine Conflict If Any.

BENCHMARKS

City of Wichita Disc at NW Curb Return at Intersection of 2nd St. and Anna. Elevation = 1307.50 (NAVD 88)

"X" Cut in SW Curb Return at Intersection of 1st St. and BeBe. Elevation = 1305.47 (NAVD 88)

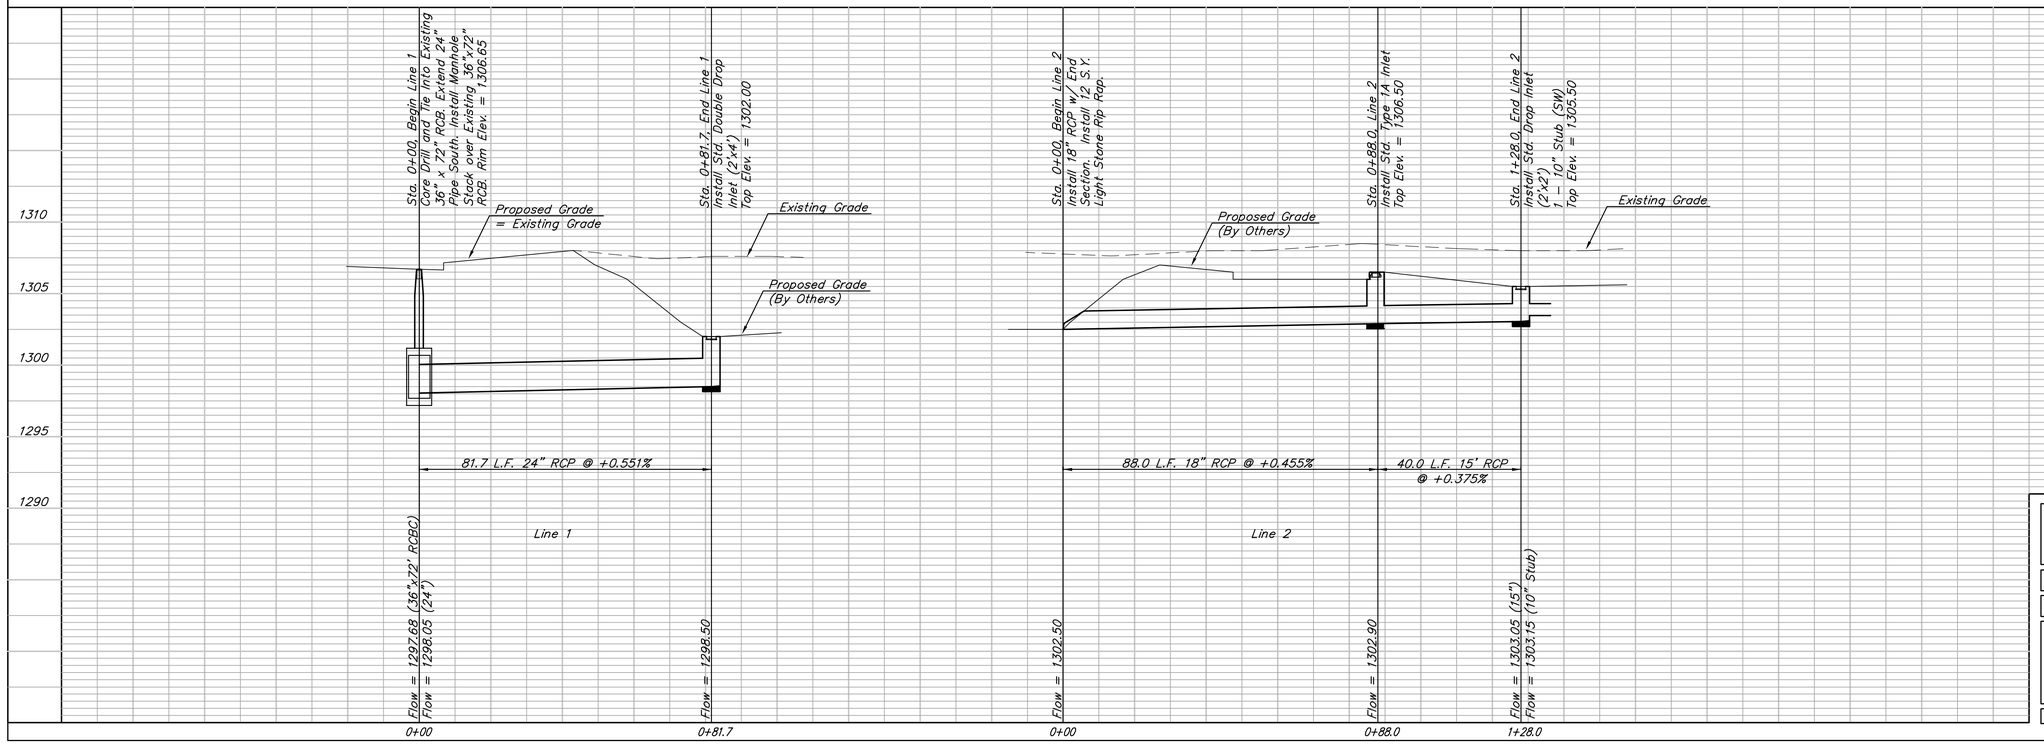

Baughman

DODGE ELEMENTARY SCHOOL
LINES 1 & 2
STORM WATER SEWER

Baughman Company, P.A. 315 Ellis St. Wichita, KS 67211 P 316-262-7271 F 316-262-0149
ENGINEERING | SURVEYING | PLANNING | LANDSCAPE ARCHITECTURE

PROJECT NUMBER 2035 PPS (607861)	DESIGN DMV / DRAWN DMV
REVISIONS:	APPROVED / DATE 1/25/10
	SCALE NOTED
	SHEET 2 OF 5