



LINE 1

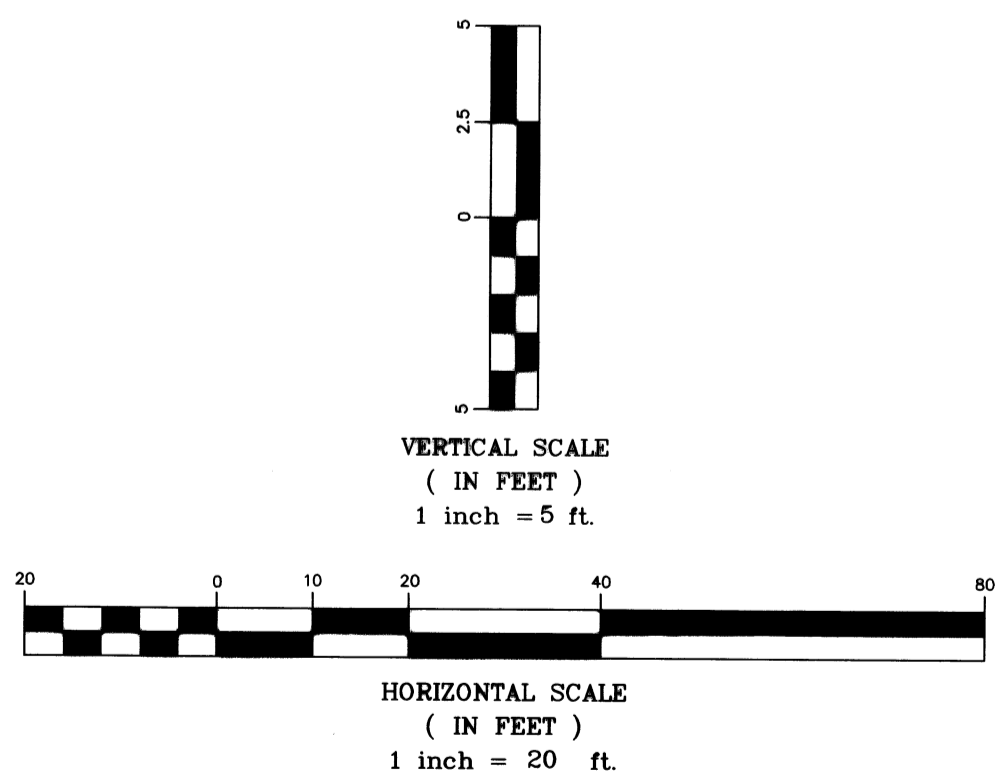

TOP - North Central
Line 1
Wichita, Kansas

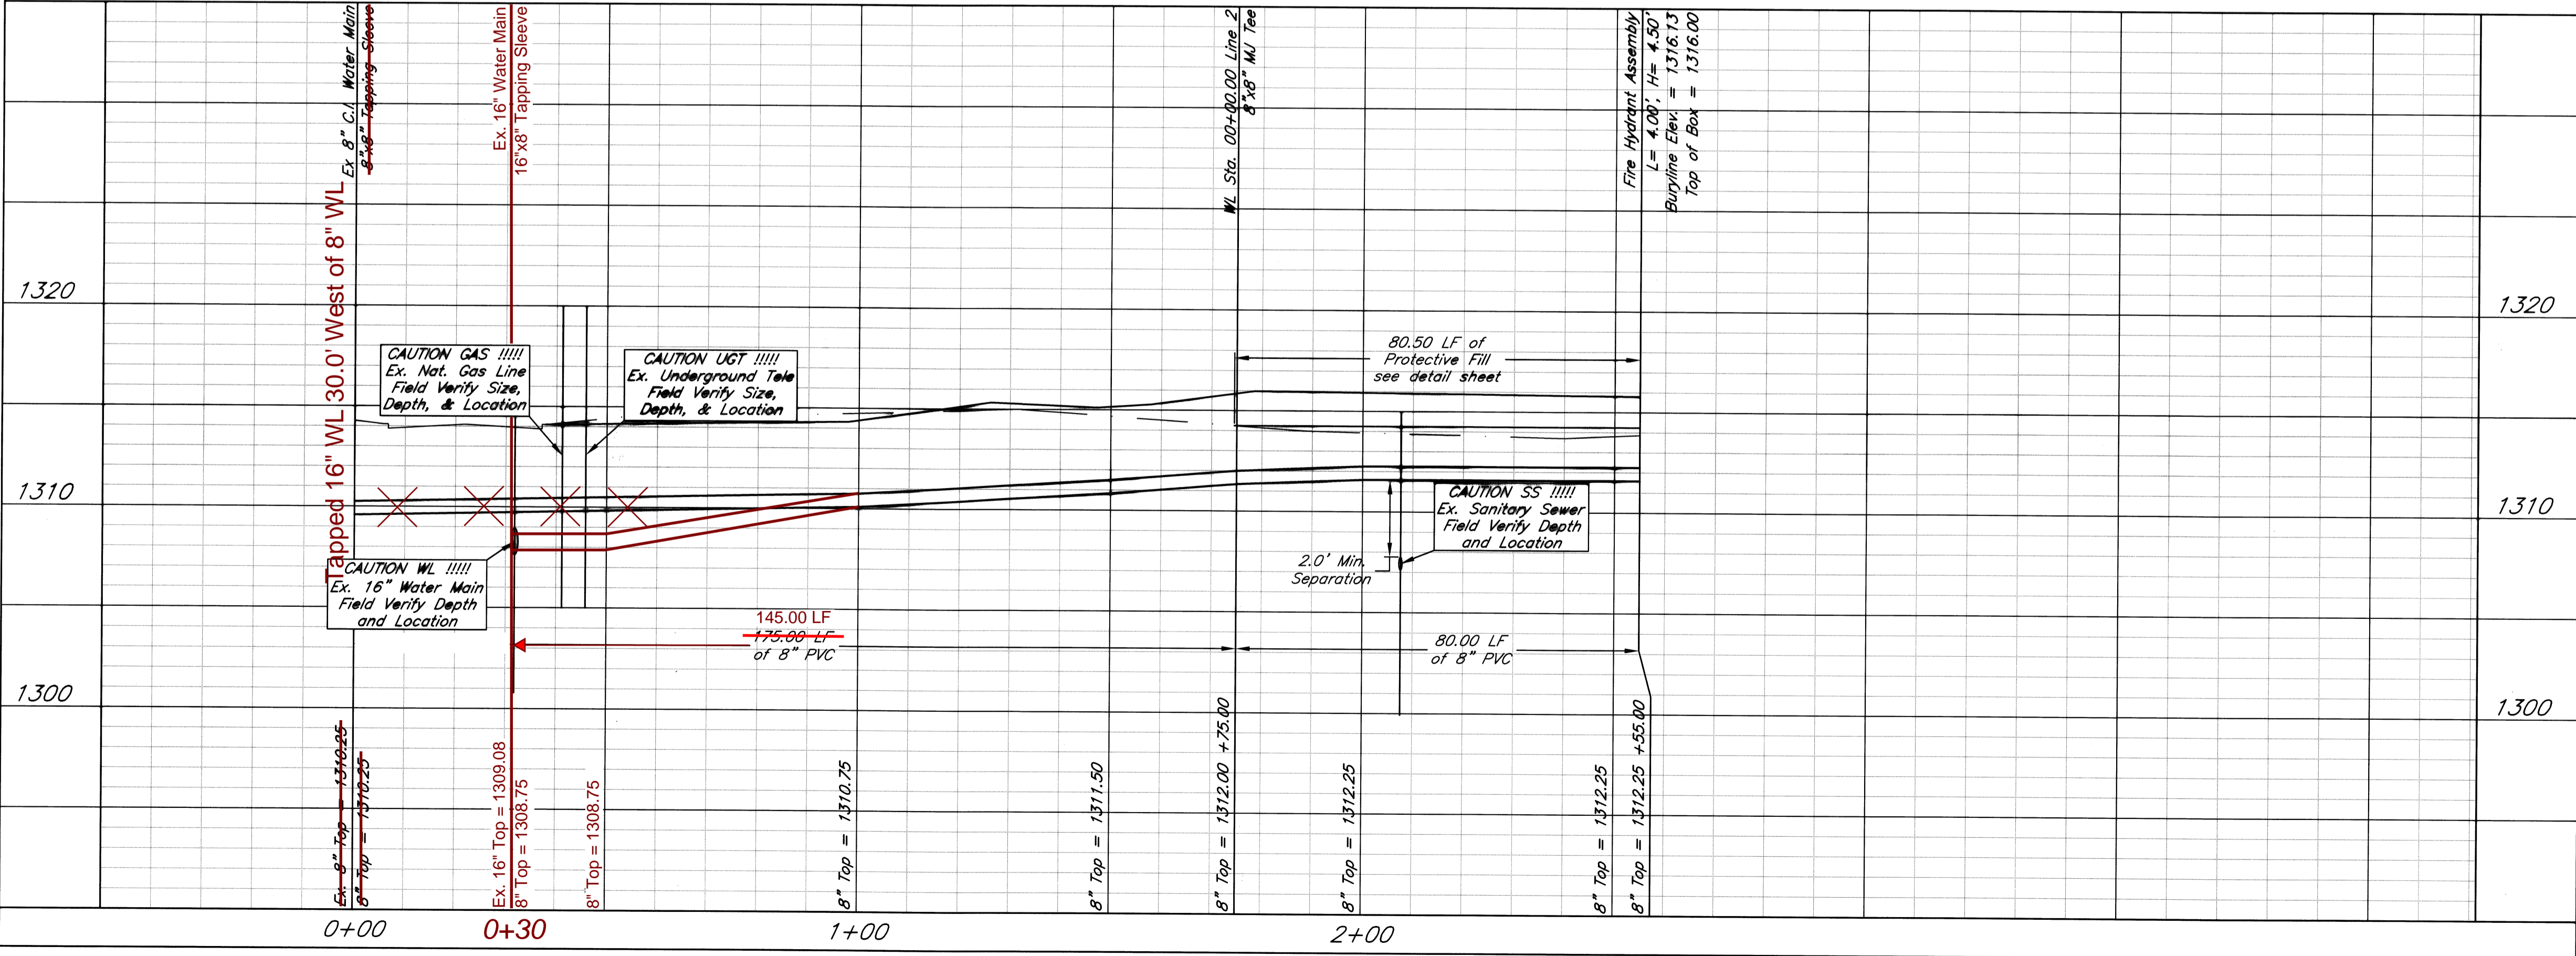

PROJECT NUMBER 1577 PPW (607853)			
KEM NO. 10147	FILE	DATE 02/03/2011	SHEET
DESIGN KM	DRAWN NS	REVISED 04/05/2011	2.0