


No.	Date	By	Approved	Revision
1	08/19/2010	SS	TA	The CL grade was revised from 10+00 to 20+45.12. Top of Inlet @ Sta. 10+50 LT. from 1415.89 to 1416.78.
2	07/07/2010	SS	TA	26+25.77' Added 26' Drive @ Sta. 21+44.75.
3	05/20/2010	SS	TA	Revised subgrade to 6\"-remove base under curb-added 2\" thickness to curb.

MEDITERRANEAN PLAZA ADDITION  
 PRIVATE STREET IMPROVEMENTS  
 TOBEN 10+00-15+36.31  
**CITY OF WICHITA, KANSAS**  
 JAMES L. ARMOUR, P.E. - CITY ENGINEER  
 PROJECT NO. 205PPP OCA NO. (607879)

POE & ASSOCIATES, INC.  
 CONSULTING ENGINEERS  
 5940 E. Central, Suite 200 - Wichita, KS  
 67208-4242  
 Phone 316/685-4114 | FAX 316/685-4444

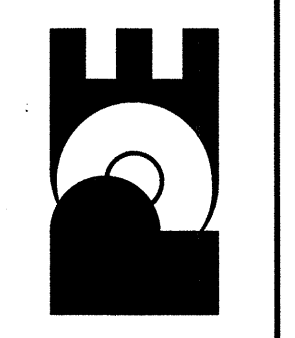

**FINAL**  
 Engineer: T. AUSTIN  
 Designer: S. SCHMIDT  
 Poe Job No.: 1949-00156  
 Date: APRIL 2010  
 Sheet 3 of 32