
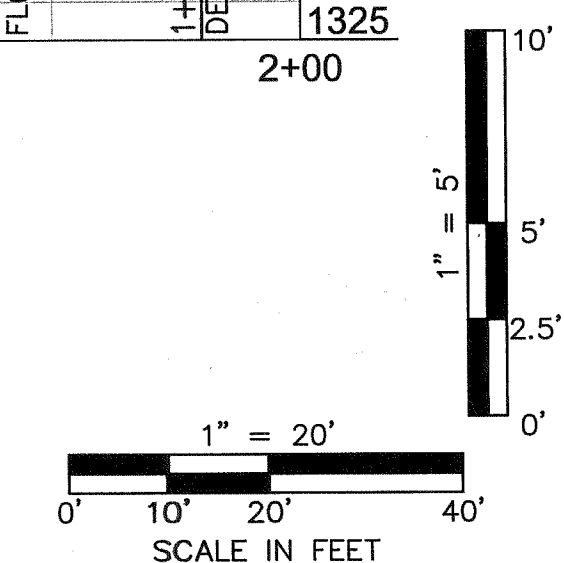
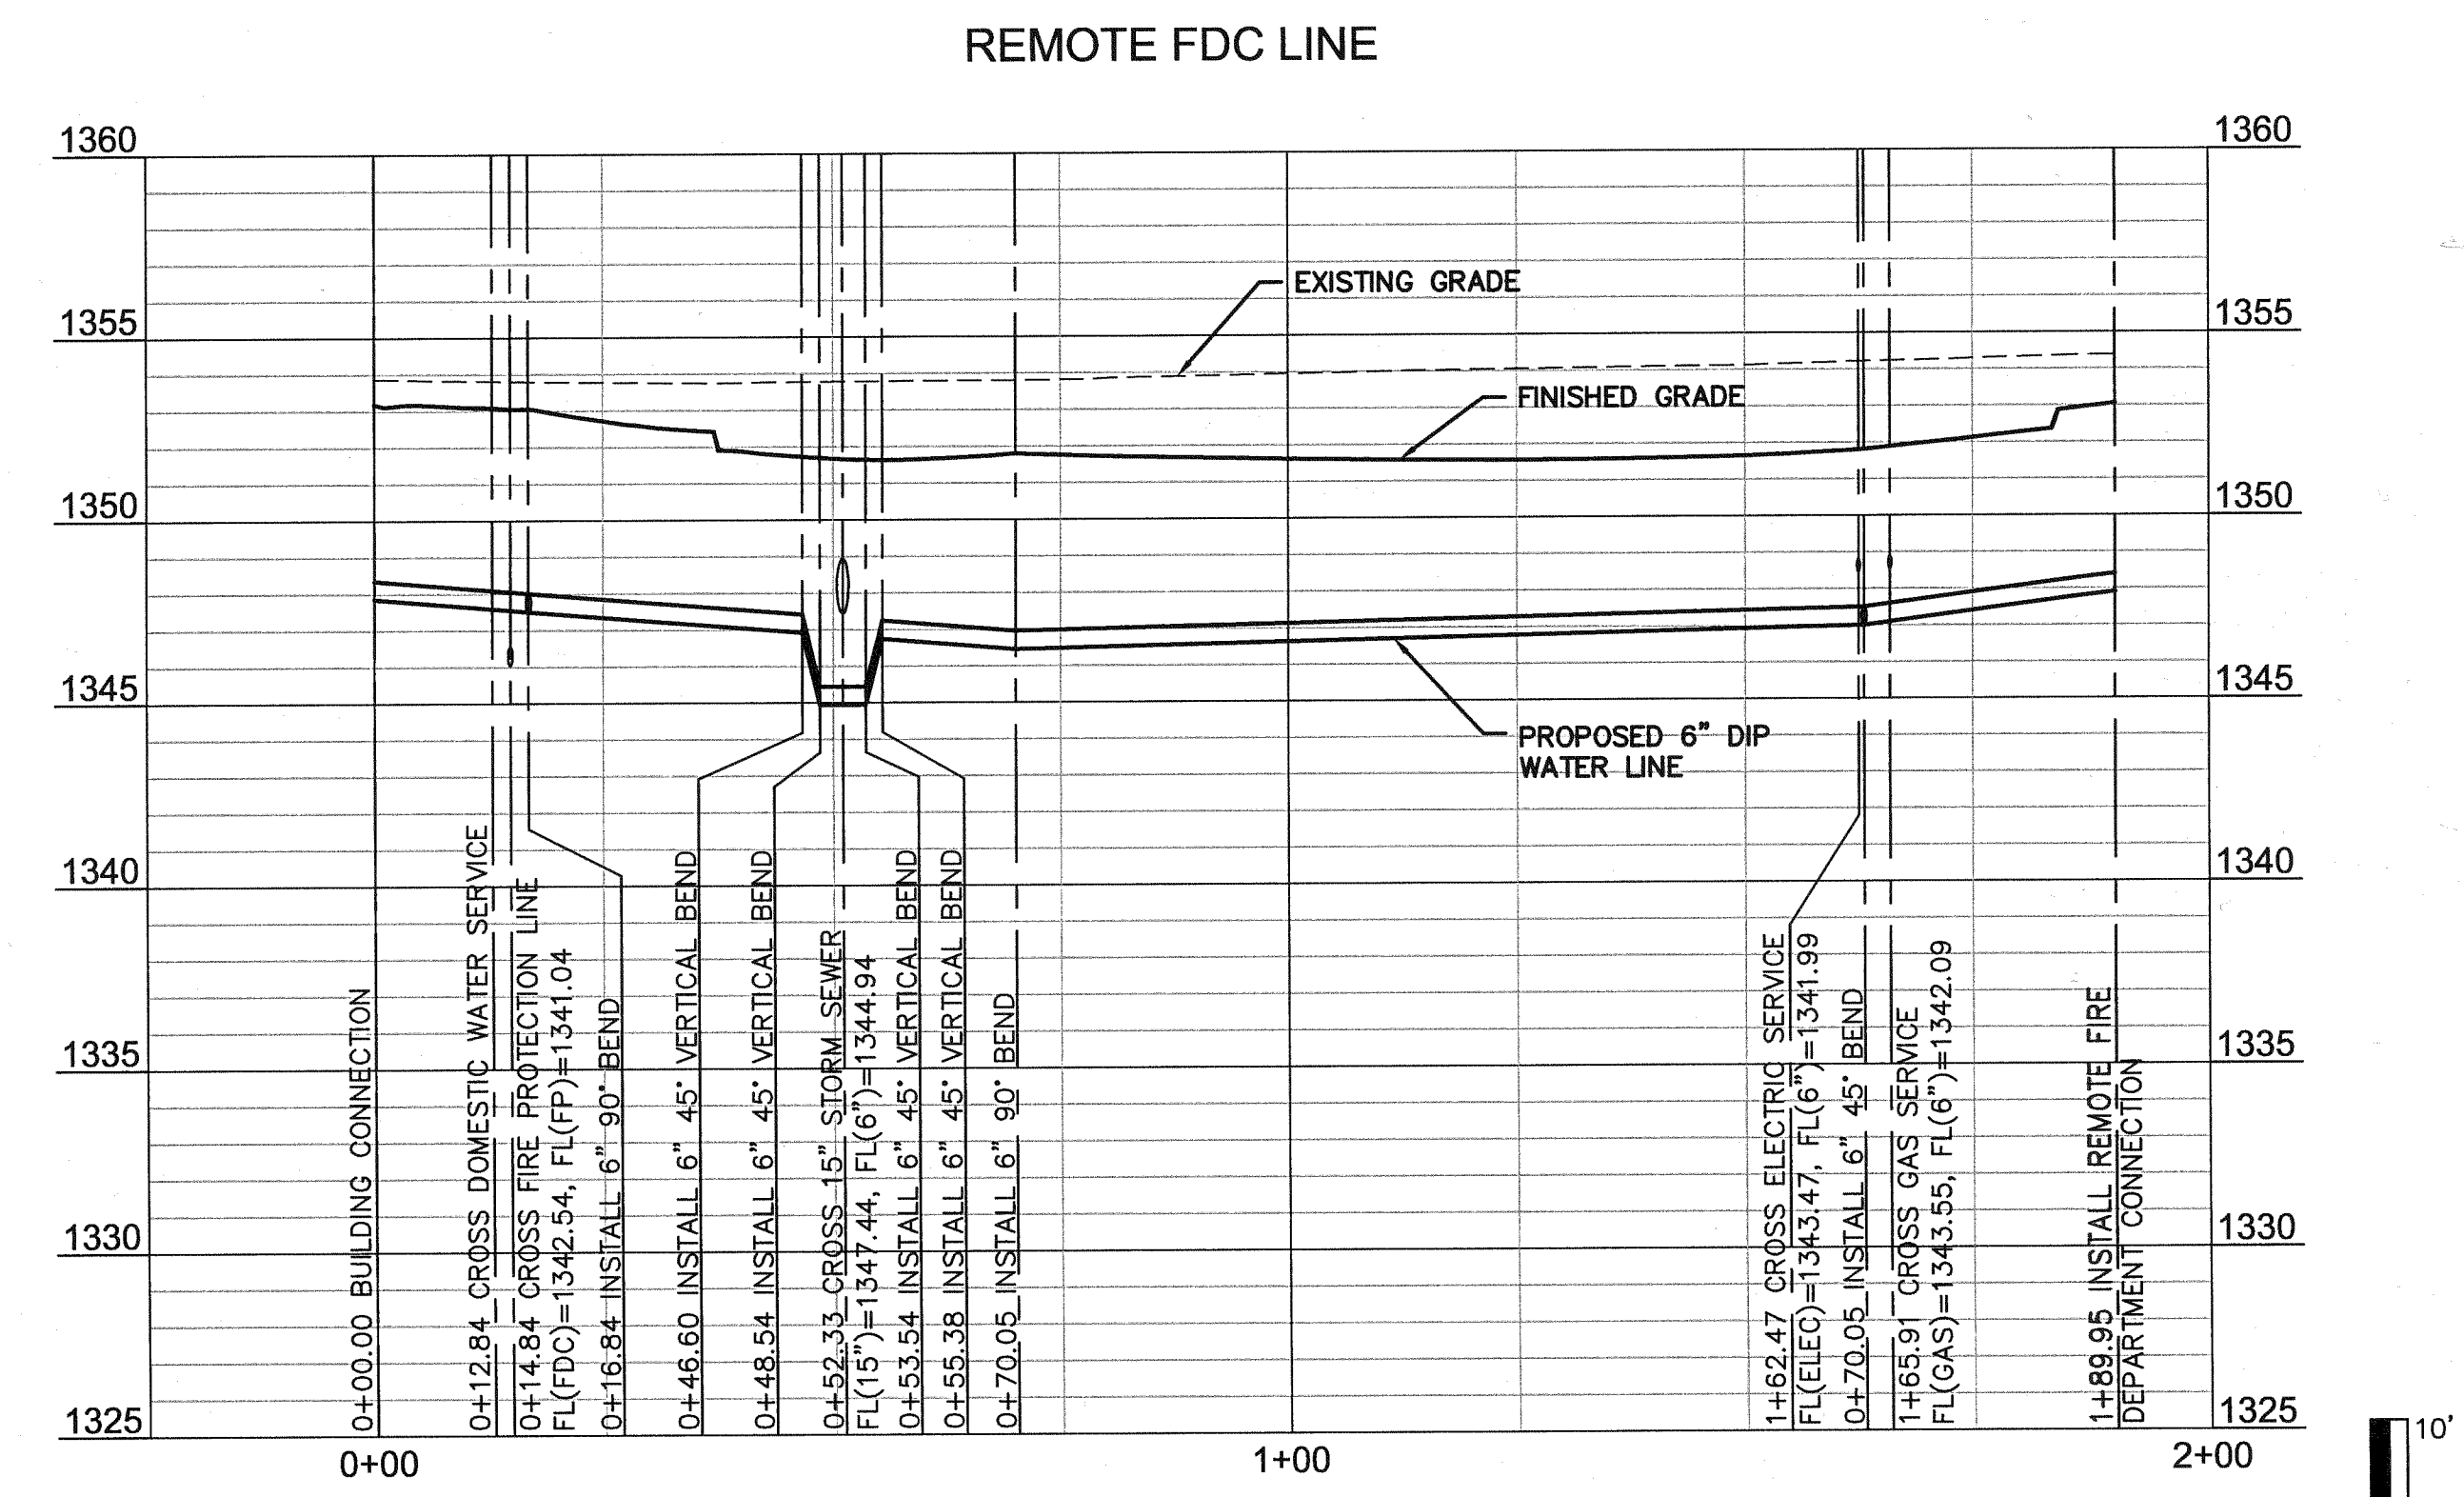
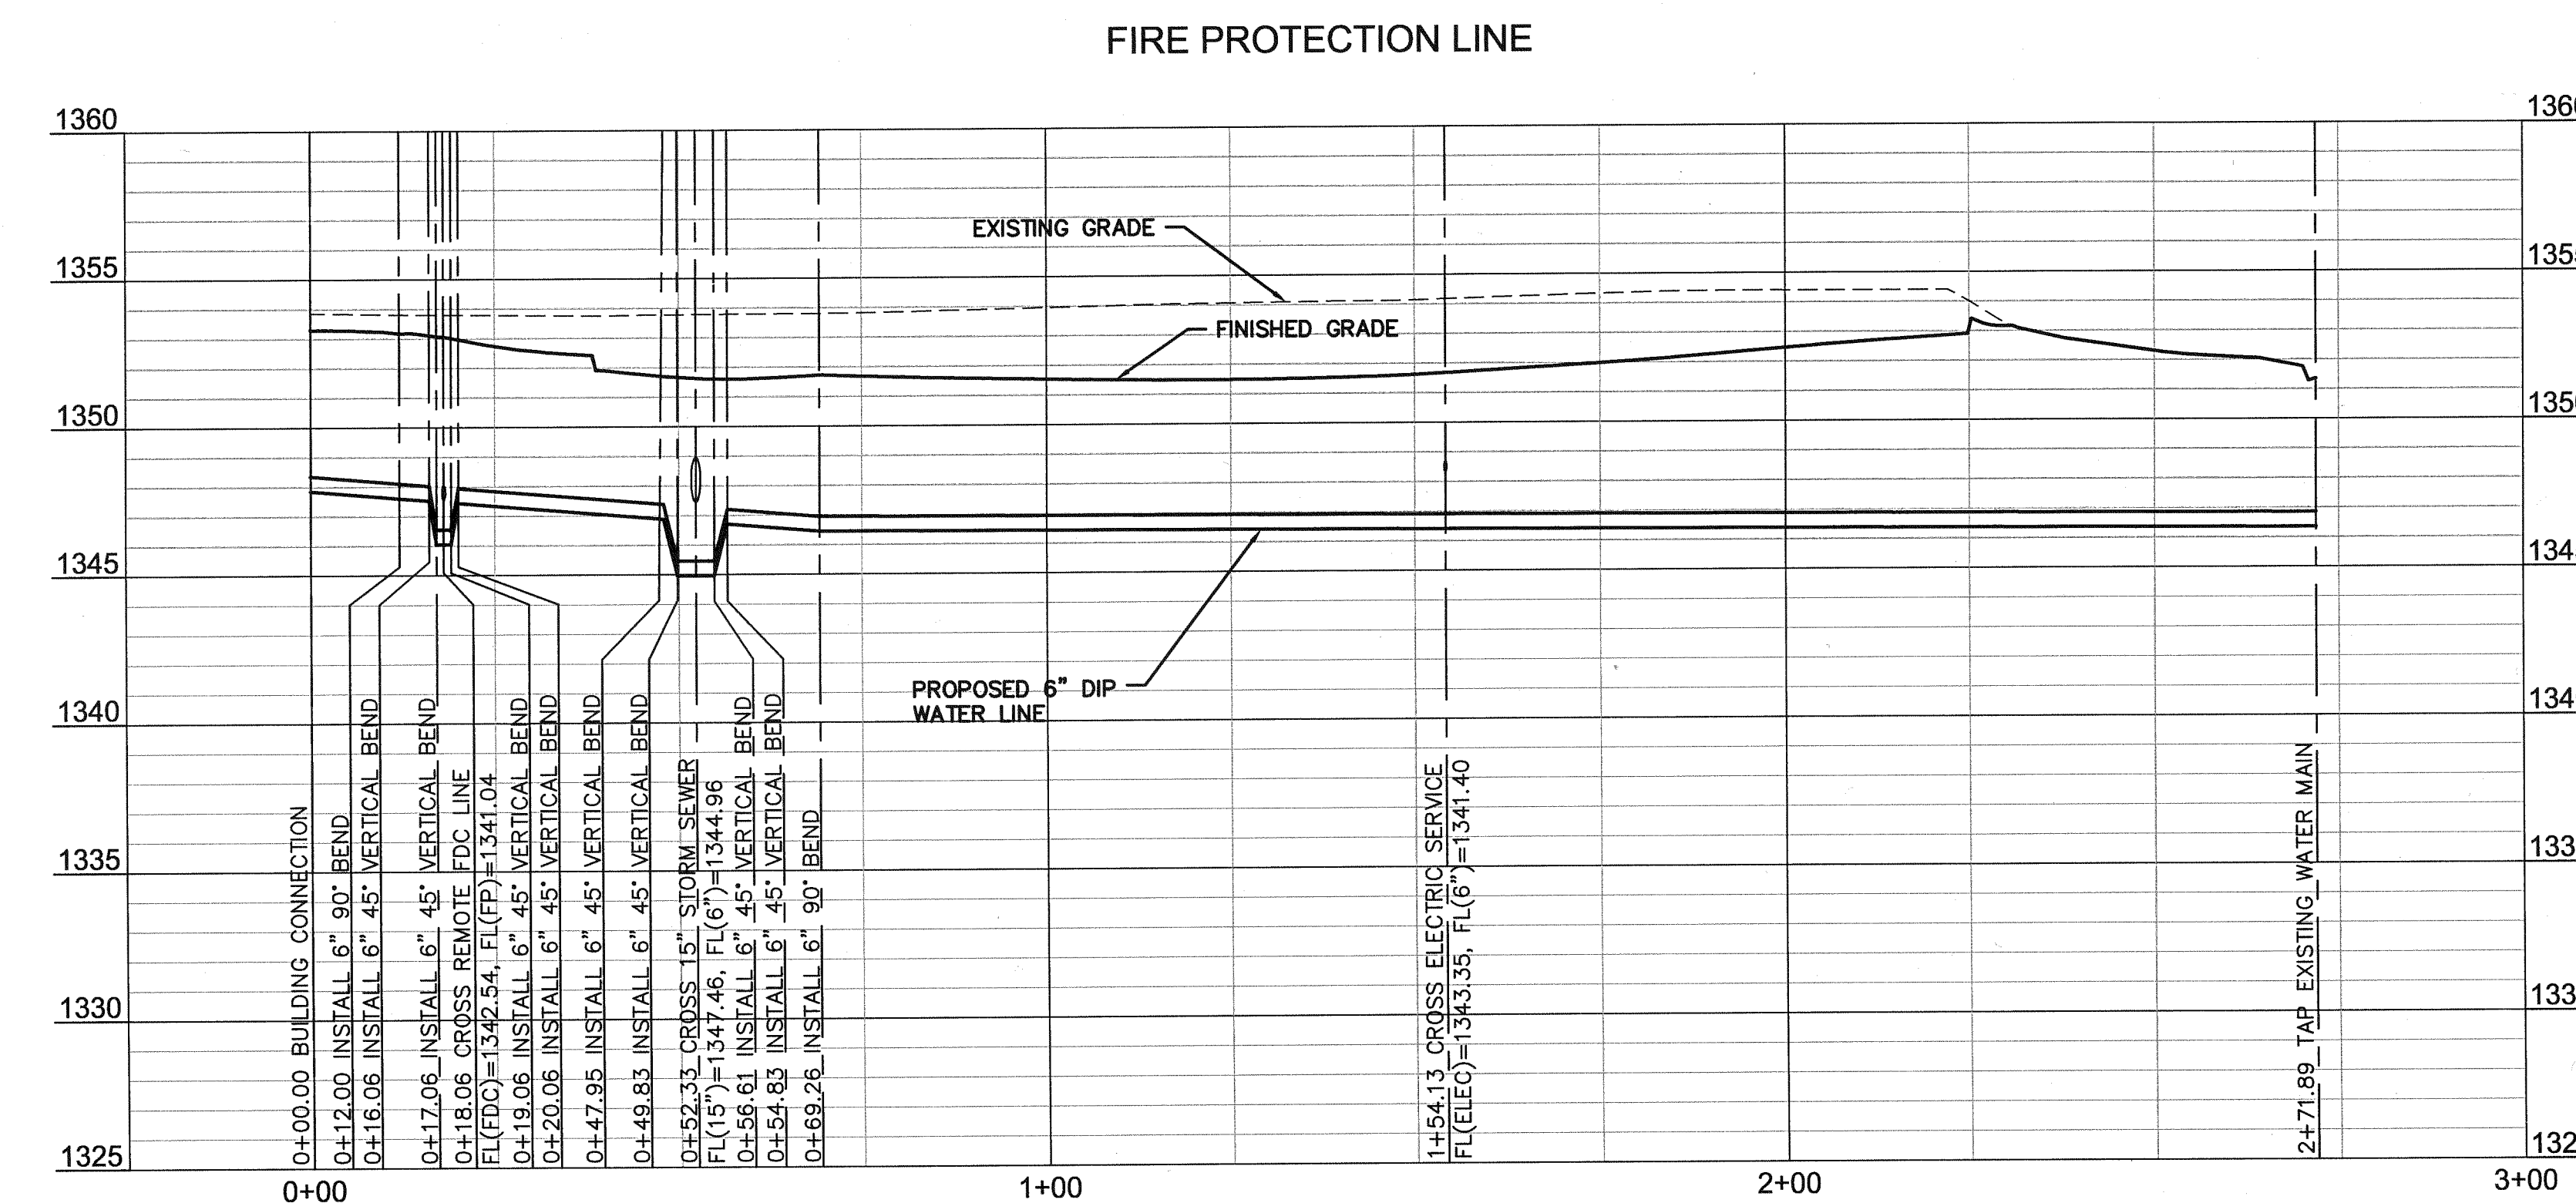


NOTES

1. THE CONTRACTOR IS TO PAY THE CITY OF WICHITA ALL TAP FEES BEFORE THE TAP IS MADE.
2. THE CONTRACTOR IS TO PAY THE CITY OF WICHITA ALL METER SET FEES BEFORE WATER METER IS INSTALLED. AFTER FEES FOR WATER METER ARE PAID, THE CITY OF WICHITA HAS TWENTY-ONE (21) CALENDAR DAYS (EXCLUDING HOLIDAYS) TO INSTALL METER.
3. WATER METER CANNOT BE INSTALLED IN THE BUILDING.
4. THE CONTRACTOR DOES NOT INSTALL THE METER PIT. THE CITY OF WICHITA WILL INSTALL THE METER BOX WITH THE METER.

— REVISED ROUTE FOR FPL LINE & FDC LINE.

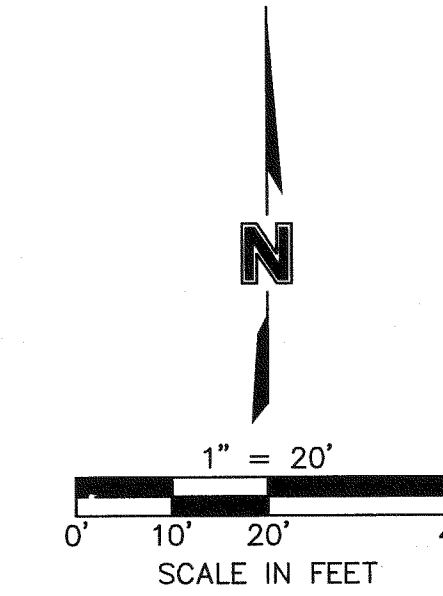

VAULT HAS BEEN DELETED DUE TO THE BACKFLOW PREVENTER BEING INSTALLED INSIDE THE BUILDING.

EXISTING 16" WATER MAIN
TAP EXISTING 16" WATER MAIN FOR SERVICES. TAP TO BE PERFORMED BY CITY OF WICHITA. COORDINATE WORK WITH CITY.

DOMESTIC WATER METER
2" DOMESTIC WATER SERVICE
INSTALL BACKFLOW PREVENTION IN VAULT PER CITY REQUIREMENTS

PROPERTY LINE (END OF CITY OF WICHITA MAINTENANCE)

MAIZE ROAD

PROPOSED BUILDING
FFE=1353.30

PRIVATE DRIVE

