


REVISED
 Added Ex. Water Line

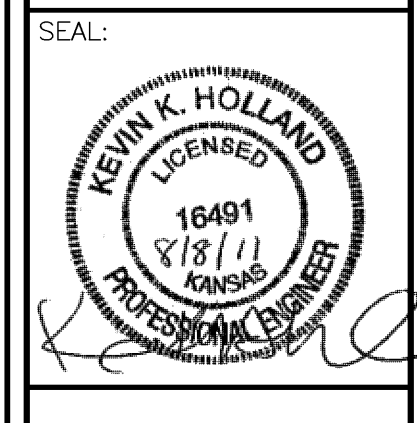

SEAL:
Cook, Flatt & Strobel
 ENGINEERS, P.A.
CFS

CFS PROJECT NO:
 10-5048

CITY OF WICHITA, KANSAS
E. HARRY ST. & WOODLAWN ST.
INTERSECTION

SHEET TITLE:
SITE PLAN

PROJECT NUMBER
 87N-0494-01

FINAL PLANS

SHEET NUMBER:
6 of 69

CP #2 - Set 1/2" Rebar w/ Red Cap
 N 1678231.578 E 1670740.921
 1. ☉ Woodlawn Blvd.
 2. NE Cor. Ret. Wall @ NE Cor. Parking (UNRUH Alignment)
 3. ☉ Top 4"x4" Conc. Fiber Optic Warning Post
 4. ☉ Top Tel. Ped.

El. = 138.420
 81.00 E
 19.71 SSE
 31.94 SSE
 15.44 SW

COW Datum BM - 2" Disc in Concrete @ SE
 Quad. of Harry & Woodlawn. Elev. 140.20

NE 1/4 Cor. Sec. 36 T27S R1E
 Fnd. 1/2" Pipe in Thimble
 1. In ☉ Intersection Harry & Woodlawn
 2. "X" Top Curb @ SSW ECR Island
 3. To Top 2" Alum. Disc COW BM
 4. "X" Cut ☉ End CAP Island
 5. "X" Cut ☉ End Cap Island
 6. "X" Cut Top Curb 3.0' N. SW Cor. Island
 N 1678289.186 E 1670822.442

52.36 SW
 76.76 SE
 49.15 ESE
 51.63 NE
 61.85 NNE
 El. = 139.003

BM #1 Fnd. 2" Disc on the NE Wingwall
 of Bridge over Gipsom Creek @ Fabrique
 & Harry Stamped (1319.87) COW BM
 37.75' Rt. Sta. 109+87.10 Elev. 140.23

- LEGEND**
- Mill & Overlay
 - Exist. Pvmt. to be Removed
 - E.P. Edge of Pavement
 - T/C Top of Curb
 - B/C Back of Curb
 - b/b Back to Back (of curb)
 - ① Const. 6" Conc. Sidewalk Ramp (Type A)
 - ② Const. 4" Conc Sidewalk