
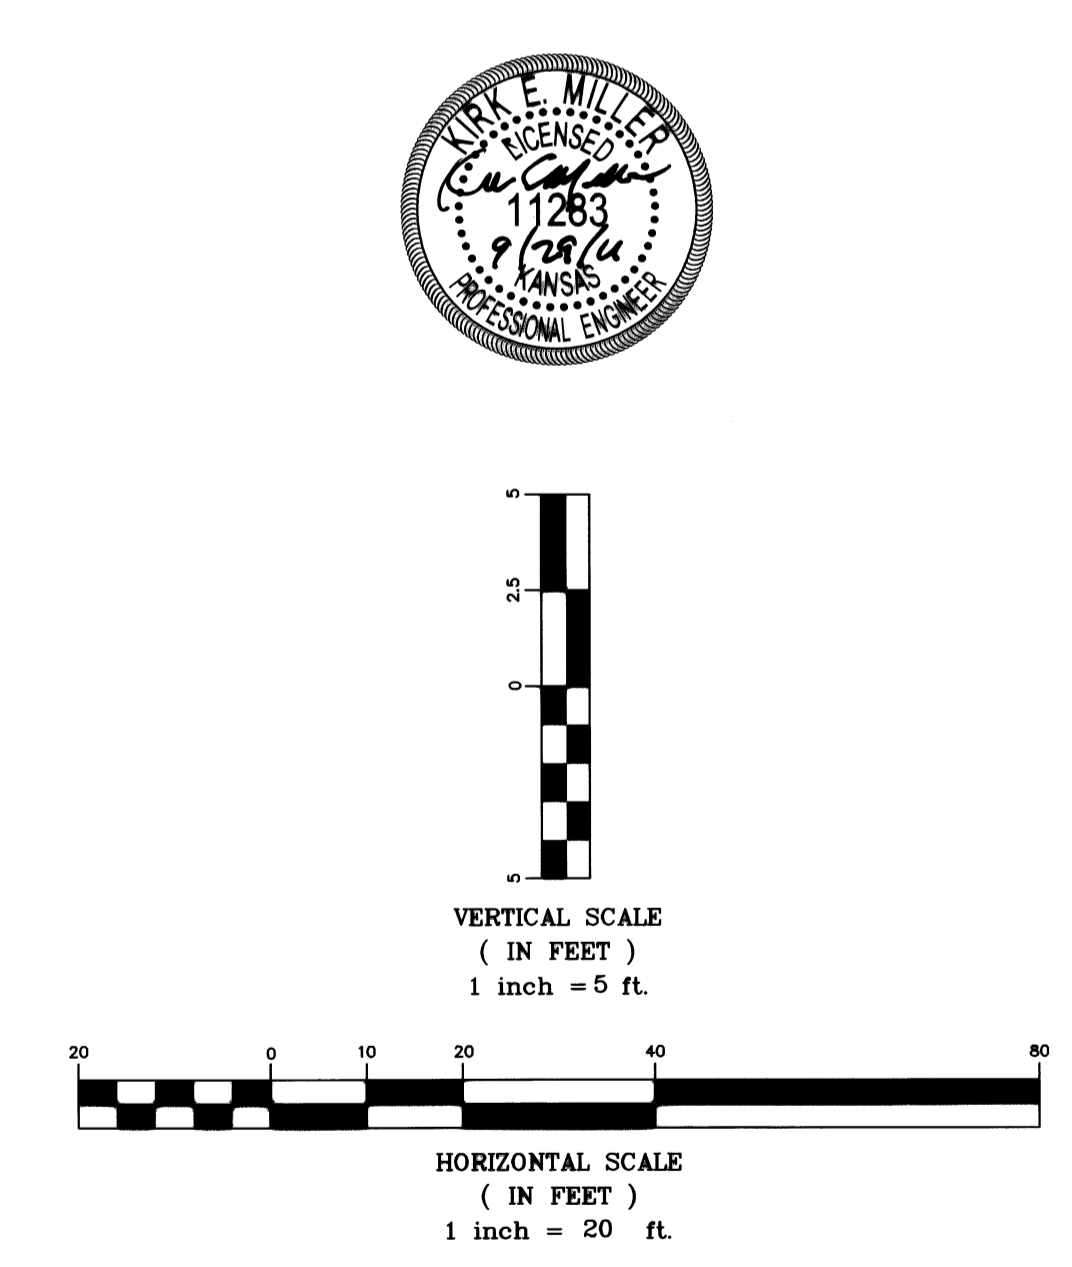


- Notes:
- All improvements are on private property and connect to private water lines.

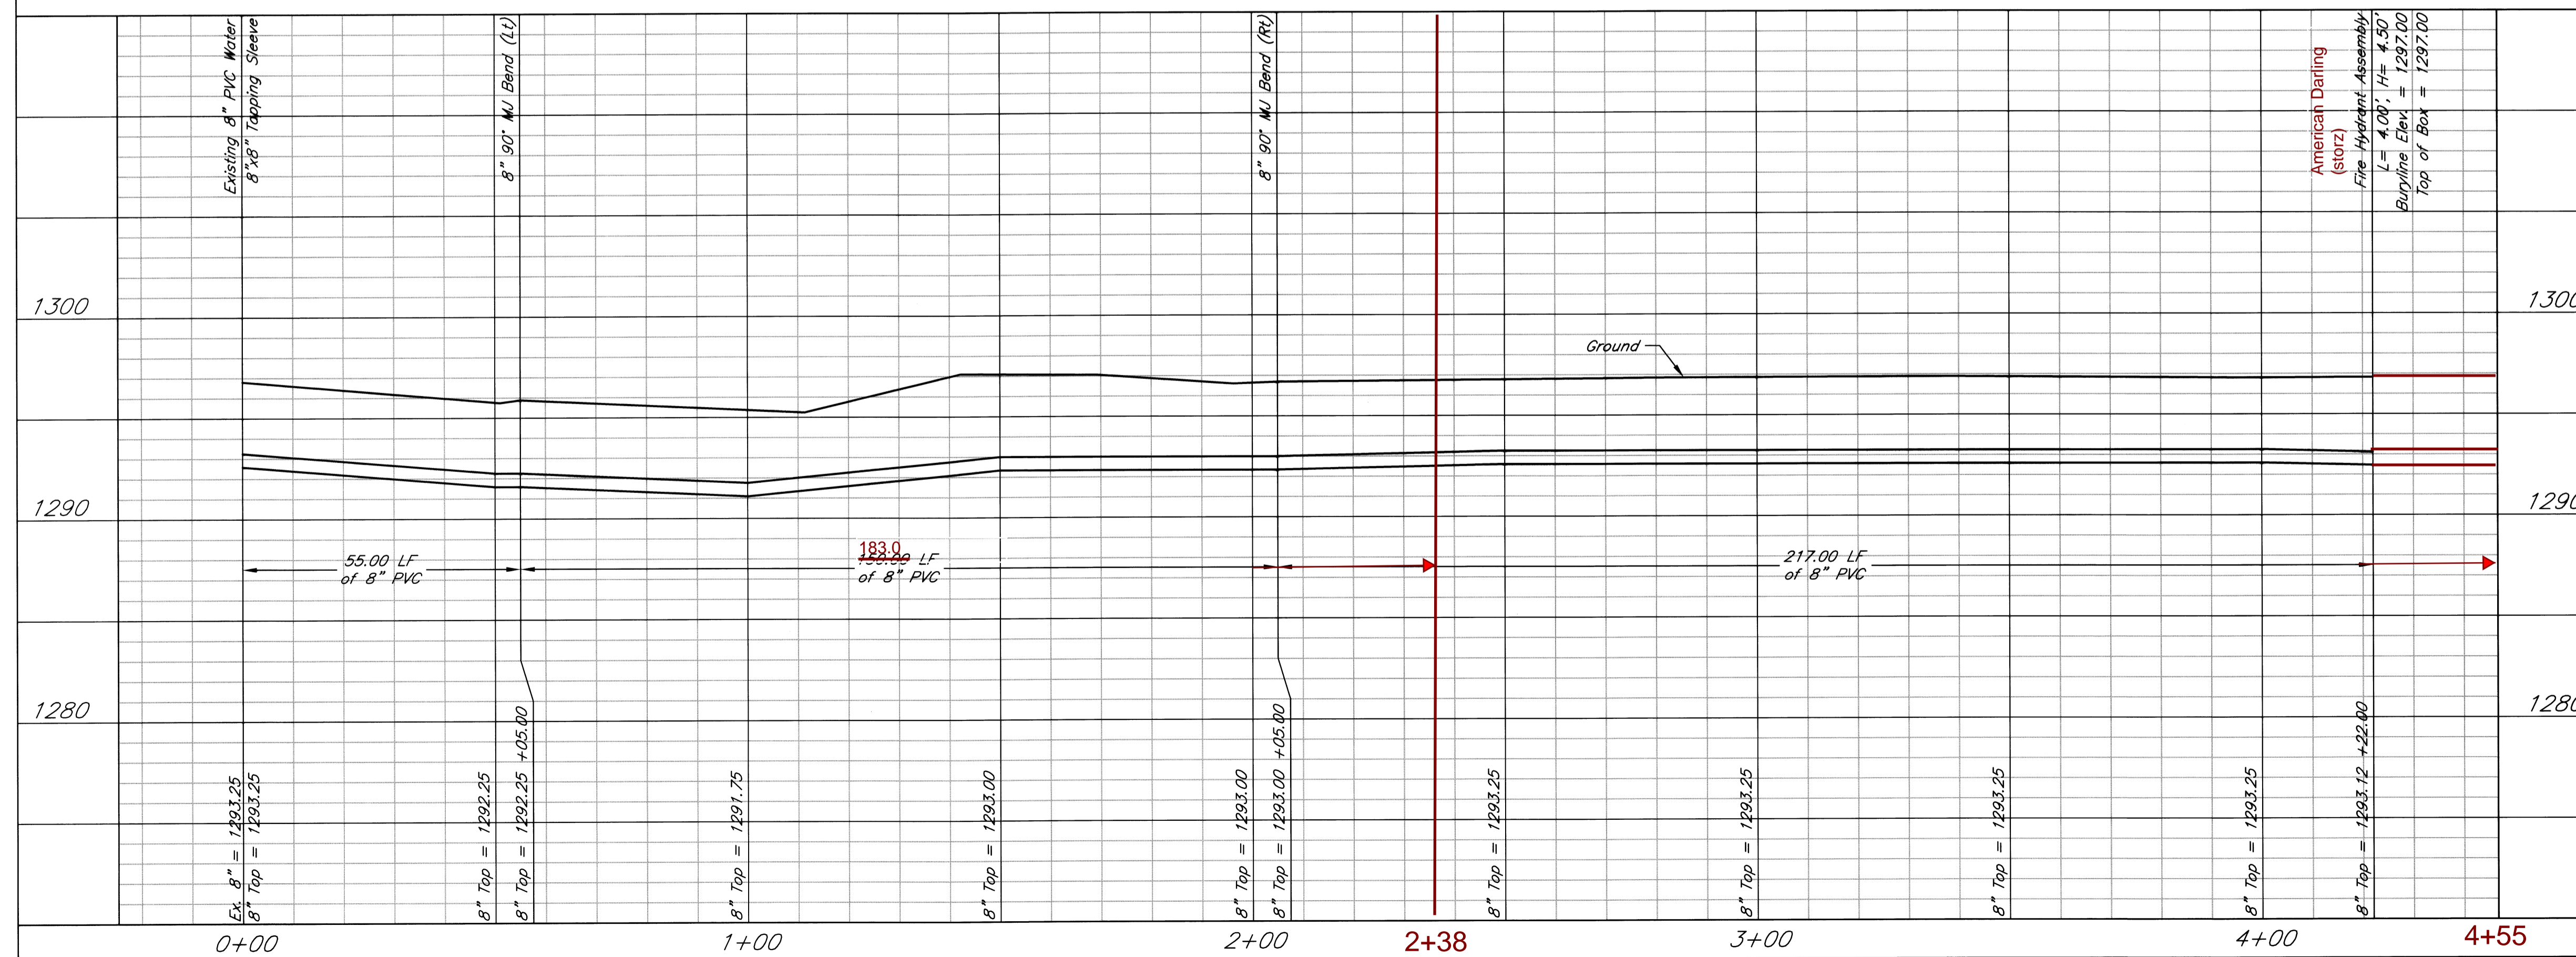

Metal-Fab, Inc.
Line 1
 Wichita, Kansas

PROJECT NUMBER
1618 PPW (607853)

kemiller engineering	KEM NO. 11088	FILE	DATE 08/22/11	SHEET 2.0
	DESIGN KM	DRAWN NS	REVISED	

516 S. Market, Wichita, KS 67202 (316)264-0242