

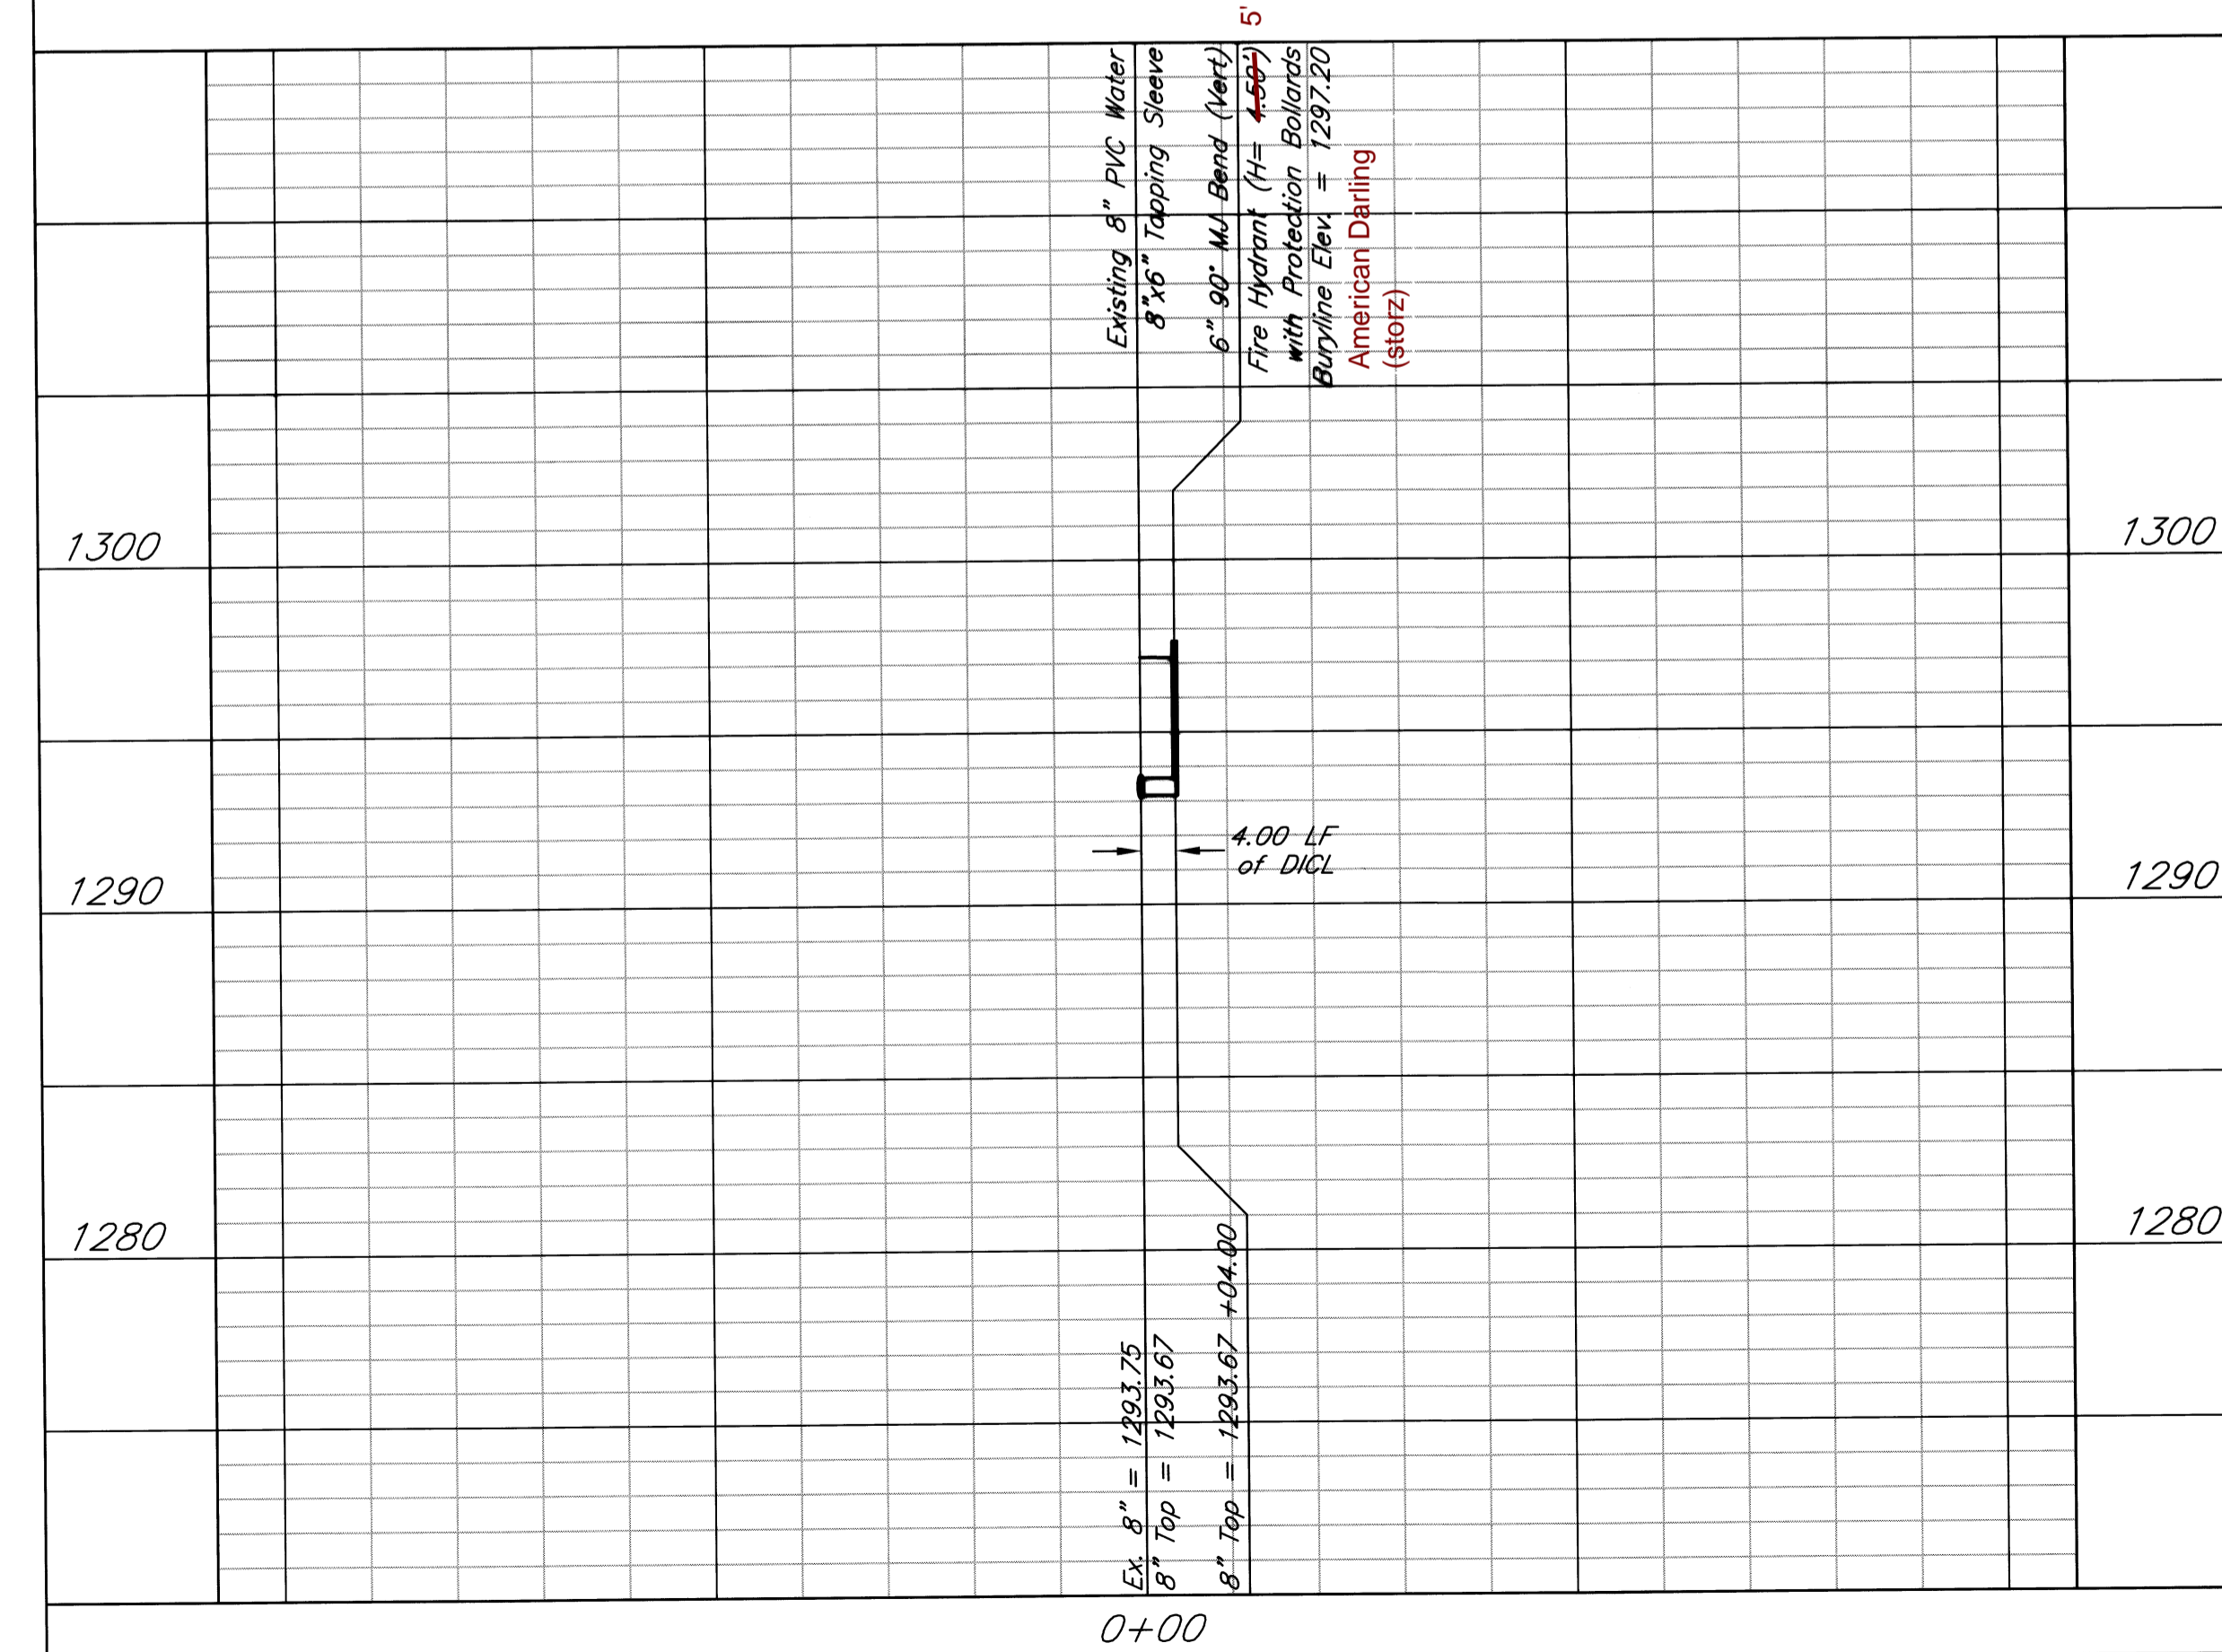
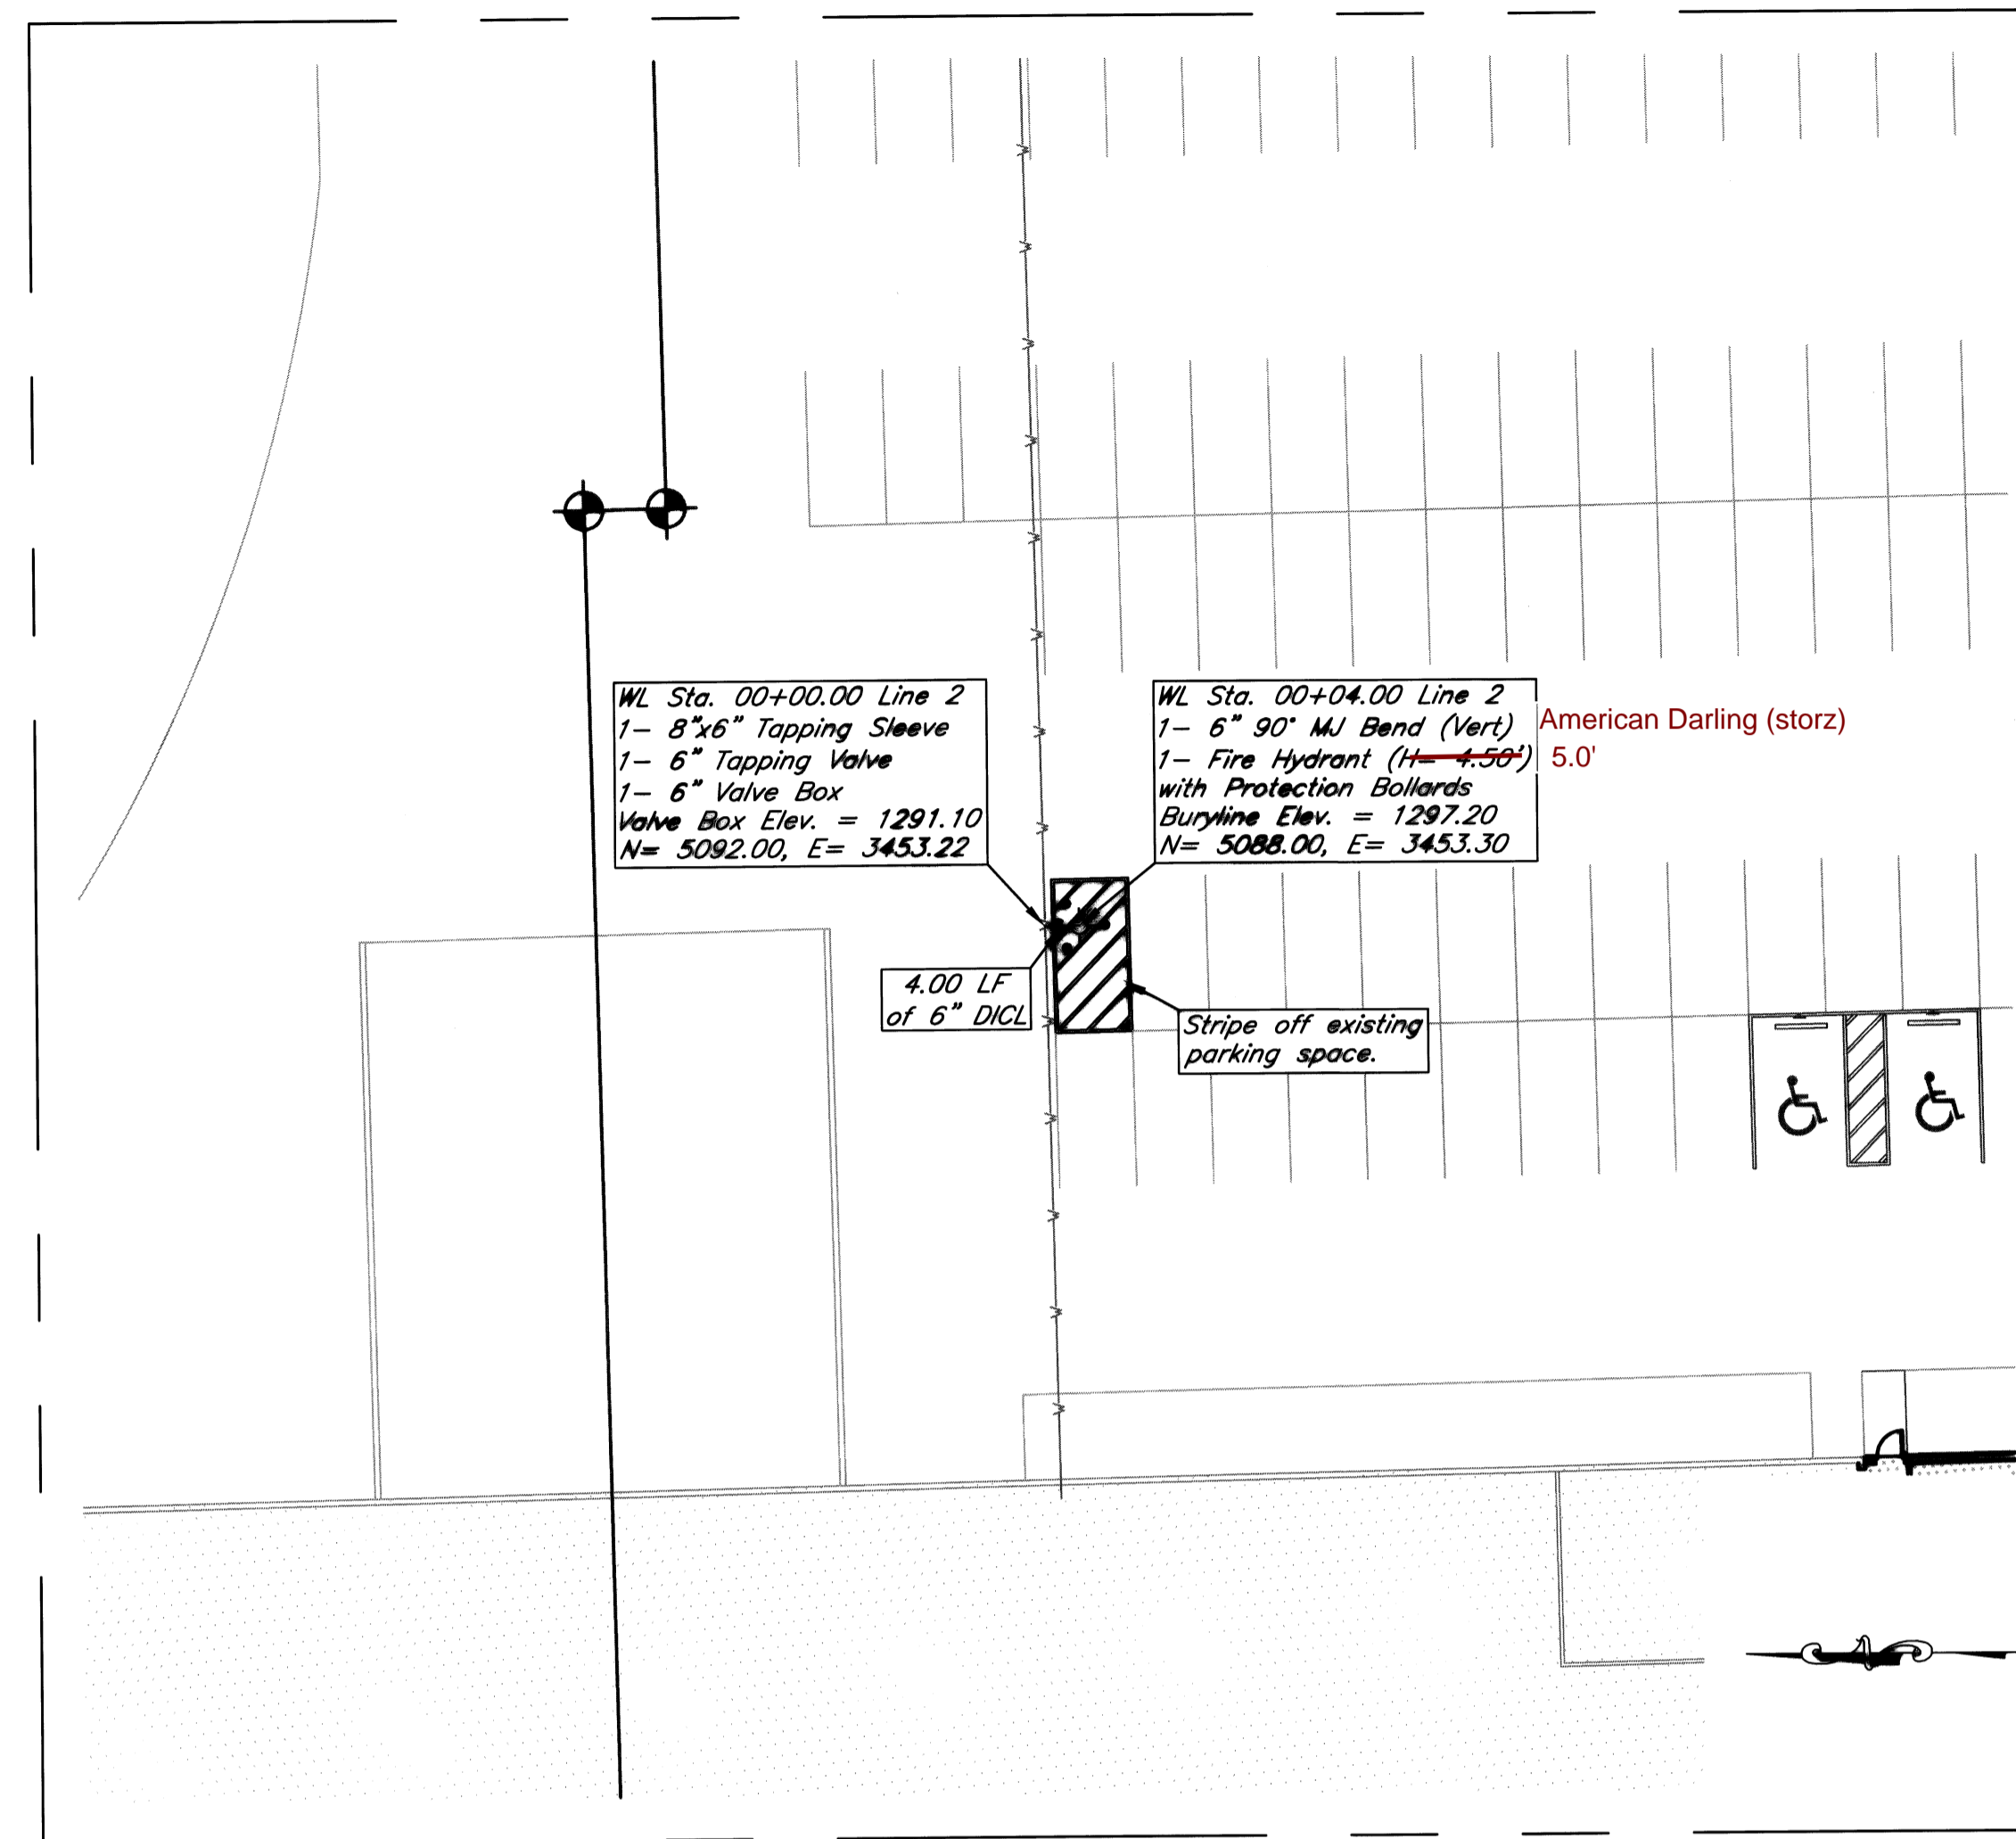
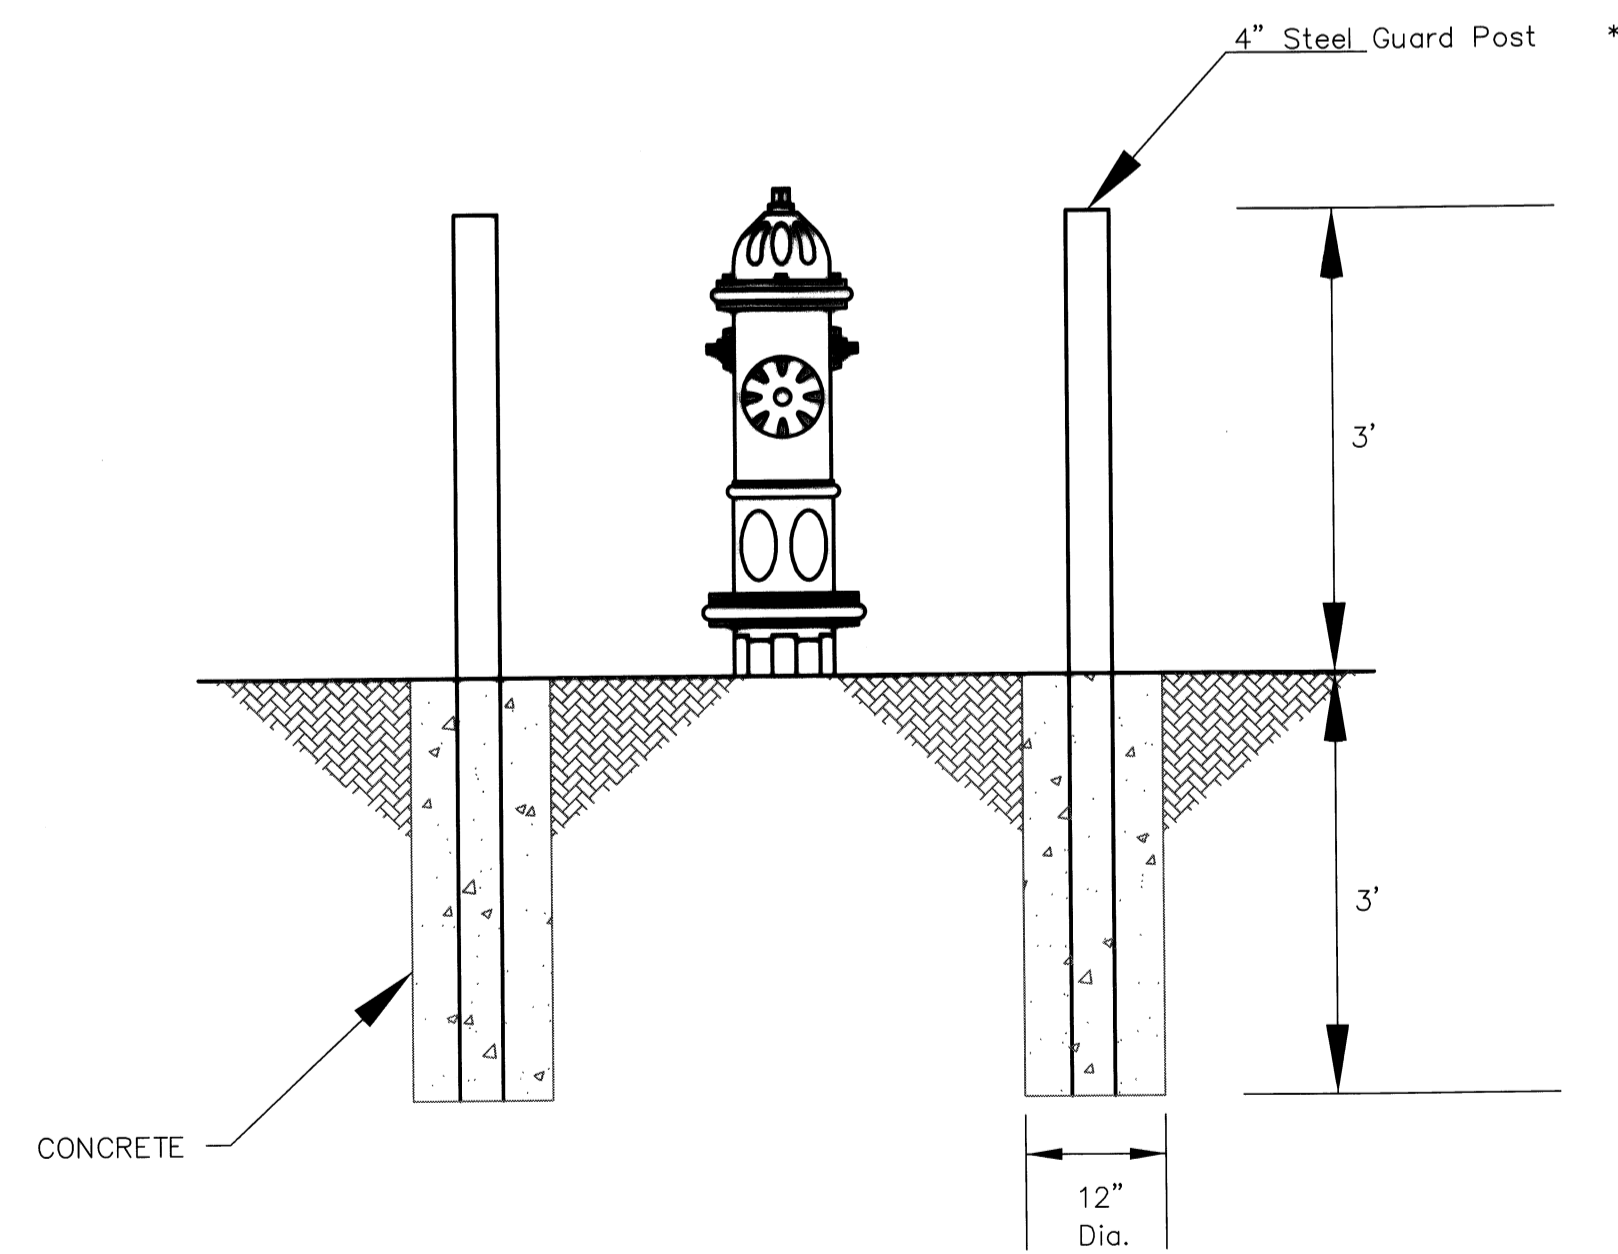


PROTECTION BOLLARDS
FOR FIRE HYDRANTS

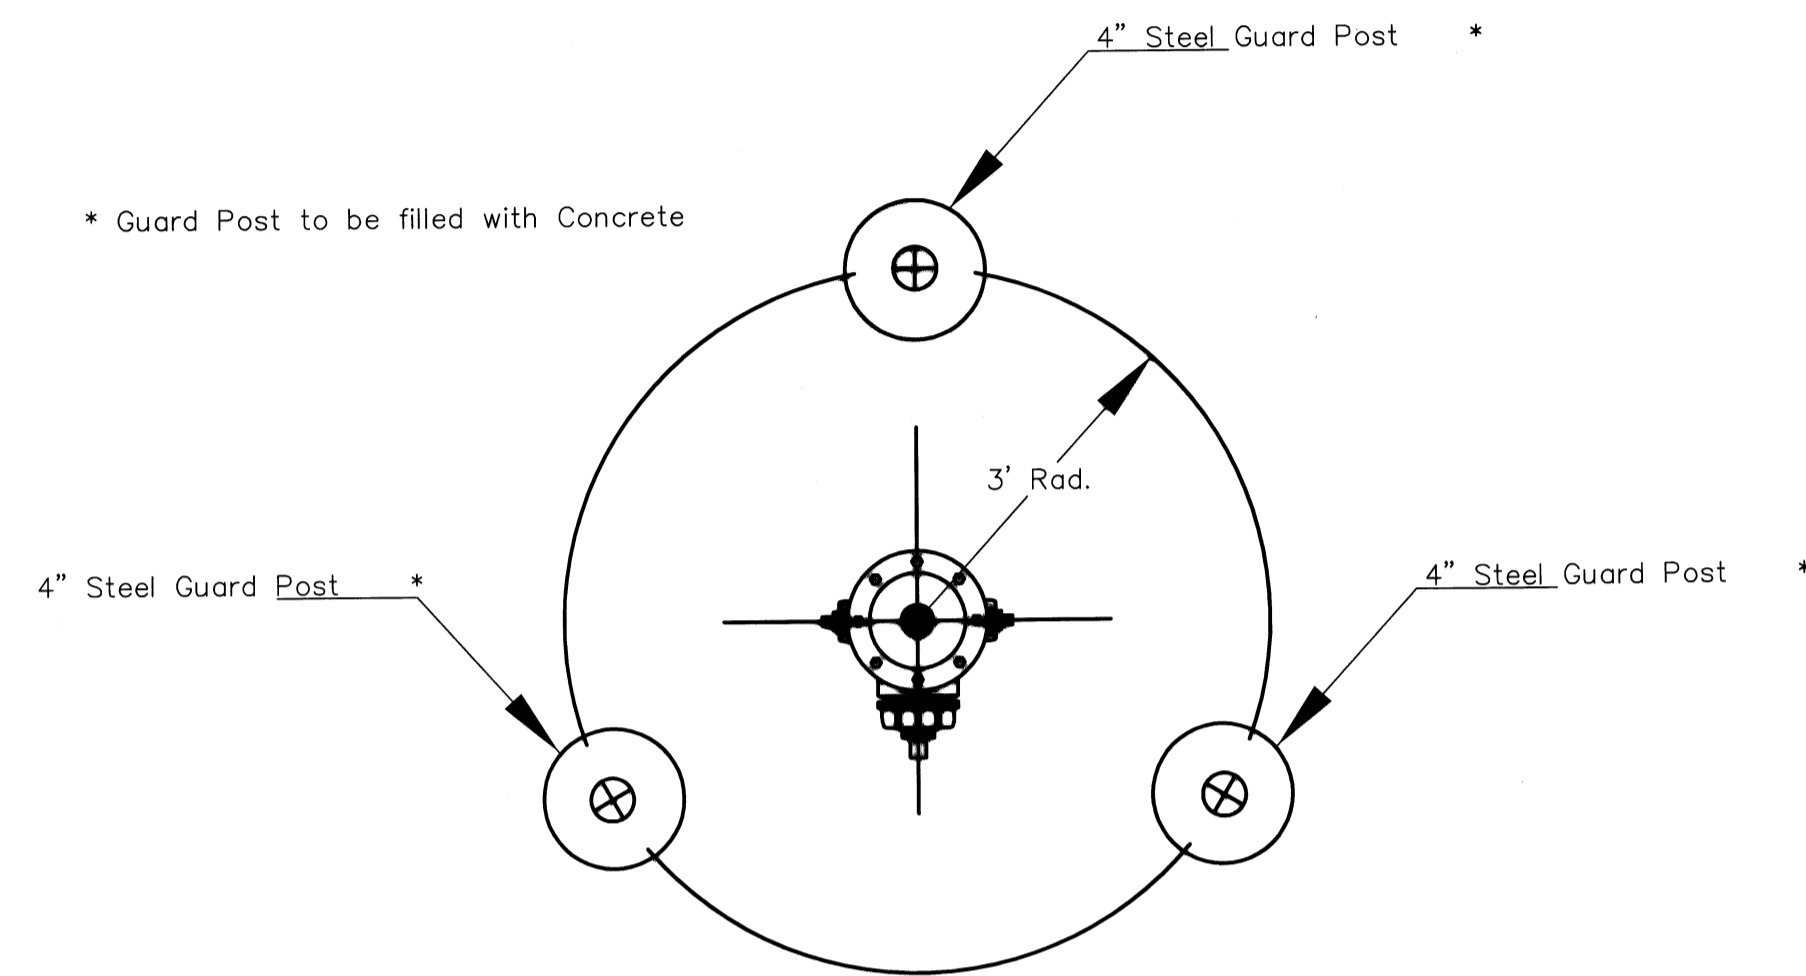

Notes:

- All improvements are on private property and connect to private water lines.
- All pipe used while construction of "Line 2" are to be DICL.

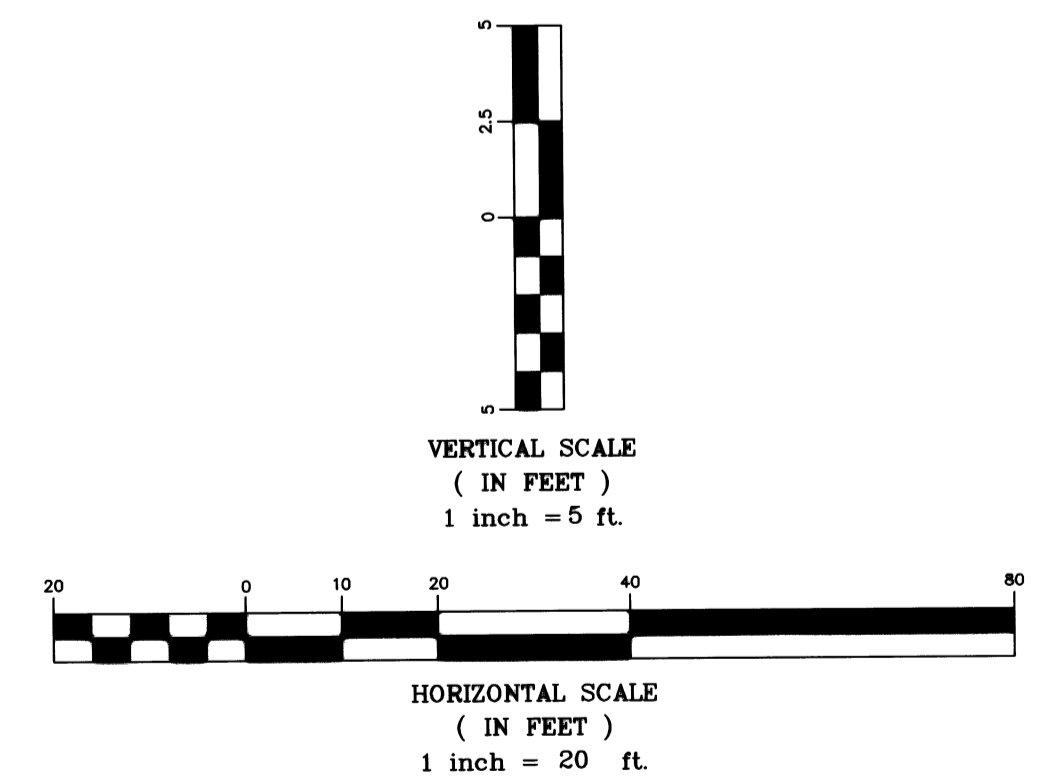

Metal-Fab, Inc.
Line 2
Wichita, Kansas



PROJECT NUMBER 1618 PPW (607853)			
KEM NO. 11088	FILE	DATE 08/22/11	SHEET 2.1
DESIGN KM	DRAWN NS	REVISED	

516 S. Market, Wichita, KS 67202 (316)264-0242