

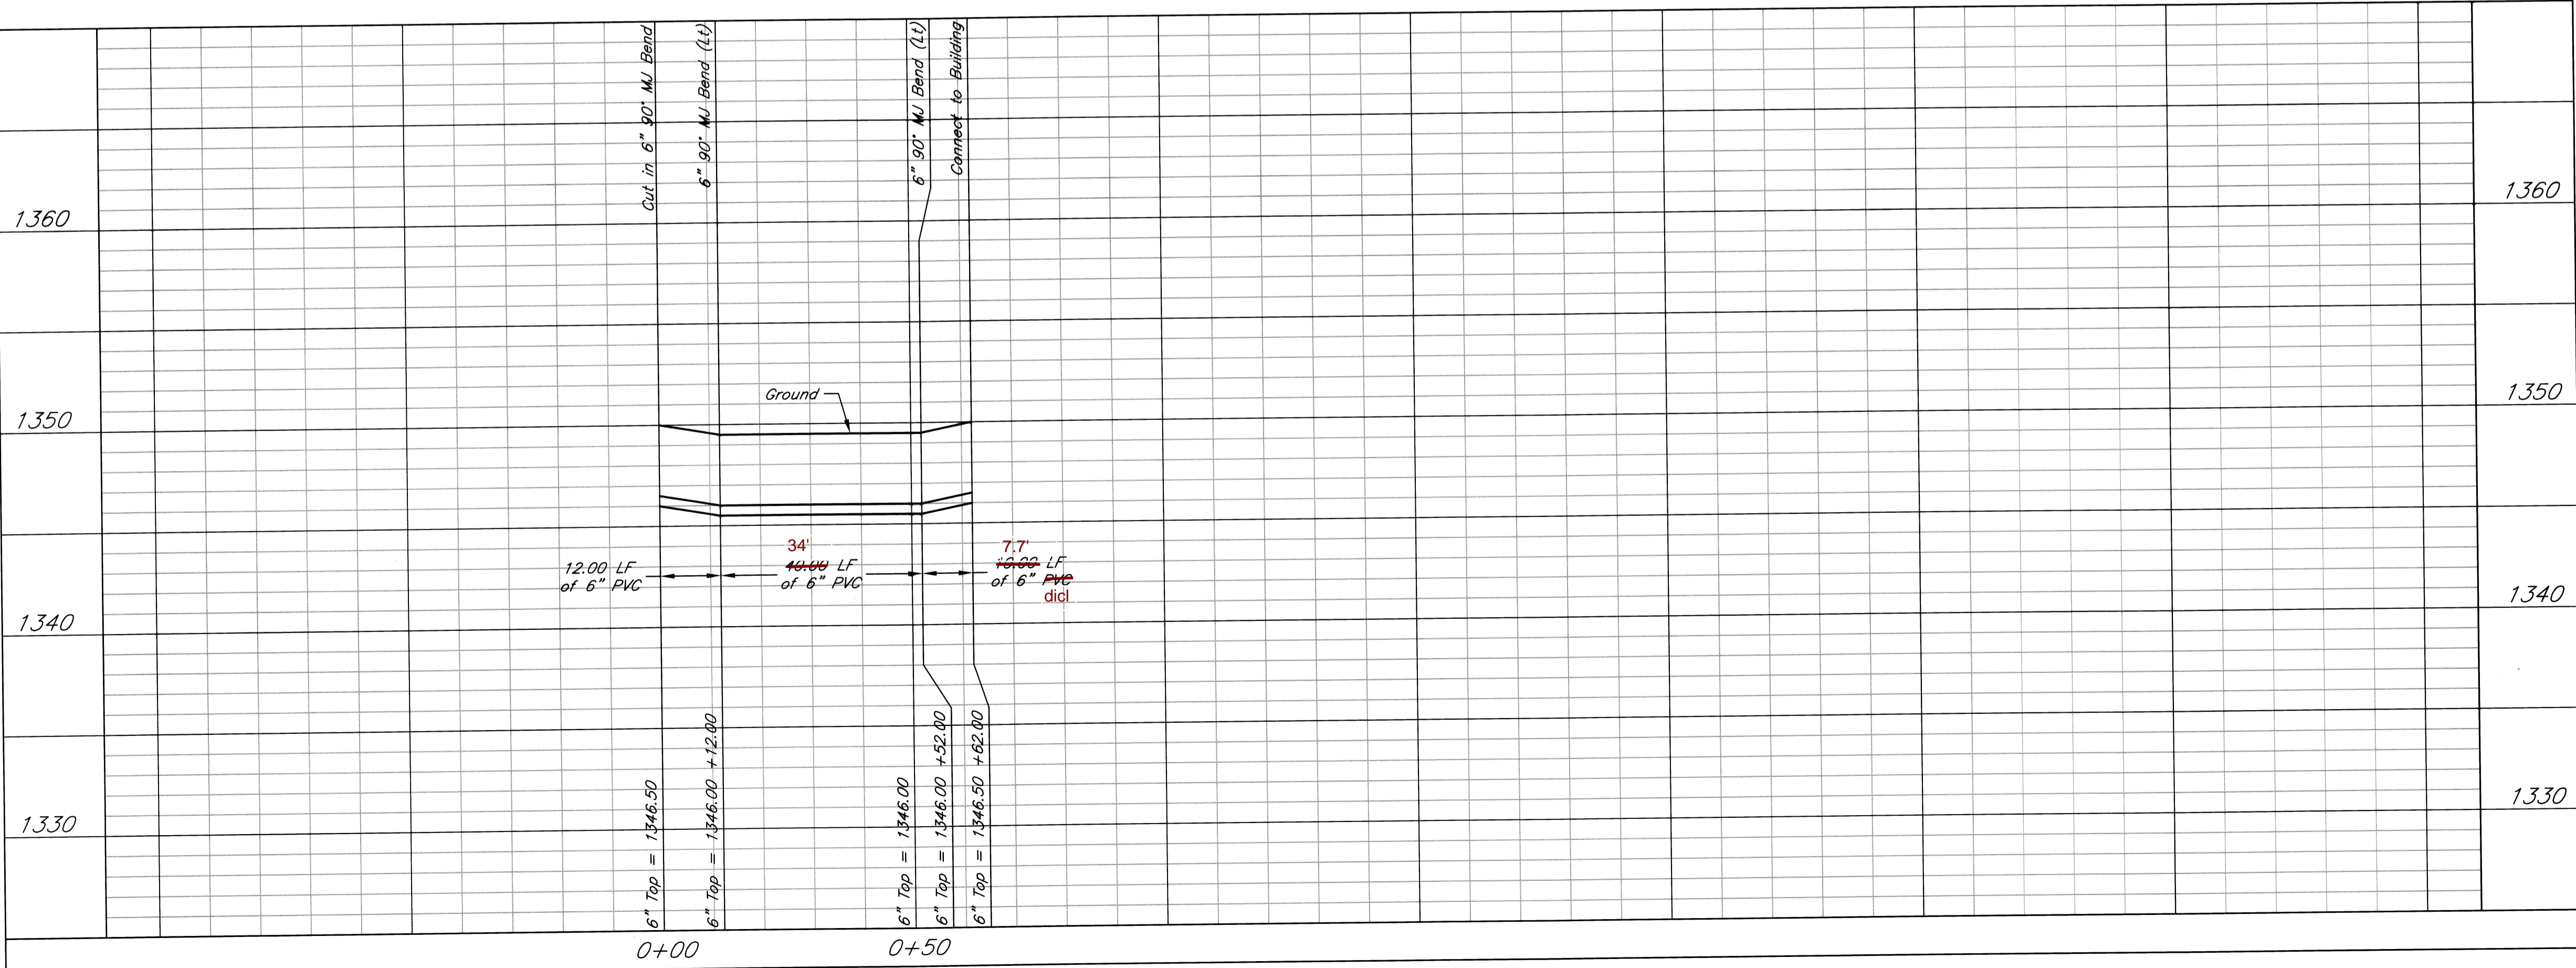
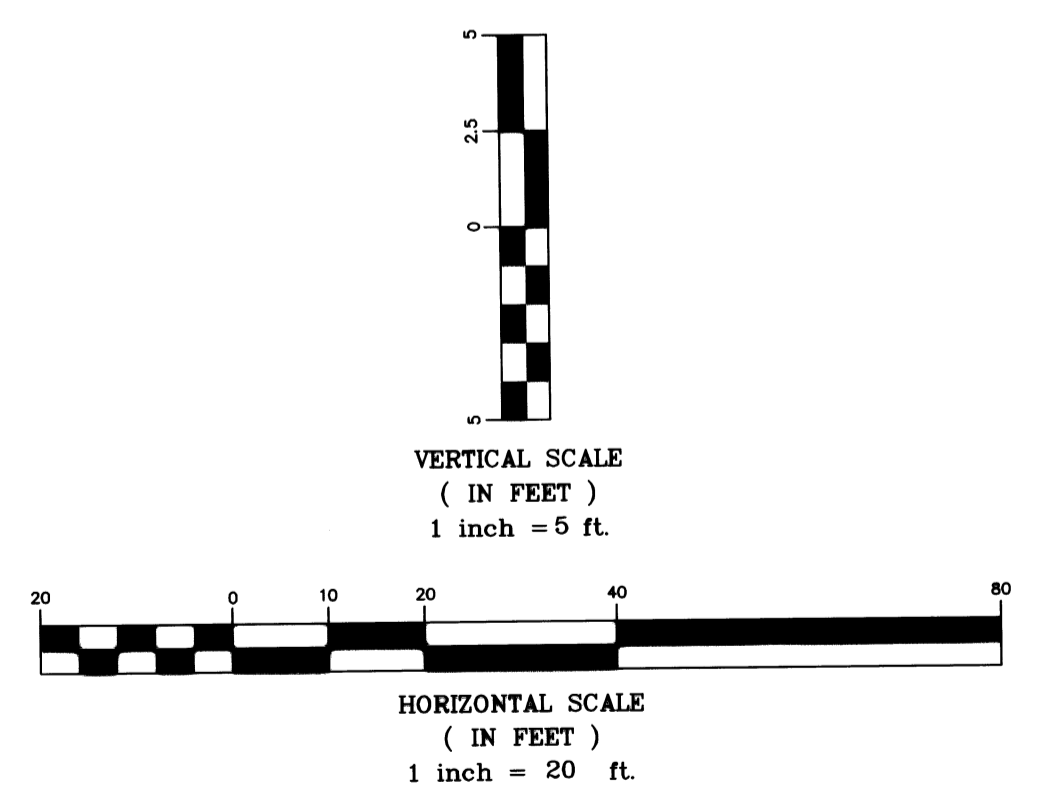


- Notes:**
1. All improvements are located on private property connecting to private water line with vault.
  2. Existing 6" water line East of WL Sta. 00+00.00 to be removed or abandoned per City of Wichita Specifications.
  3. Existing Fire Department Connection to be relocated to South Wall of proposed building addition.

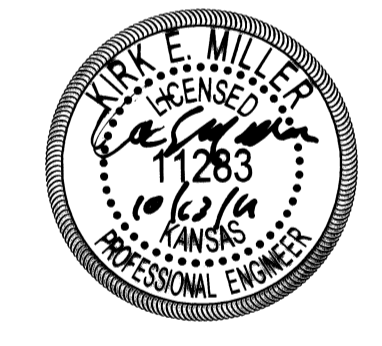

**Rusty Eck Ford  
Water Line  
Wichita, Kansas**

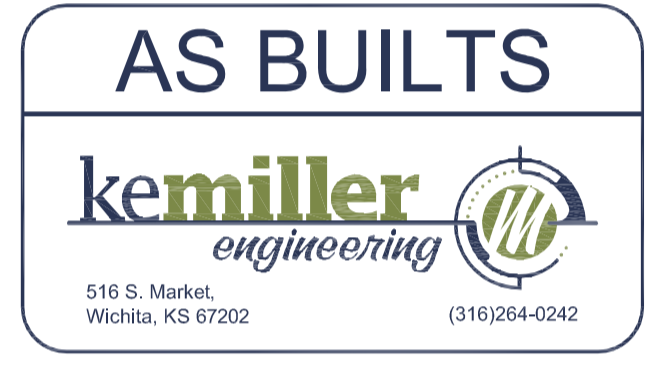

PROJECT NUMBER				SHEET <b>2.0</b>
KEM NO. 11106	FILE	DATE 10/04/11		
DESIGN KM	DRAWN NS	REVISED		

516 S. Market, Wichita, KS 67202 (316)264-0242