
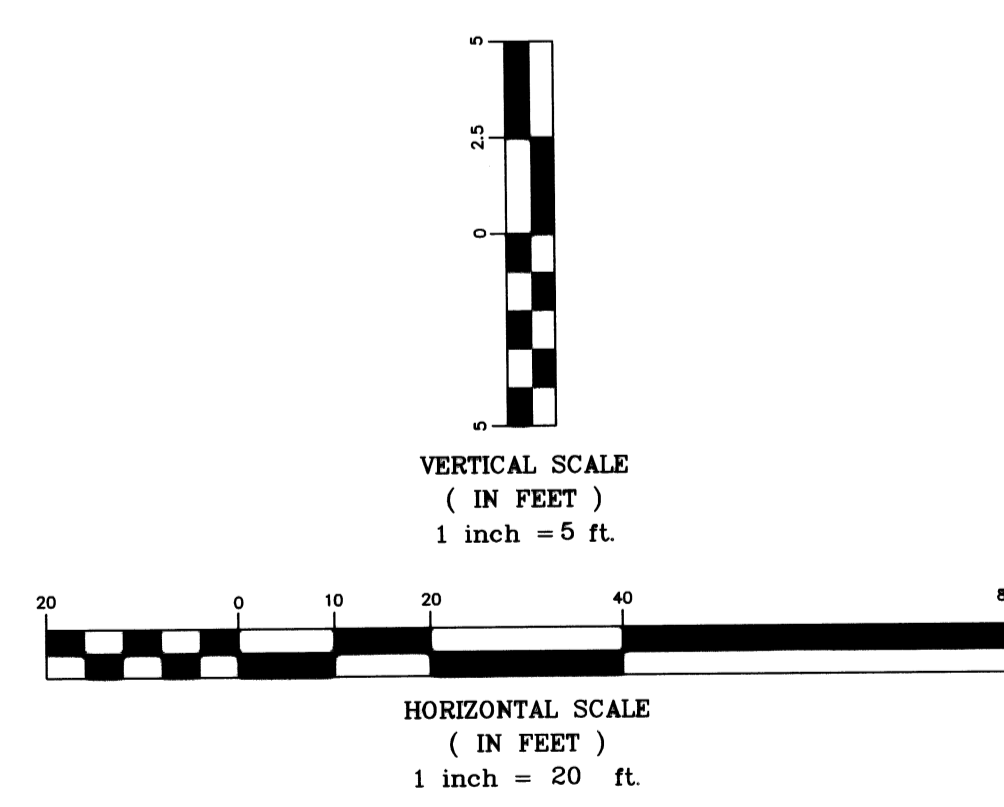


Notes:

Waterline to have 2.0 feet clearance above or below sanitary sewer line at crossing. If 2.0 feet clearance can not be created, sanitary sewer line must be incased (per city specs) at minimum 10.0 feet either side of crossing.

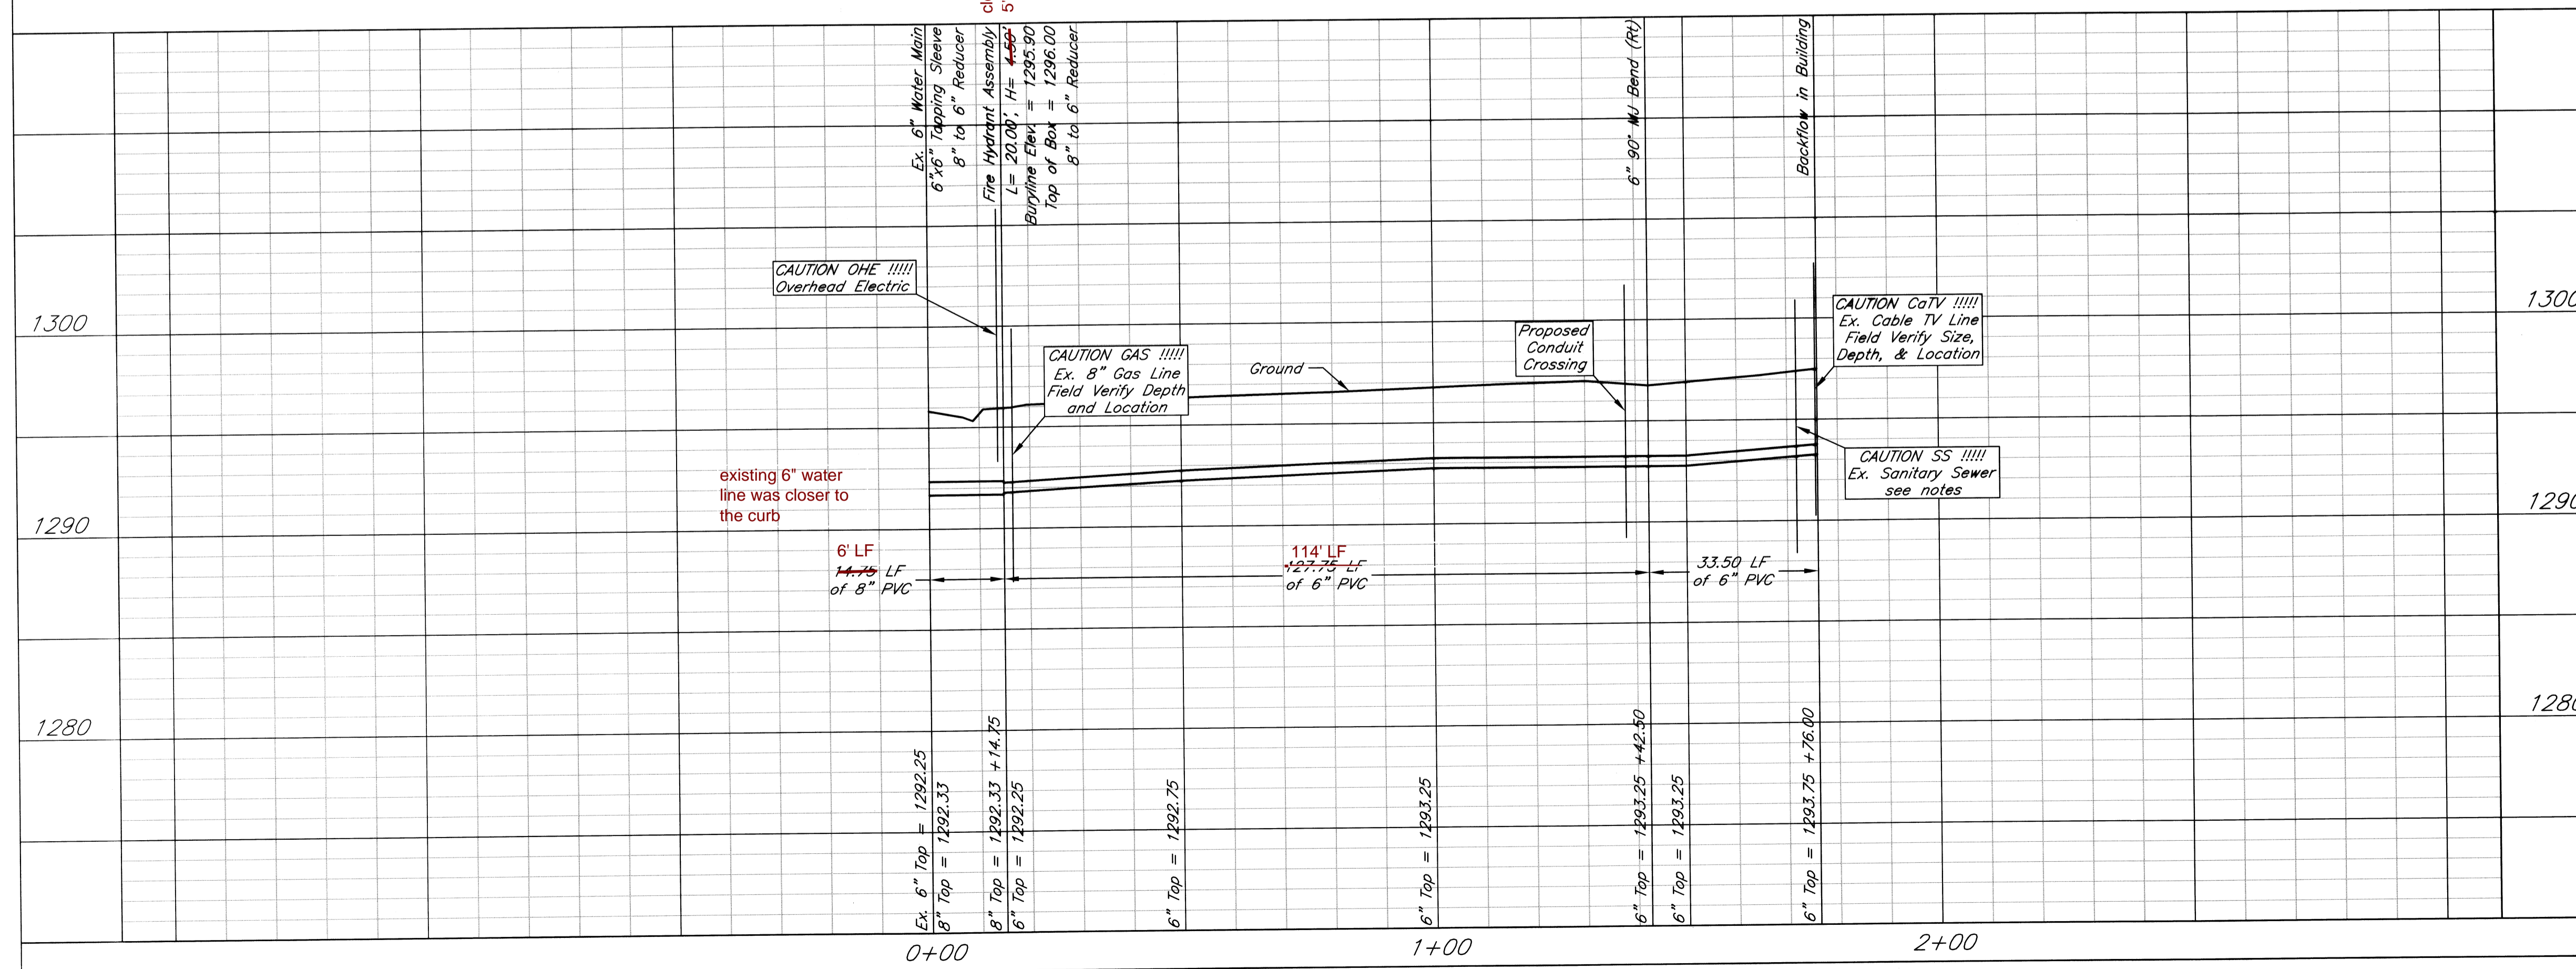

1525 E. Douglas Water Line
Wichita, Kansas

PROJECT NUMBER 1598 PPW (607853)		SHEET 2.0	
KEM NO. 11057	FILE	DATE 06/27/11	REVISIONS
DESIGN KM	DRAWN NS	REVISED	

516 S. Market, Wichita, KS 67202 (316)264-0242