
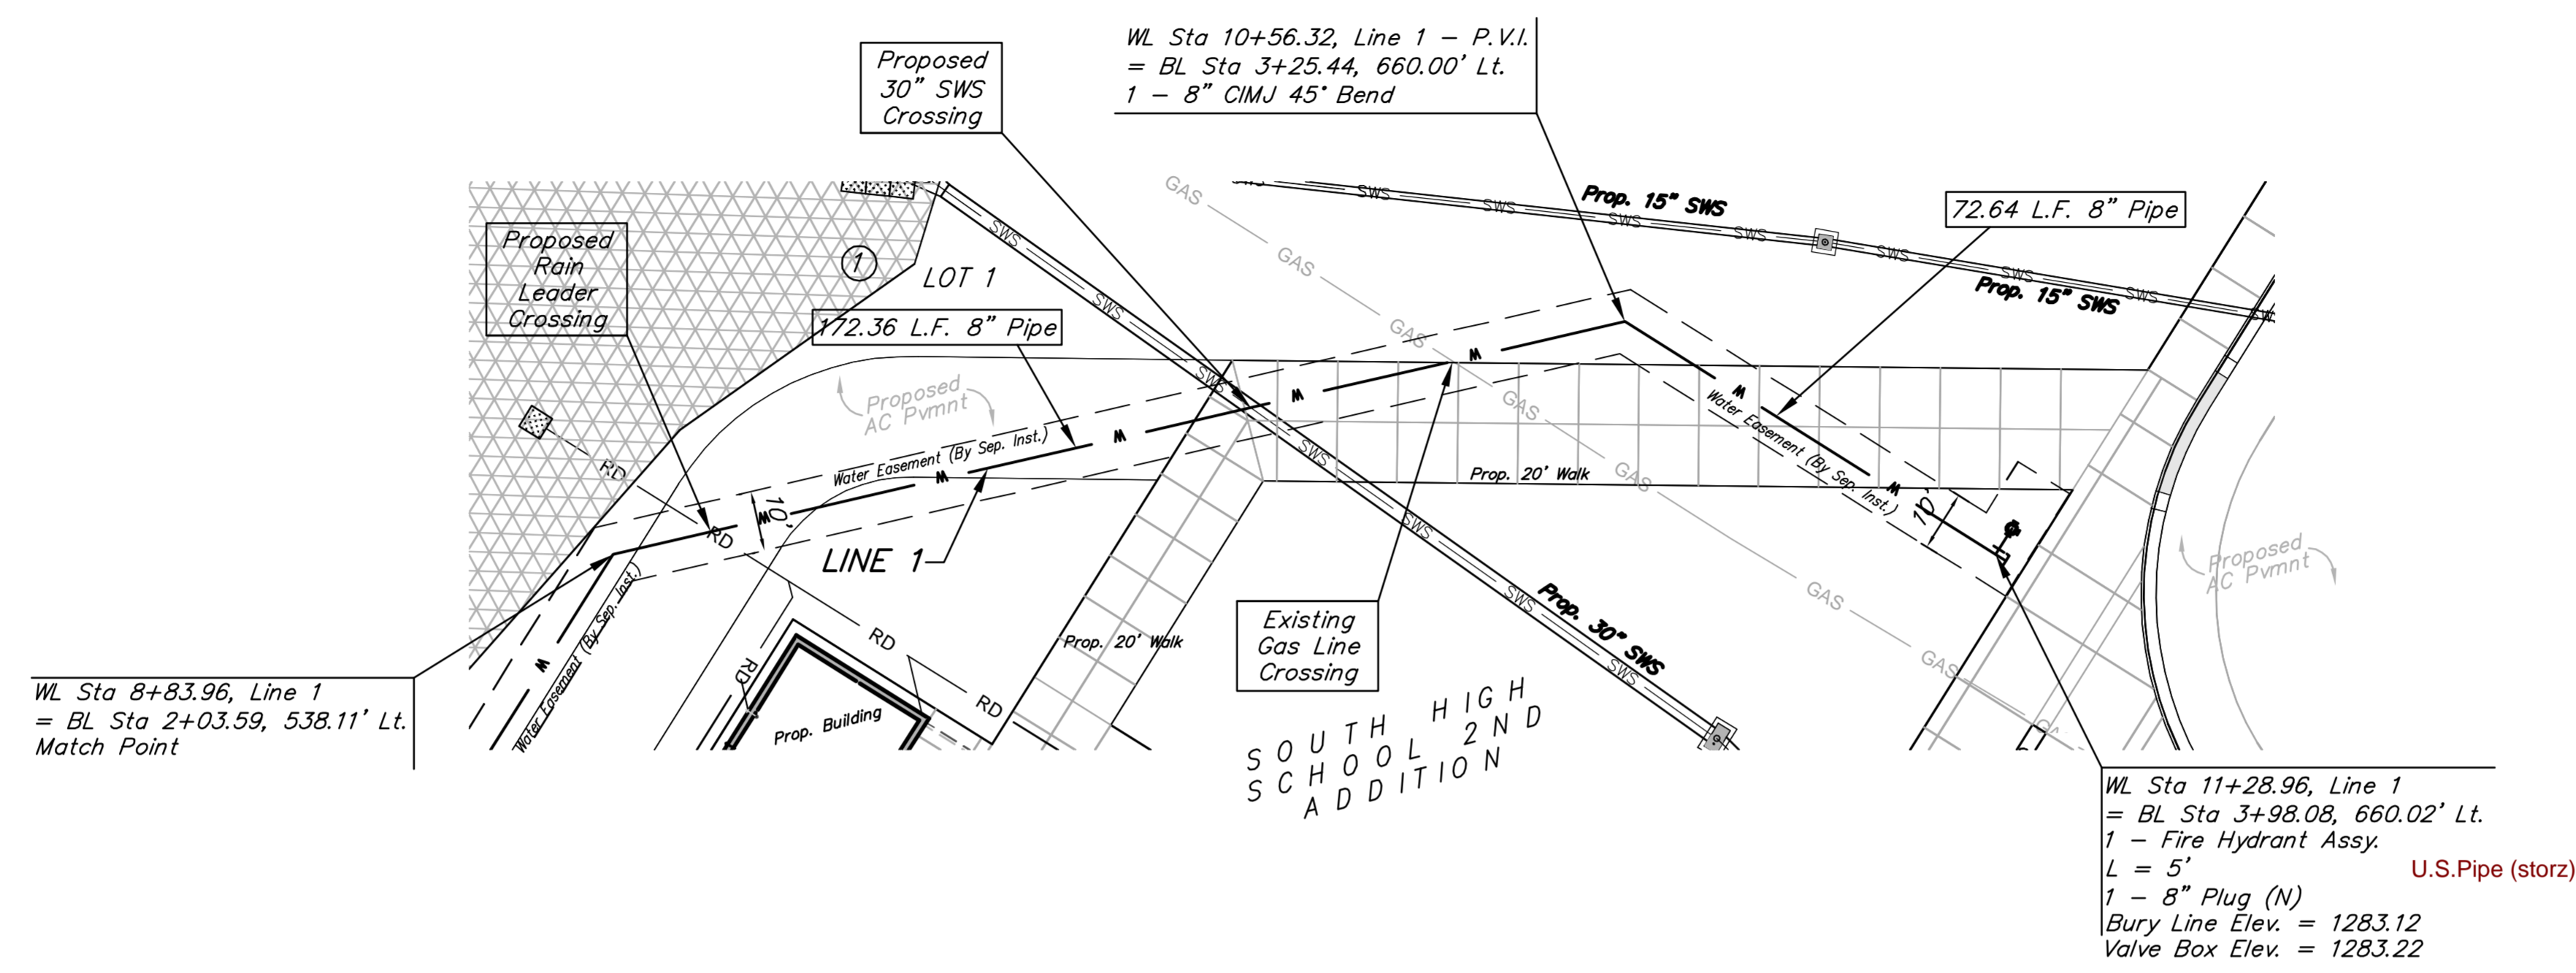



Benchmarks

Benchmark #1 - "□" Chiseled on Top of Concrete
ELEV. = 1285.93 (NAVD 88)

Benchmark #2 - "□" Chiseled on Top of Concrete
ELEV. = 1284.29 (NAVD 88)

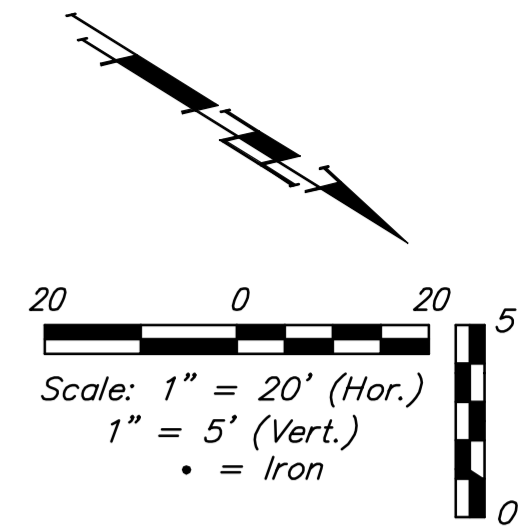

Baseline = Southeast Corner of Lot 1 Block 1 South High School 2nd Addition

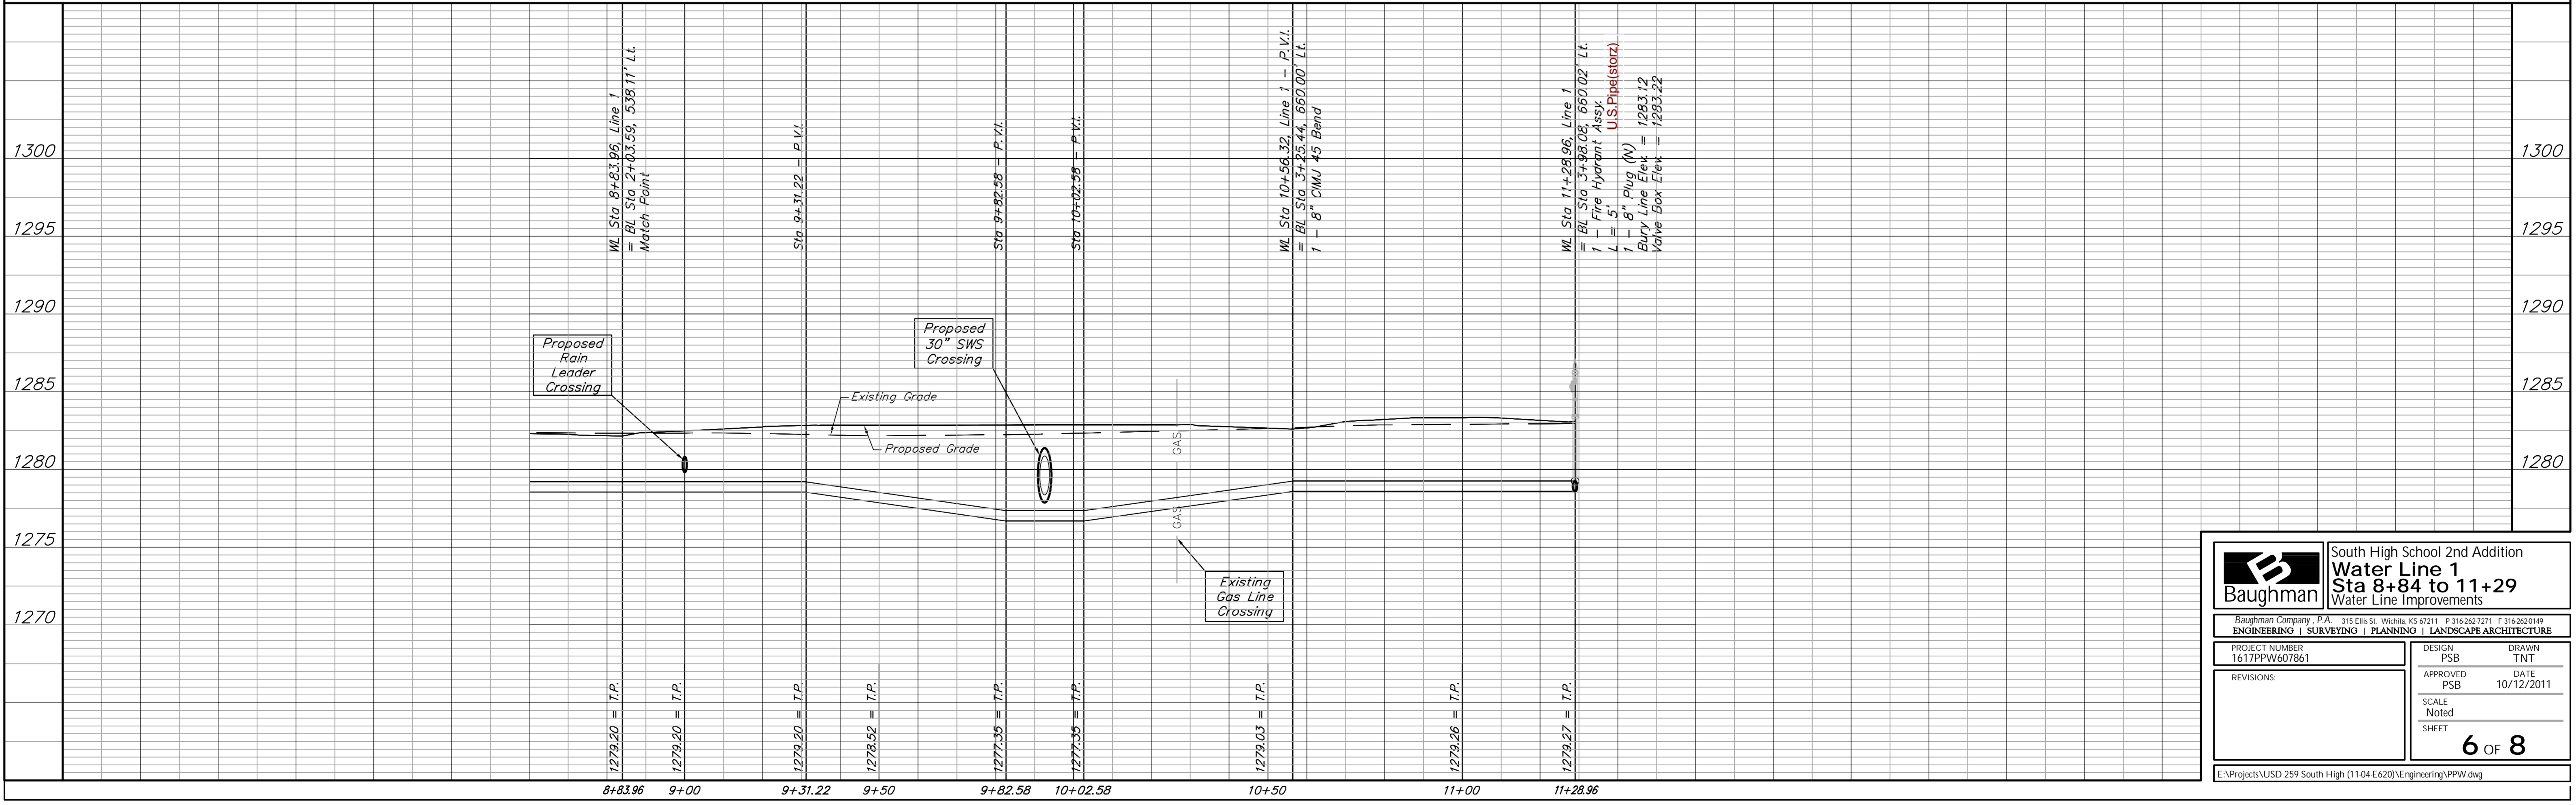

		South High School 2nd Addition Water Line 1 Sta 8+84 to 11+29 Water Line Improvements	
		ENGINEERING SURVEYING PLANNING LANDSCAPE ARCHITECTURE	
PROJECT NUMBER 1617PPW607861	DESIGN PSB	DRAWN TNT	DATE 10/12/2011
REVISIONS:	APPROVED PSB	SCALE Noted	SHEET 6 OF 8