
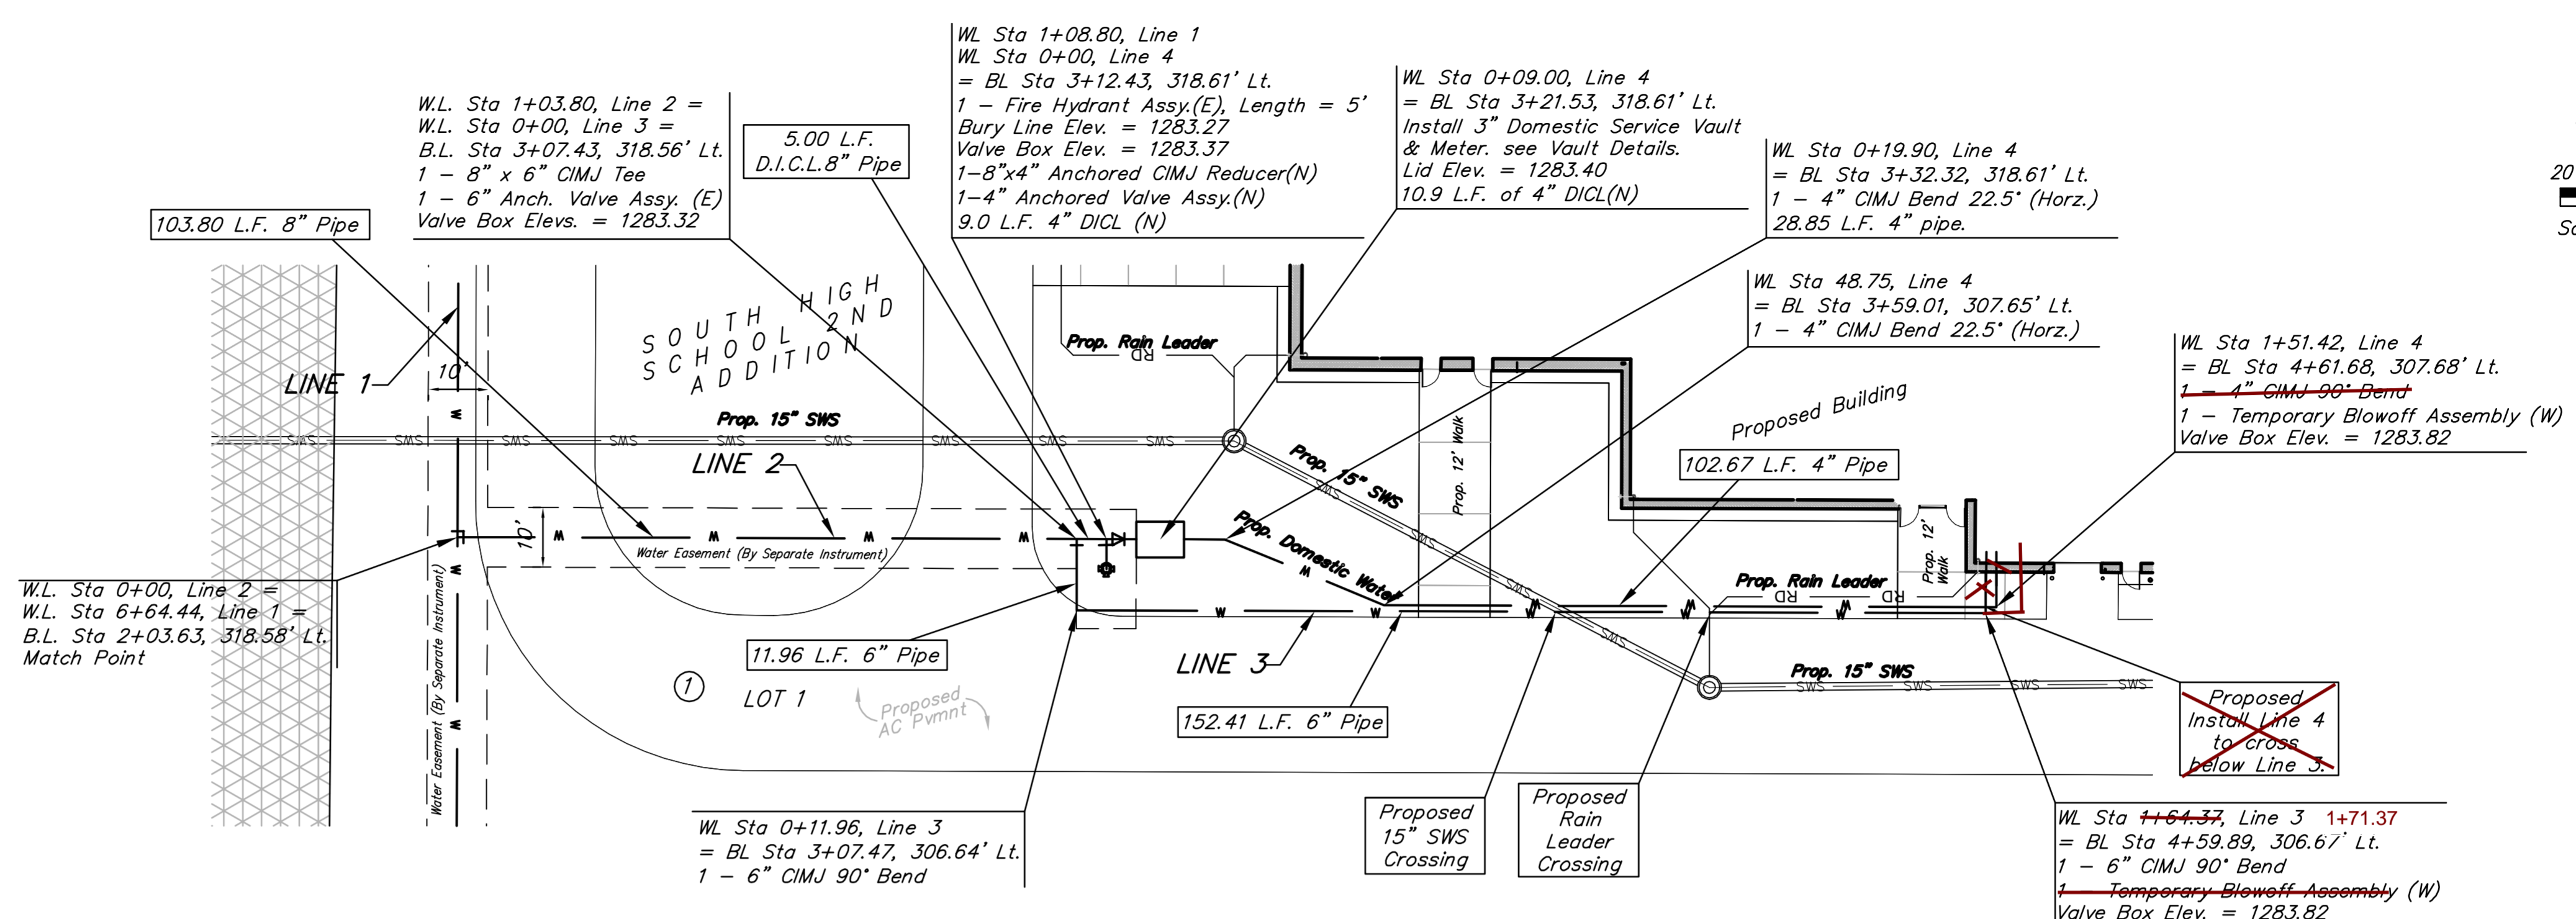


Benchmarks

Benchmark #1 - "□" Chiseled on Top of Concrete
ELEV. = 1285.93 (NAVD 88)

Benchmark #2 - "□" Chiseled on Top of Concrete
ELEV. = 1284.29 (NAVD 88)

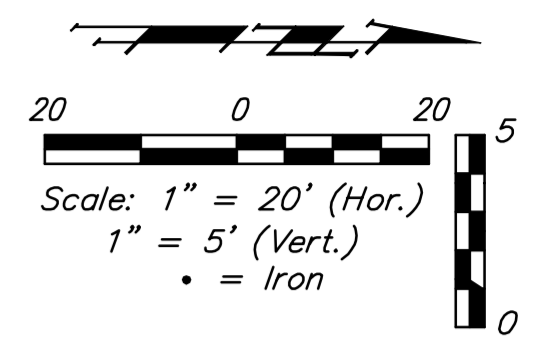


~~Proposed Install Line 4 to cross below Line 3.~~

stainless steel riser in building

Temporary Blowoff Assys to be removed by Building Plumber and extended into Mechanical Room.

Baseline = Southeast Corner of Lot 1 Block 1 South High School 2nd Addition

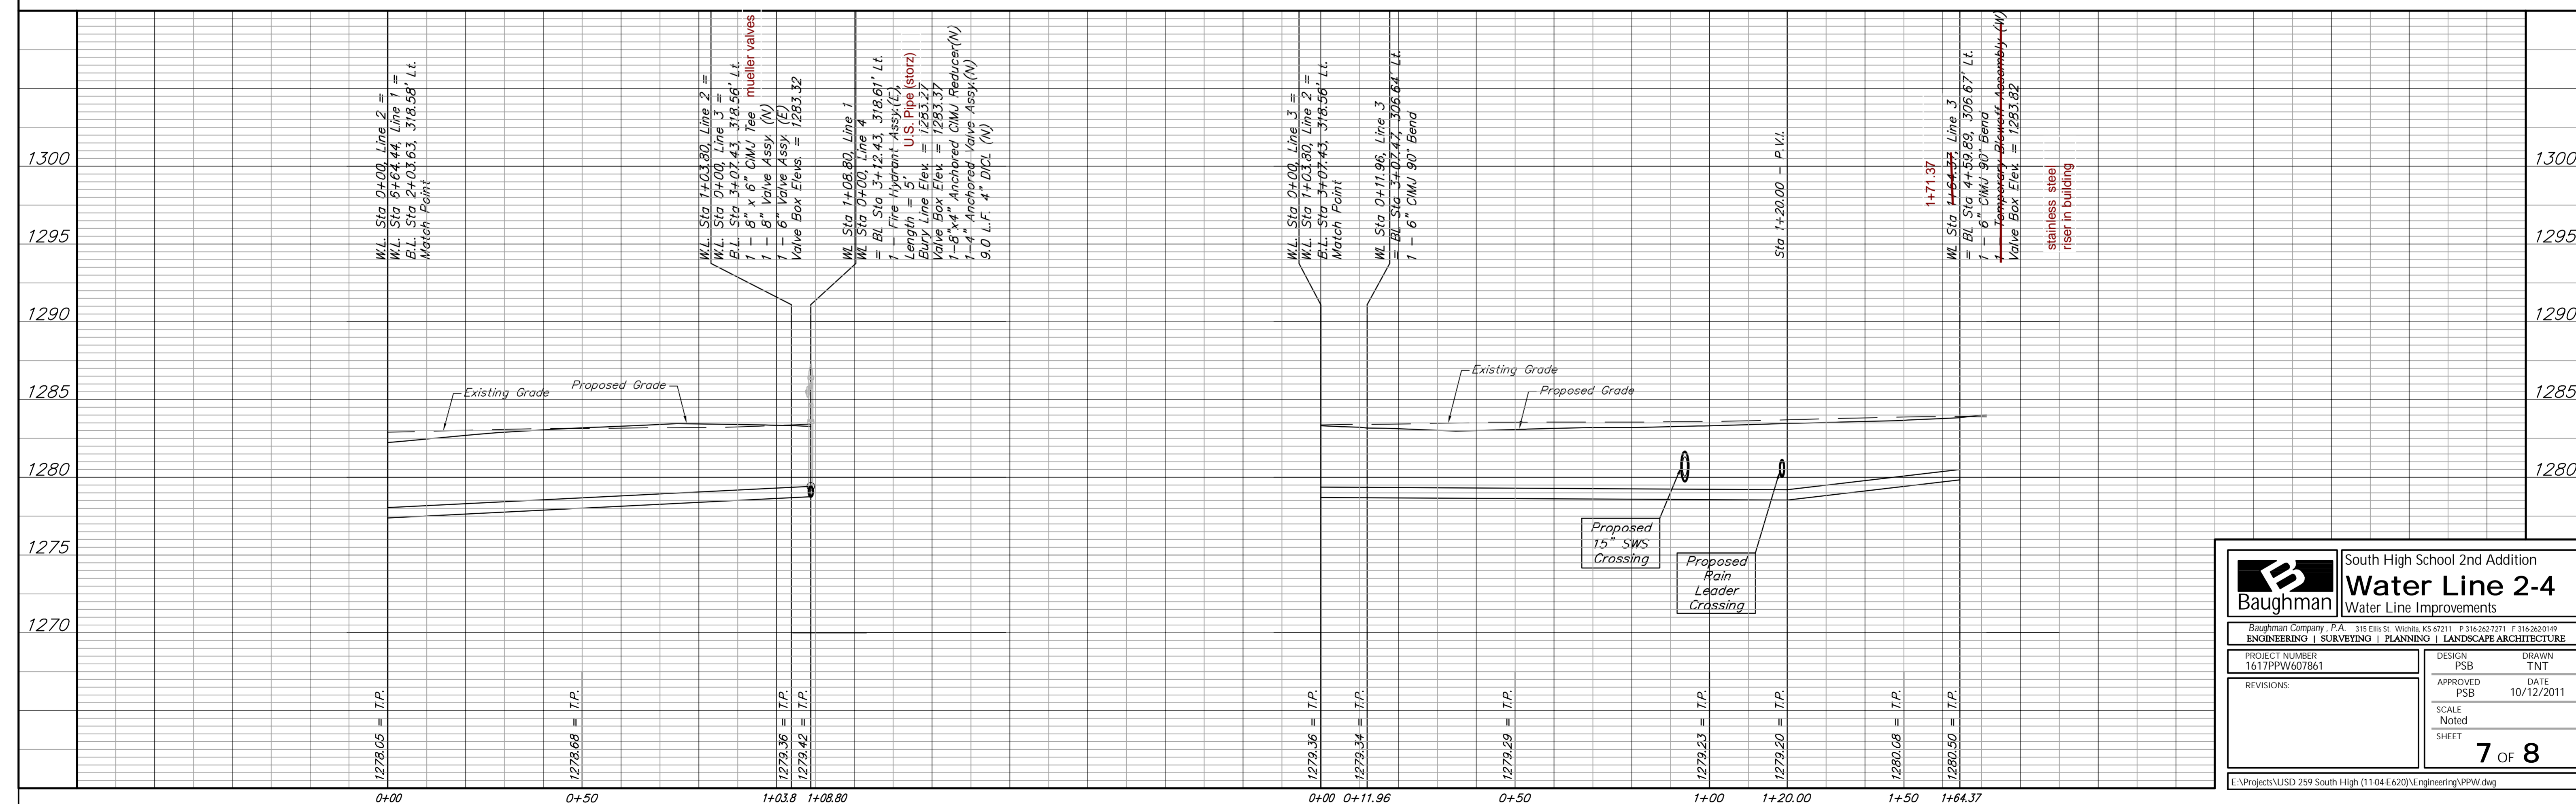

		South High School 2nd Addition Water Line 2-4 Water Line Improvements	
Baughman Company, P.A. 315 Ellis St. Wichita, KS 67211 P 316.262.7271 F 316.262.6149 ENGINEERING SURVEYING PLANNING LANDSCAPE ARCHITECTURE			
PROJECT NUMBER 1617PPW607861	DESIGN PSB	DRAWN TNT	DATE 10/12/2011
APPROVED PSB	SCALE Noted		
REVISIONS:	SHEET 7 OF 8		