AS BUILTS

kemiller engineering

516 S. Market,
Wichita, KS 67202
(316)264-0242

127th St. E. Ct.

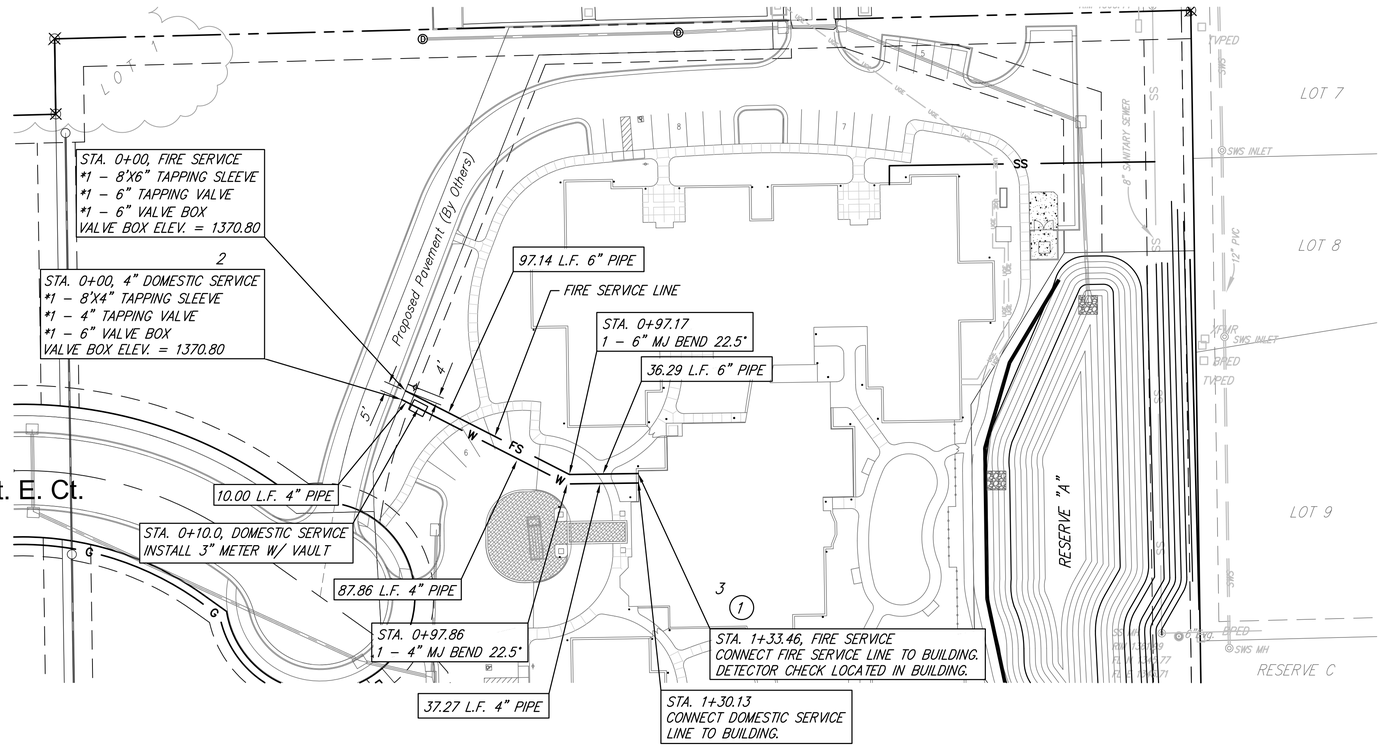

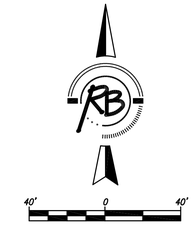

Notes:
Domestic Water Service shall be served by a 3" meter.

Detector check for Fire Service will be located in the building.

City of Wichita Maintenance ends at the easement line for both Fire Service and Domestic Service Lines.

* INSTALLED BY CITY OF WICHITA, COST TO BE REIMBURSED BY CONTRACTOR

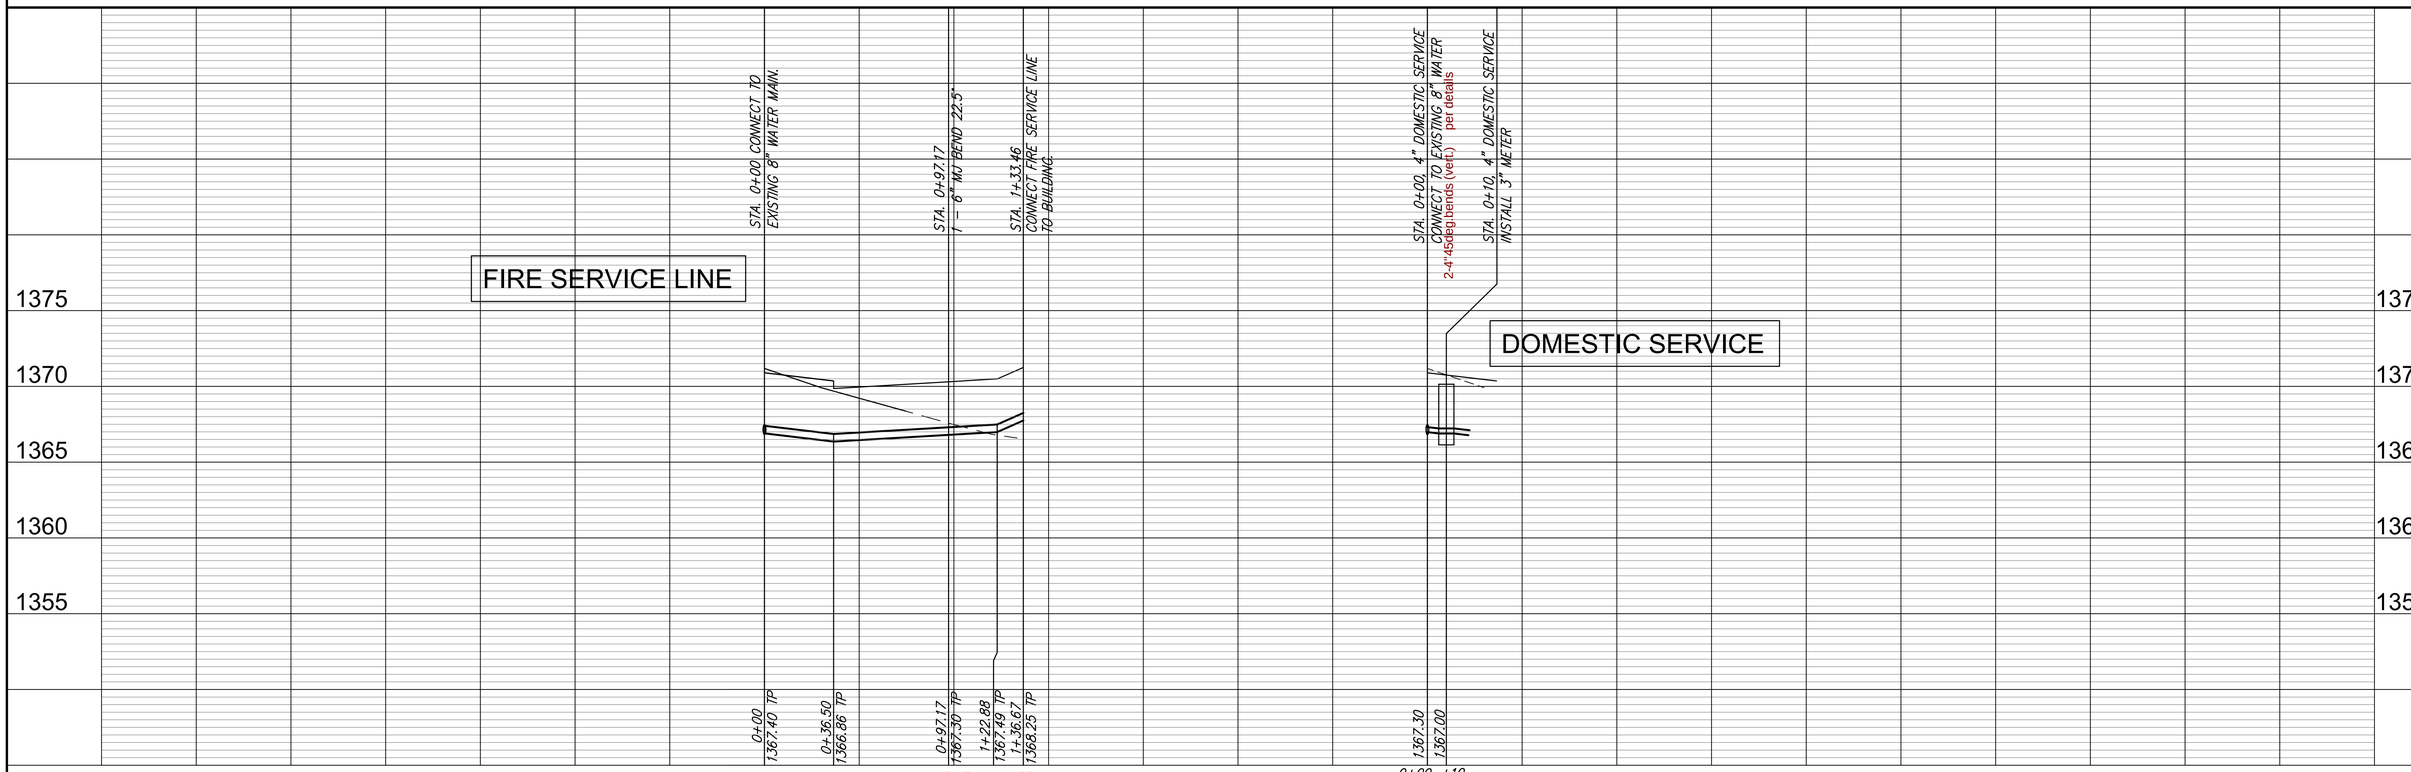

Ruggles & Bohm, P.A.
Engineering, Surveying, Land Planning
634 North Main, Suite 100
Wichita, Kansas 67203
(316) 264-4421
(316) 264-0421 fax
E-mail: info@rbkansas.com
www.rbkansas.com

KENNETH W. LEE
LICENSED
15373
1-26-12
KANSAS
PROFESSIONAL ENGINEER

DESIGN	..
DRAWN	..
REVISED	
UTILITY	
DATE	Jan. 26, 2012
REVIEW	
PROJECT NUMBER	.
DRAWING FILE	.

WATER DISTRIBUTION SYSTEM
DOMESTIC AND FIRE SERVICE LINES
WICHITA, KANSAS

RB JOB 3790E

SHEET 2 of 4