# AS BUILTS

kemiller engineering

516 S. Market,
Wichita, KS 67202

(316)264-0242

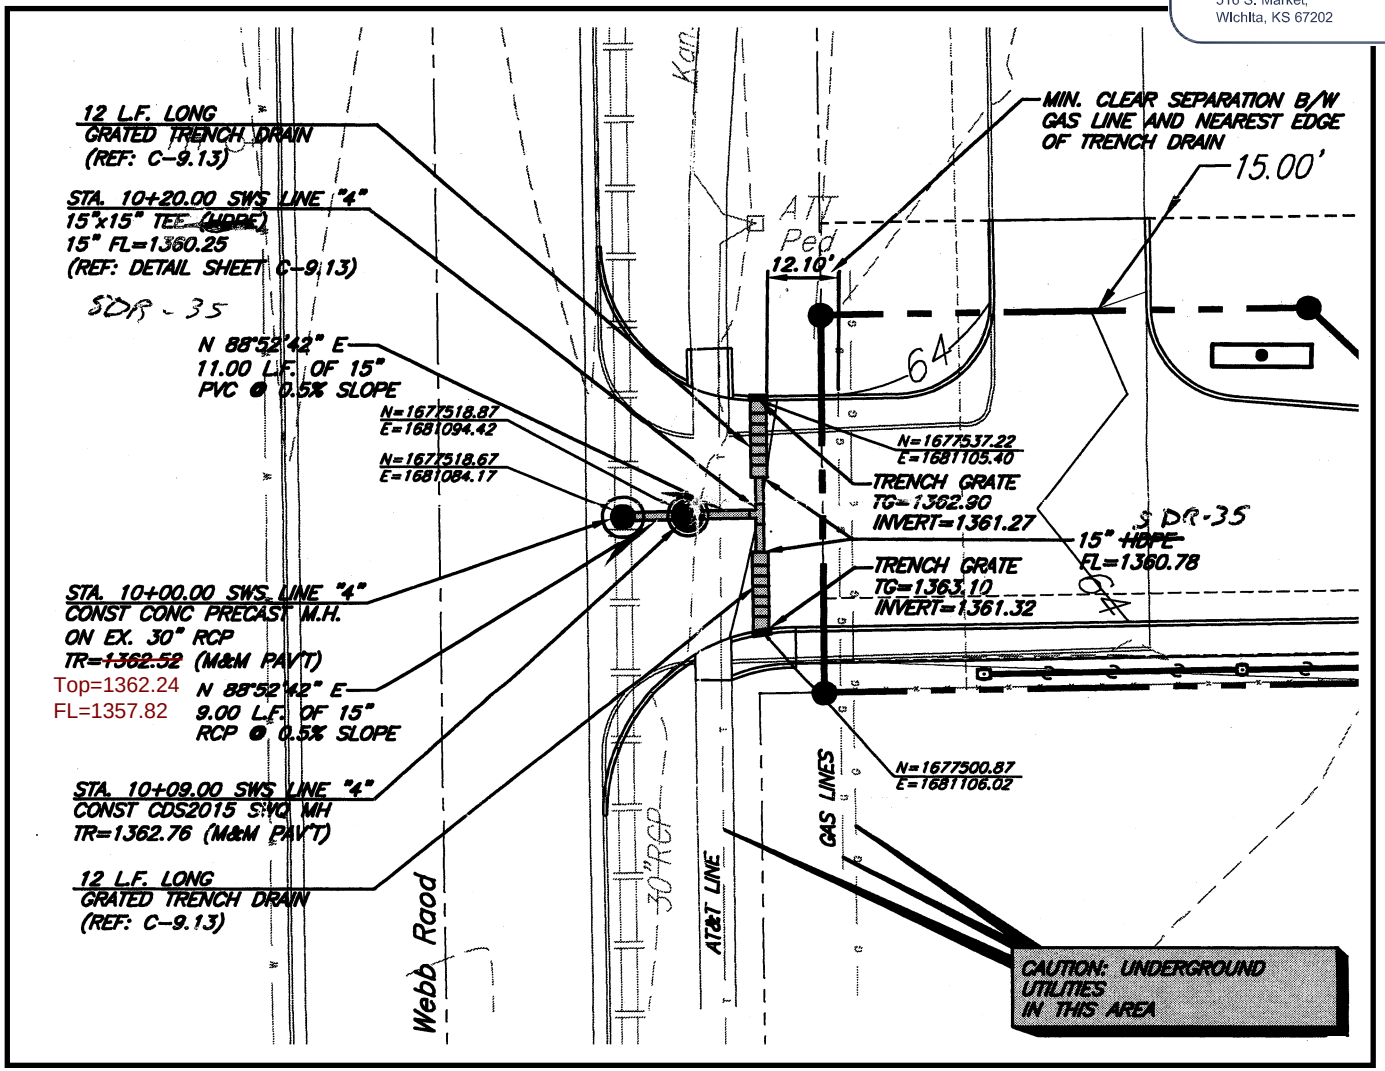


not to scale