AS BUILT PLANS
CONTRACTOR: BRAND PLUMBING
INSPECTOR: RANDY VOTH, C.E.D.
PDF BY: C.C., 11-09-2011

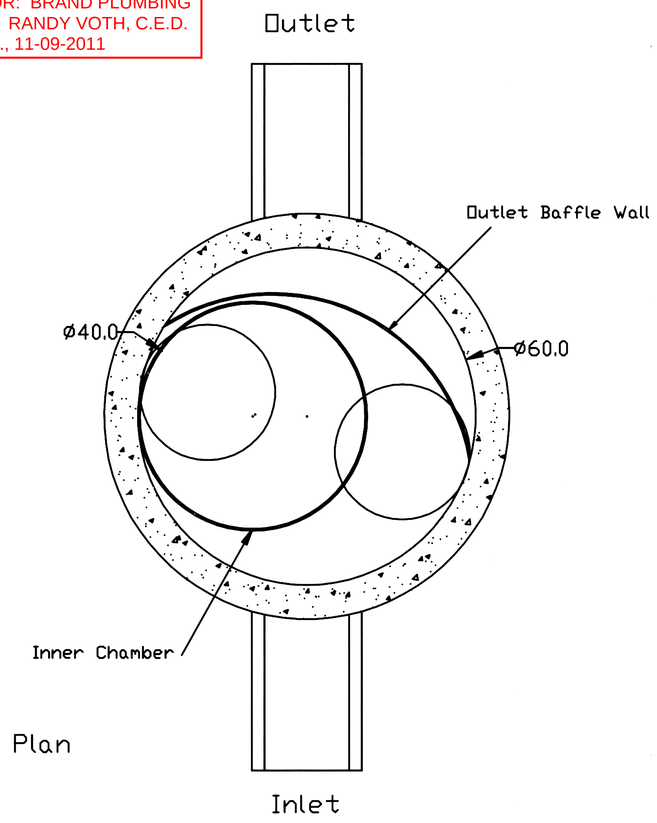

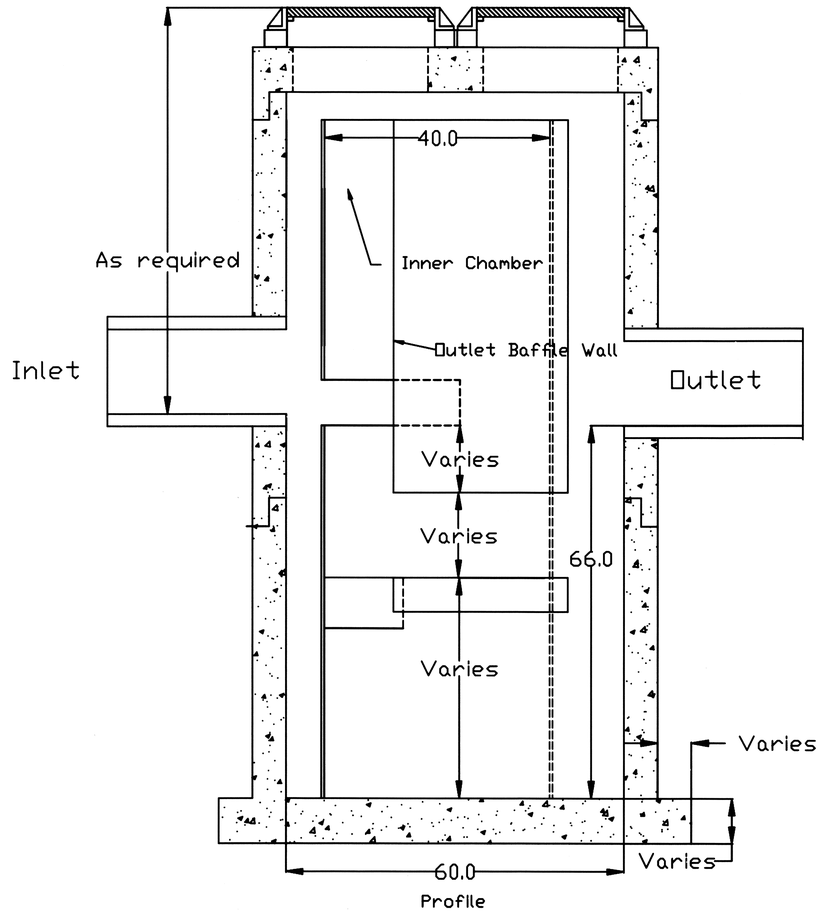

U.S. Patent No. 6,951,619

Dimensions in inches
Permanent Pool Volume = 800 US gallons
The Hydroguard must be cleaned after the construction period if it is used as a sediment and erosion control measure
The Hydroguard should be inspected once per year for stabilized sites
Inspection will determine the maintenance frequency (annual maintenance or once every two years typical for stabilized sites)
Sites with unstable conditions (exposed soil or materials storage) will require more frequent inspection and maintenance

Hydroworks, LLC
50 S. 21st St., Kenilworth, NJ 07033
Phone: 888-290-7900 Fax: 888-783-7271
Web: www.hydroworks.com

Hydroworks HG5 (60"Ø)

PROJECT:

LOCATION:

REVISION DATE: 02/10/2011

Hydroworks