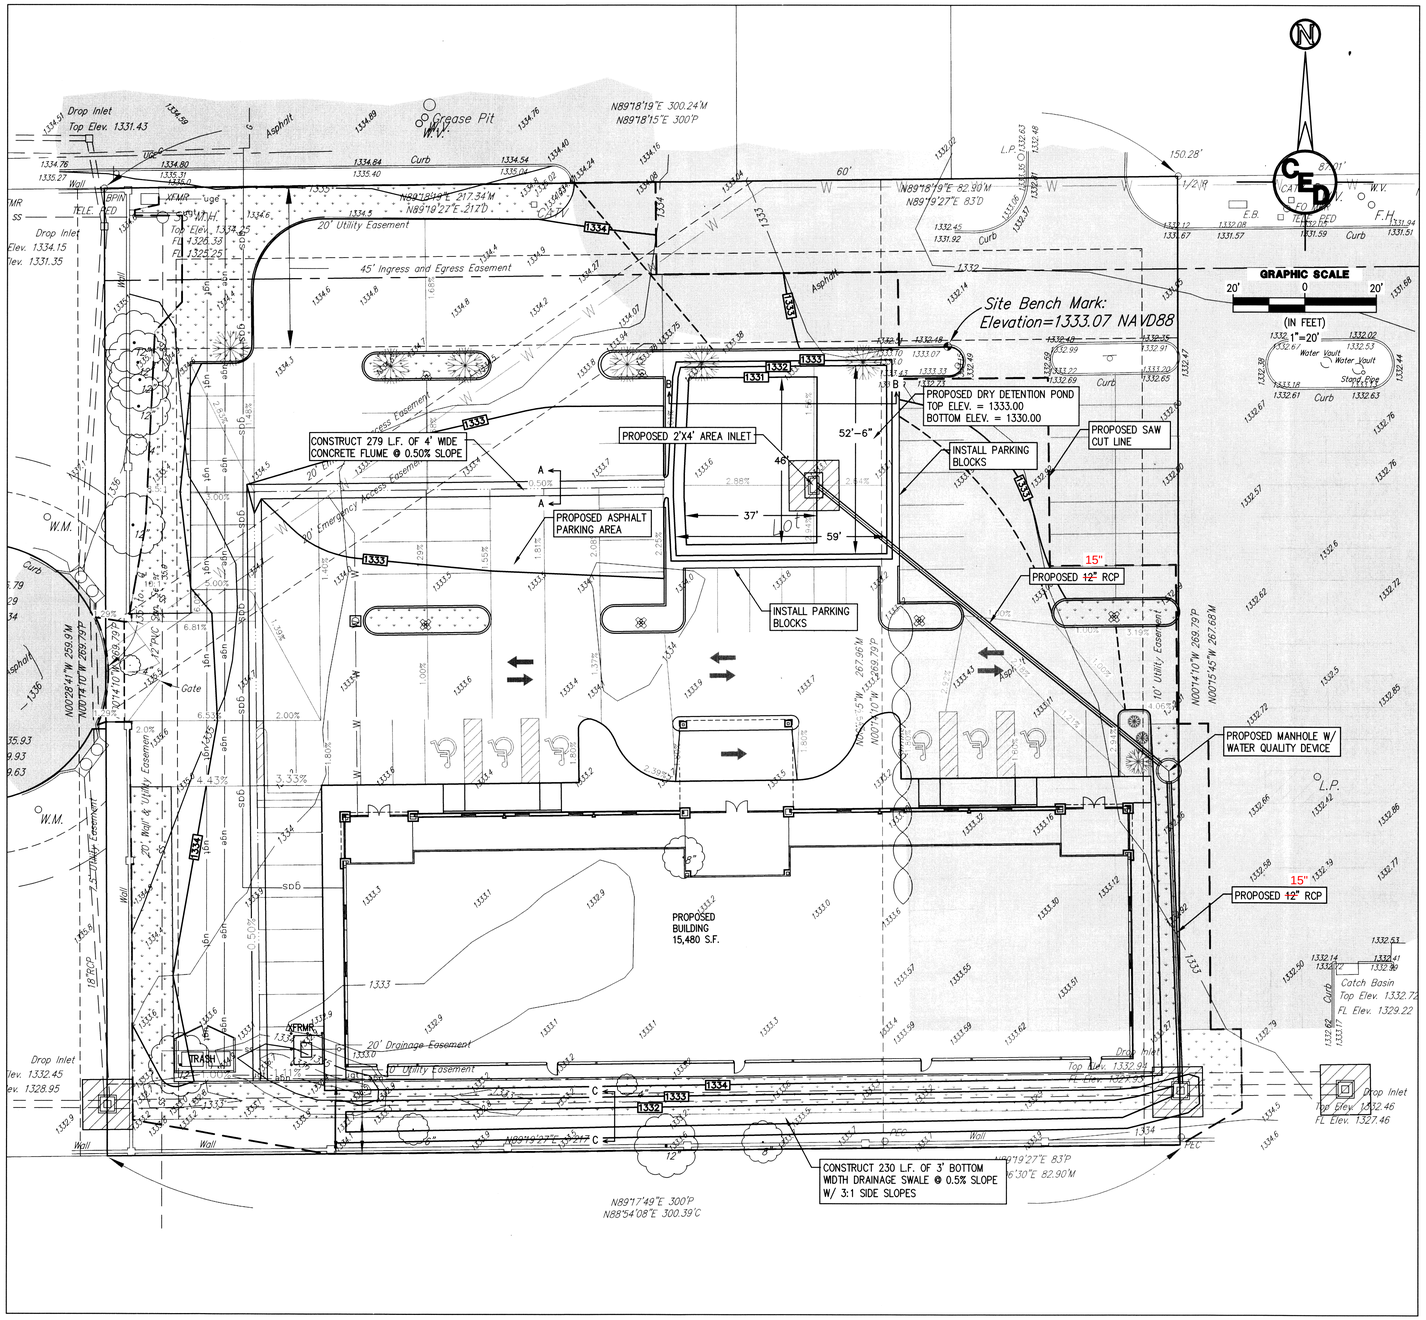

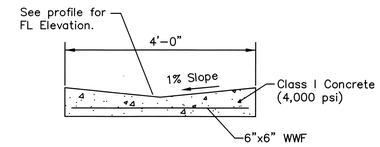

A–A: FLUME DETAIL
(No Scale)

B–B: DRY DETENTION POND DETAIL
(No Scale)

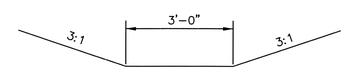

C–C: DRAINAGE SWALE DETAIL
(No Scale)

AS BUILT PLANS
CONTRACTOR: BRAND PLUMBING
INSPECTOR: RANDY VOTH, C.E.D.
PDF BY: C.C., 11-09-2011

ONE CALL
KANSAS
KS: 1-800-344-7233
WICHITA: 316-687-2470

REV.	DESCRIPTION	DATE

NEW MEDICAL CENTER
21ST & RIDGE ROAD
WICHITA, KS

CERTIFIED ENGINEERING DESIGN, P.A.
CIVIL ENGINEERING SERVICES
1935 WEST MAPLE STREET
WICHITA, KANSAS 67213
PH.(316)262-8808 FAX.(316)262-1669

HARLAN DALE FORAKER
LICENSED
10891
KANSAS
PROFESSIONAL ENGINEER

ISSUED FOR CONSTRUCTION

PROJECT NO.: 20111951
ISSUE DATE: 03/01/11
CONTACT: H. FORAKER
CHECKED BY:

SITE PLAN