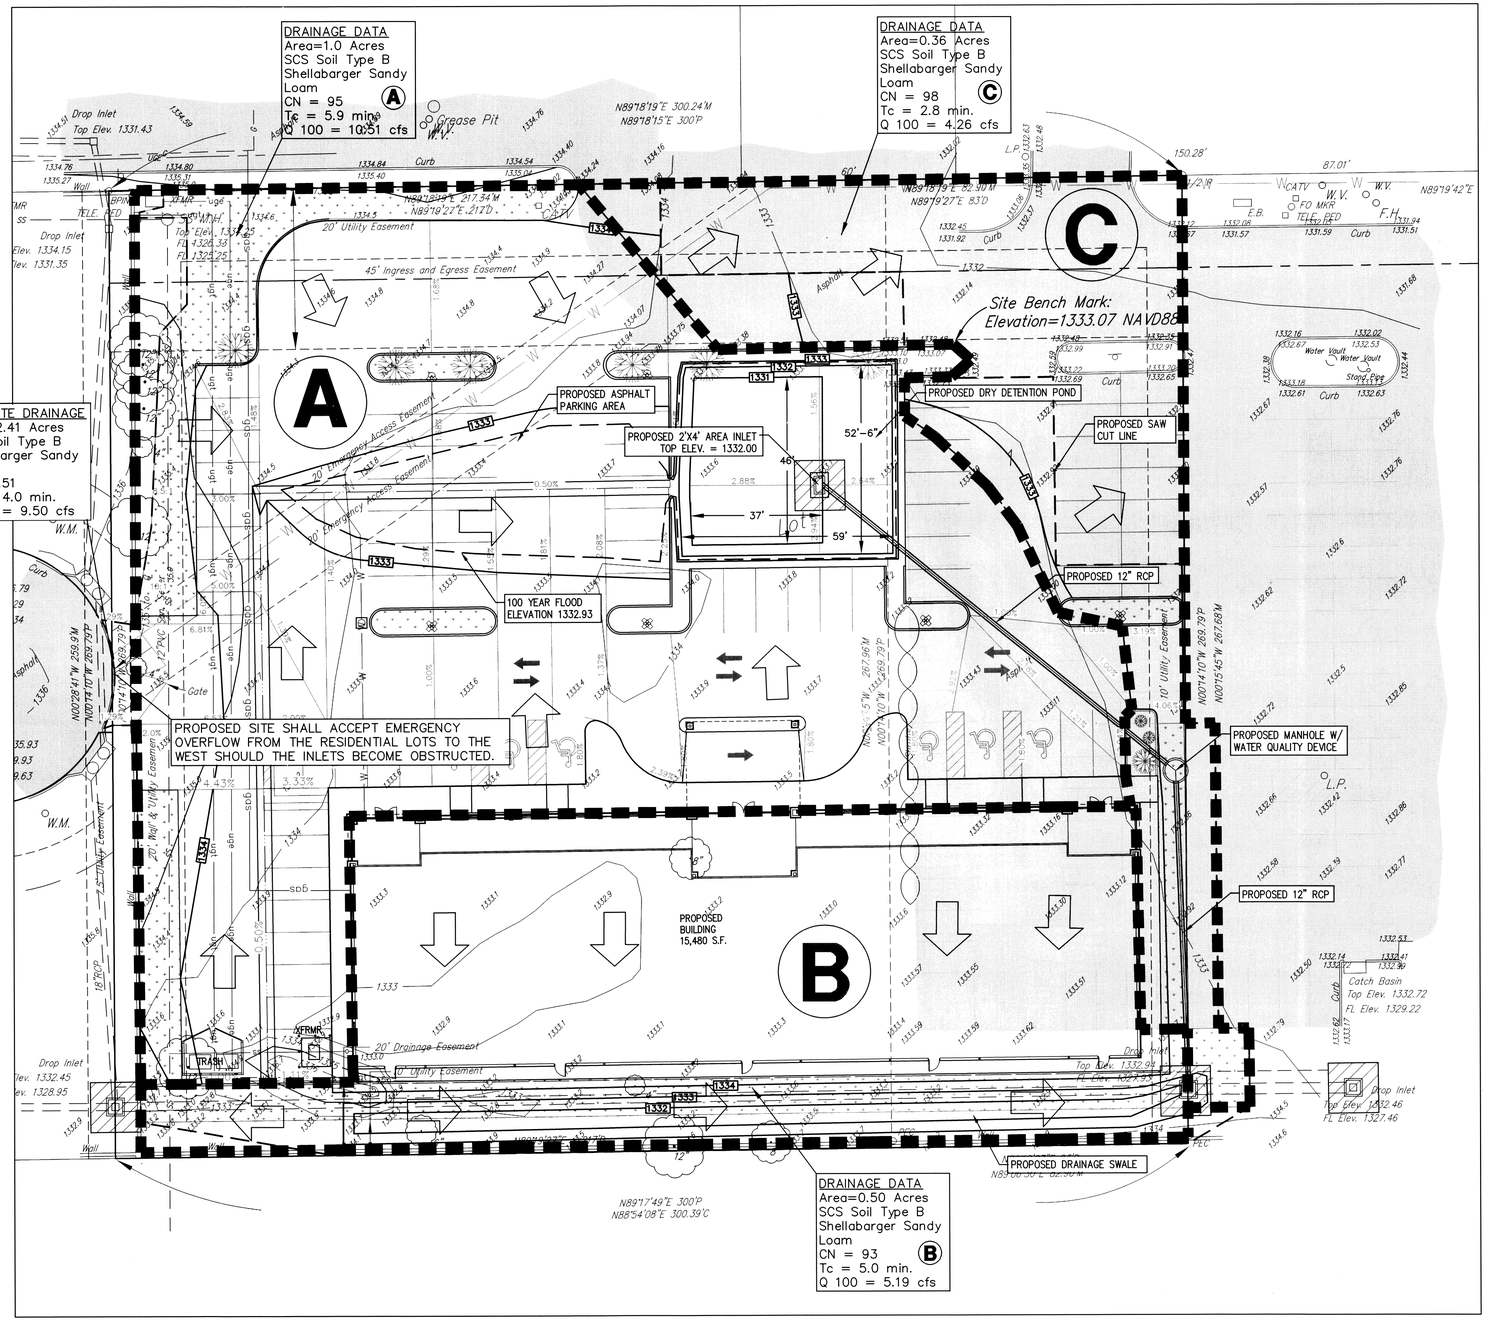

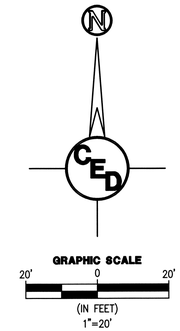

DRAINAGE AREA MAP LEGEND:

- (A) DRAINAGE AREA MARKER
- DRAINAGE AREA BOUNDARY
- DRAINAGE ARROW

AS BUILT PLANS
CONTRACTOR: BRAND PLUMBING
INSPECTOR: RANDY VOTH, C.E.D.
PDF BY: C.C., 11-09-2011

ONE CALL KANSAS
KS: 1-800-344-7233
WICHITA: 316-687-2470

REV.	DESCRIPTION	DATE

NEW MEDICAL CENTER
21ST & RIDGE ROAD
WICHITA, KS

CERTIFIED ENGINEERING DESIGN, P.A.
CIVIL ENGINEERING SERVICES
1935 WEST MAPLE STREET
WICHITA, KANSAS 67213
PH.(316)262-8808 FAX.(316)262-1669

HARLAN DALE FORAKER LICENSED 10891 KANSAS PROFESSIONAL ENGINEER
4-28-11

ISSUED FOR CONSTRUCTION

PROJECT NO.: 20111951
ISSUE DATE: 03/01/11
CONTACT: H. FORAKER
CHECKED BY:

POST DEVELOPMENT MAP