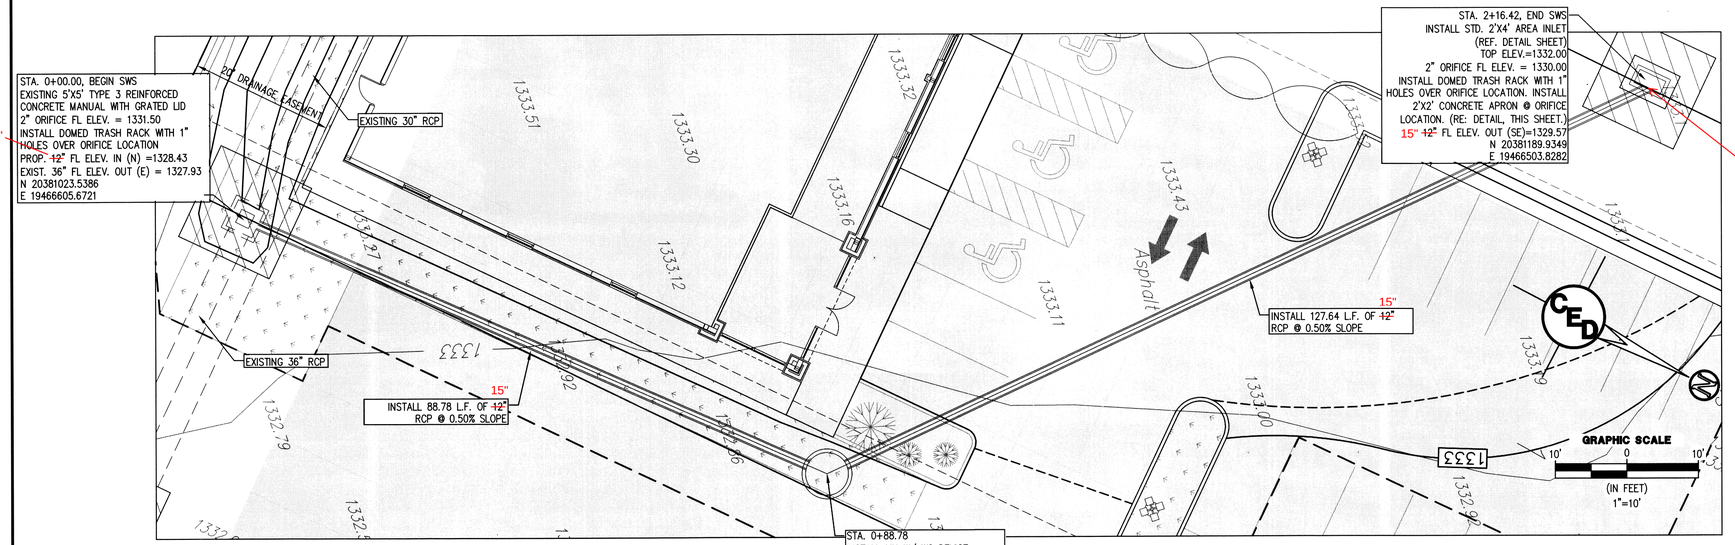


AS BUILT PLANS
CONTRACTOR: BRAND PLUMBING
INSPECTOR: RANDY VOTH, C.E.D.
PDF BY: C.C., 11-09-2011

INSTALLED A RESTRICTER PLATE ON 15" RCP

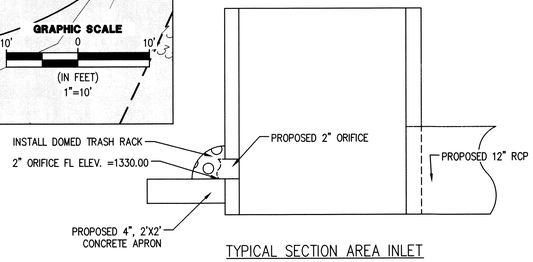


TYPICAL SECTION AREA INLET WITH 2" ORIFICE
(NOT TO SCALE)

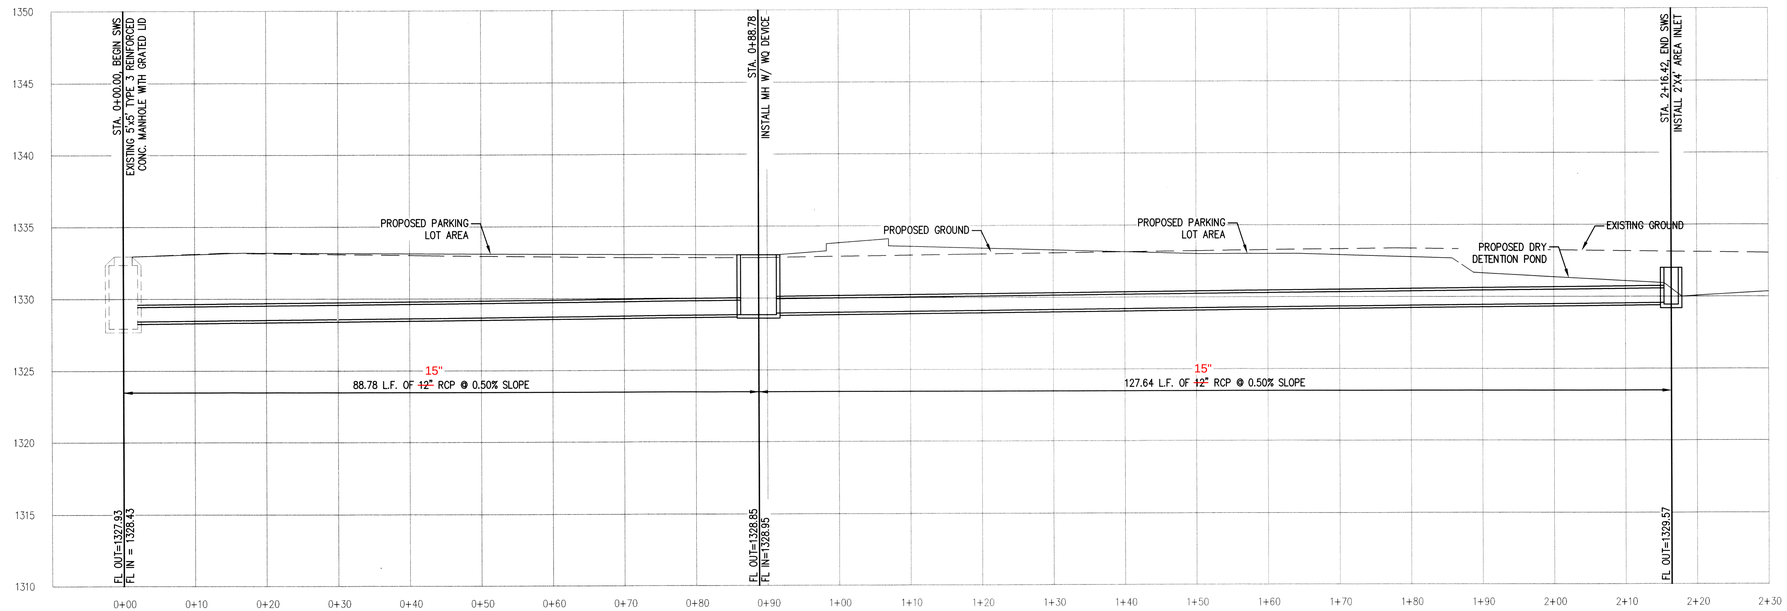


| REV. | DESCRIPTION | DATE |
|---|---|---|
| | | |

NEW MEDICAL CENTER
21ST & RIDGE ROAD
WICHITA, KS


CERTIFIED ENGINEERING DESIGN, P.A.
CIVIL ENGINEERING SERVICES
1935 WEST MAPLE STREET
WICHITA, KANSAS 67213
PH.(316)262-8808 FAX.(316)262-1669


HARLAN DALE FORAKER LICENSED 10891 KANSAS PROFESSIONAL ENGINEER
4-28-11

ISSUED FOR CONSTRUCTION

PROJECT NO.: 20111951
ISSUE DATE: 03/01/11
CONTACT: H. FORAKER
CHECKED BY:

**SWS PLAN AND PROFILE**