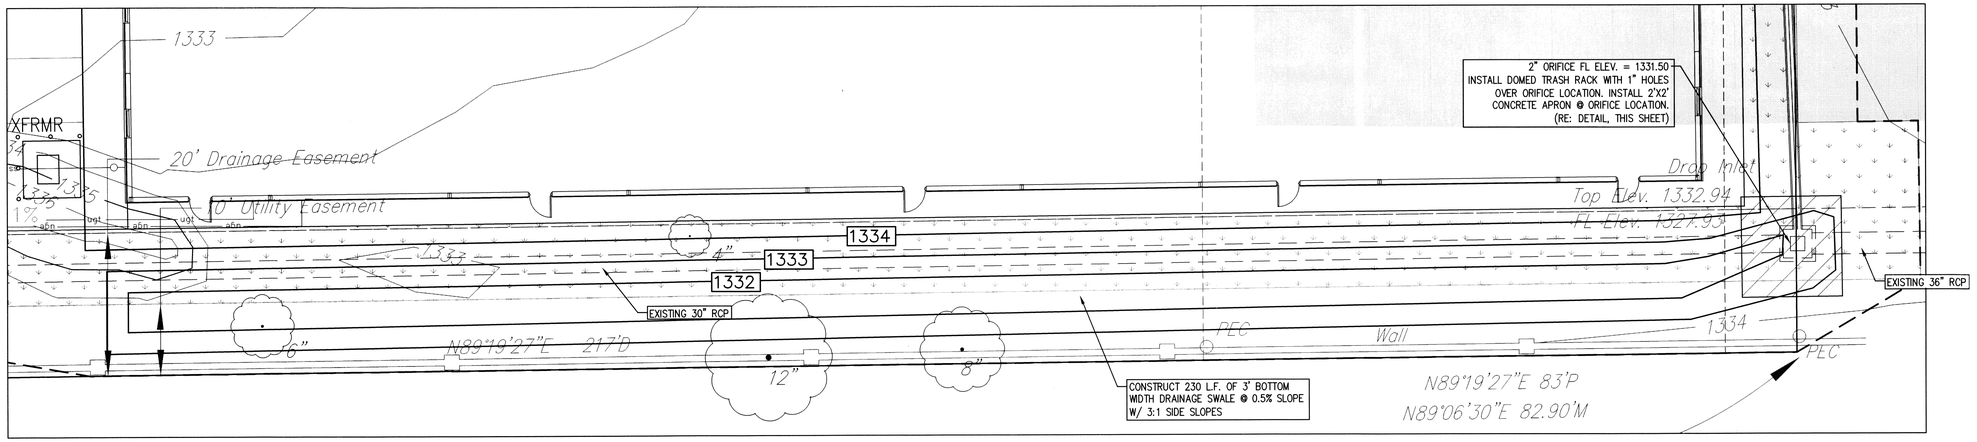

AS BUILT PLANS
CONTRACTOR: BRAND PLUMBING
INSPECTOR: RANDY VOTH, C.E.D.
PDF BY: C.C., 11-09-2011

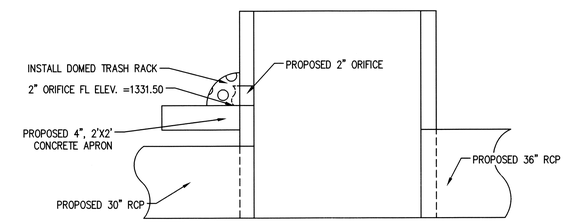

TYPICAL SECTION AREA INLET
WITH 2" ORIFICE

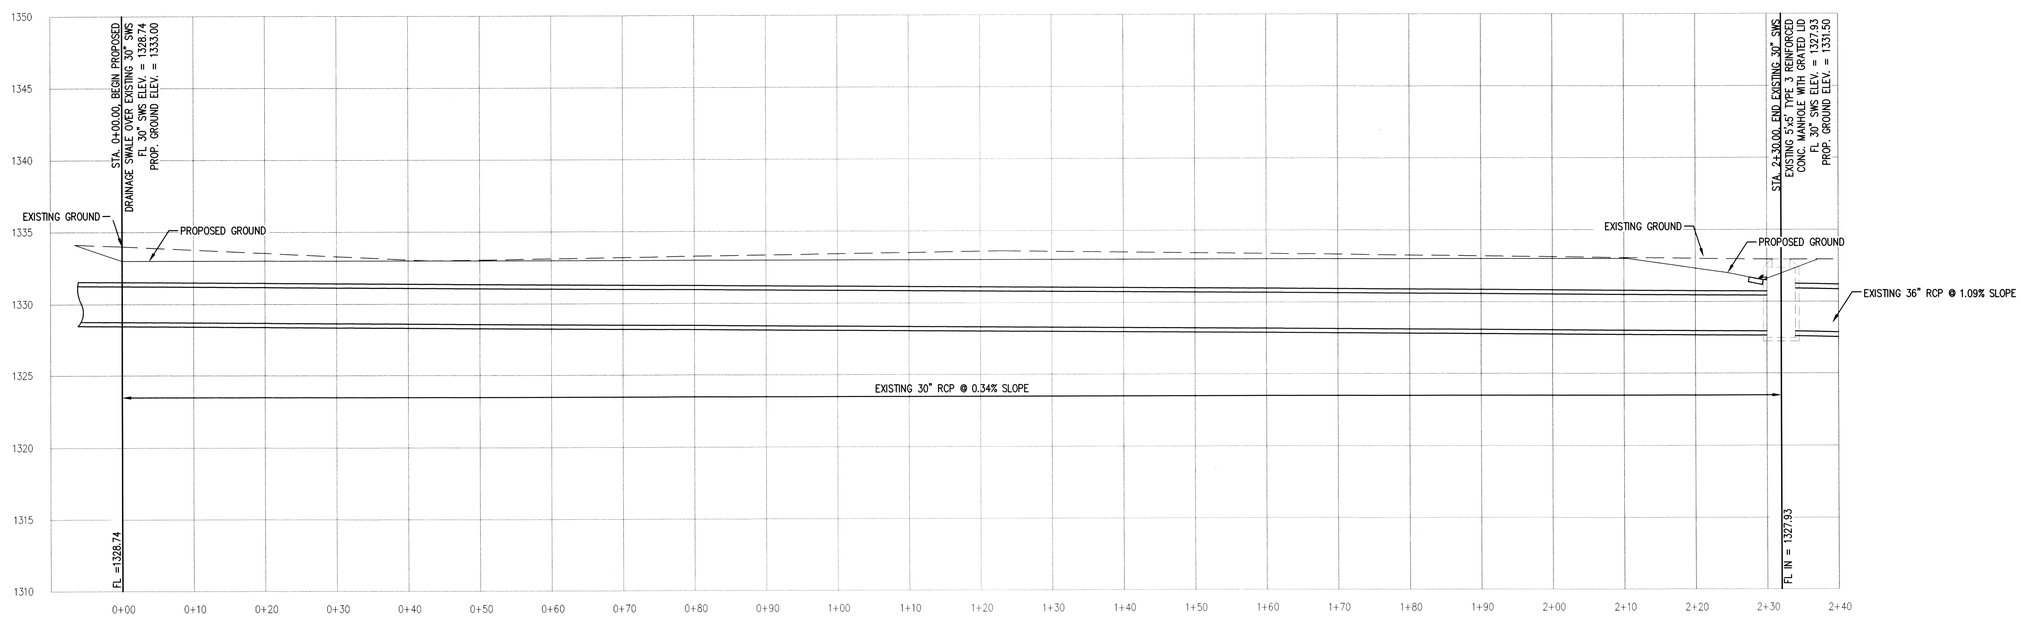

REV.	DESCRIPTION	DATE

GRAPHIC SCALE
10' 0 10'
(IN FEET)
1"=10'

NEW MEDICAL CENTER
21ST & RIDGE ROAD
WICHITA, KS

CERTIFIED ENGINEERING DESIGN, P.A.
CIVIL ENGINEERING SERVICES
1935 WEST MAPLE STREET
WICHITA, KANSAS 67213
PH.(316)262-8808 FAX.(316)262-1669

HARLAN DALE FORAKER
LICENSED
10891
KANSAS
PROFESSIONAL ENGINEER
4-28-11

ISSUED FOR CONSTRUCTION

PROJECT NO.: 20111951
ISSUE DATE: 03/01/11
CONTAOT: H. FORAKER
CHECKED BY:

DRAINAGE SWALE PLAN AND PROFILE