

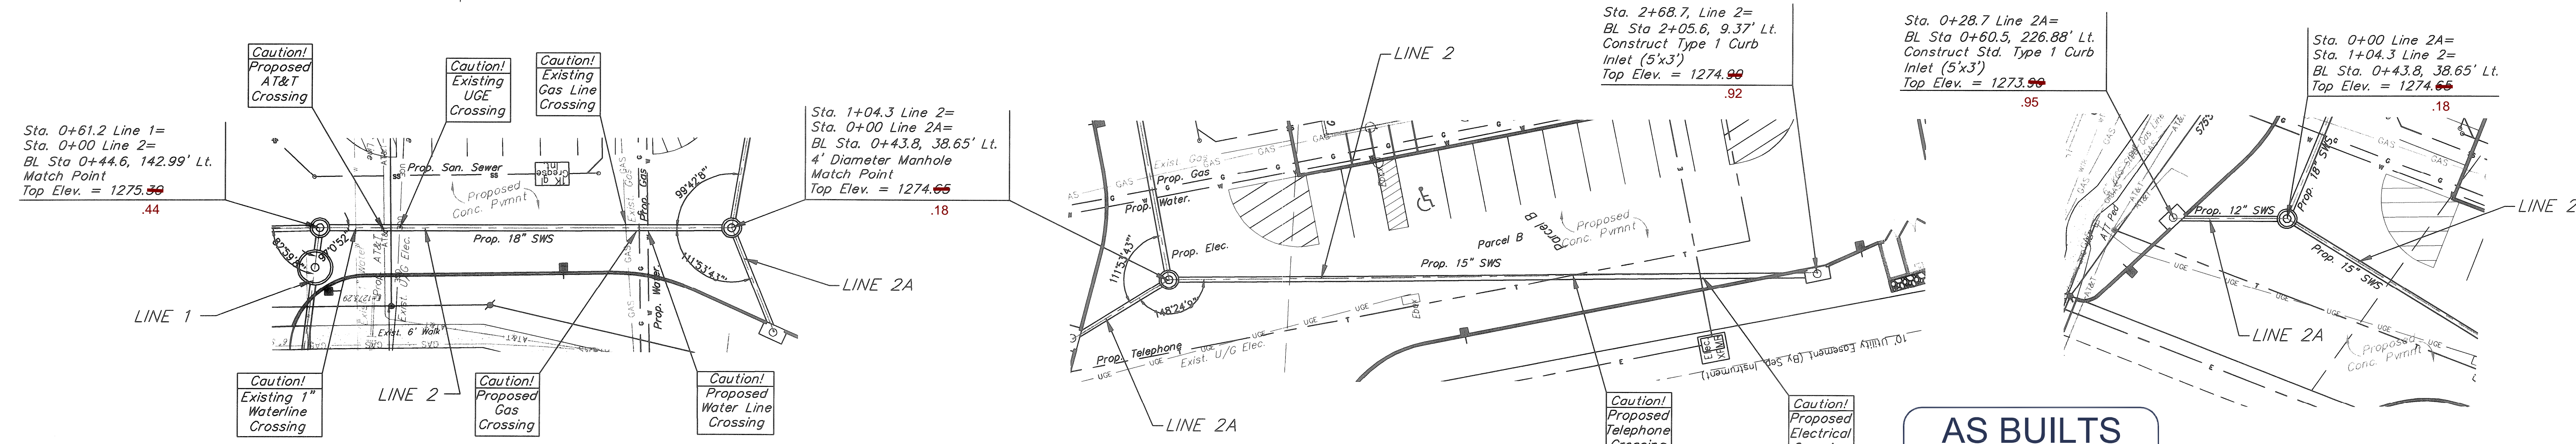
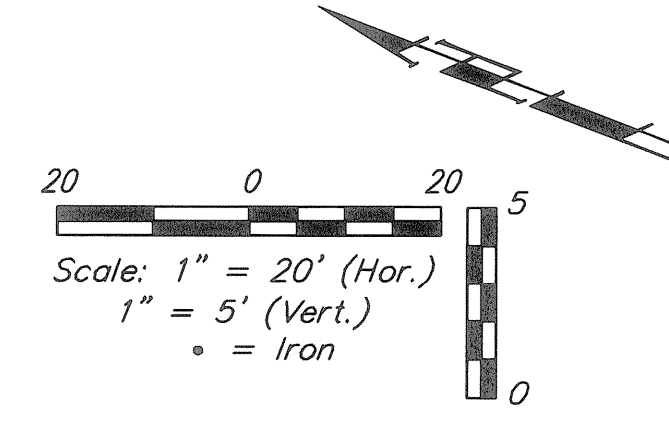
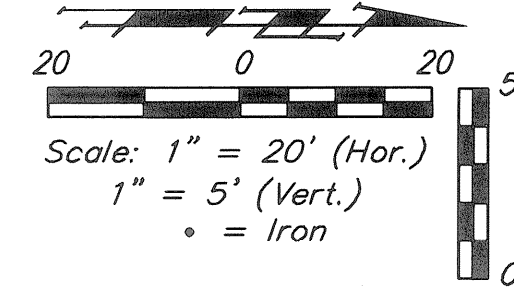
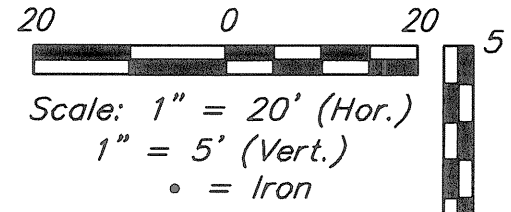
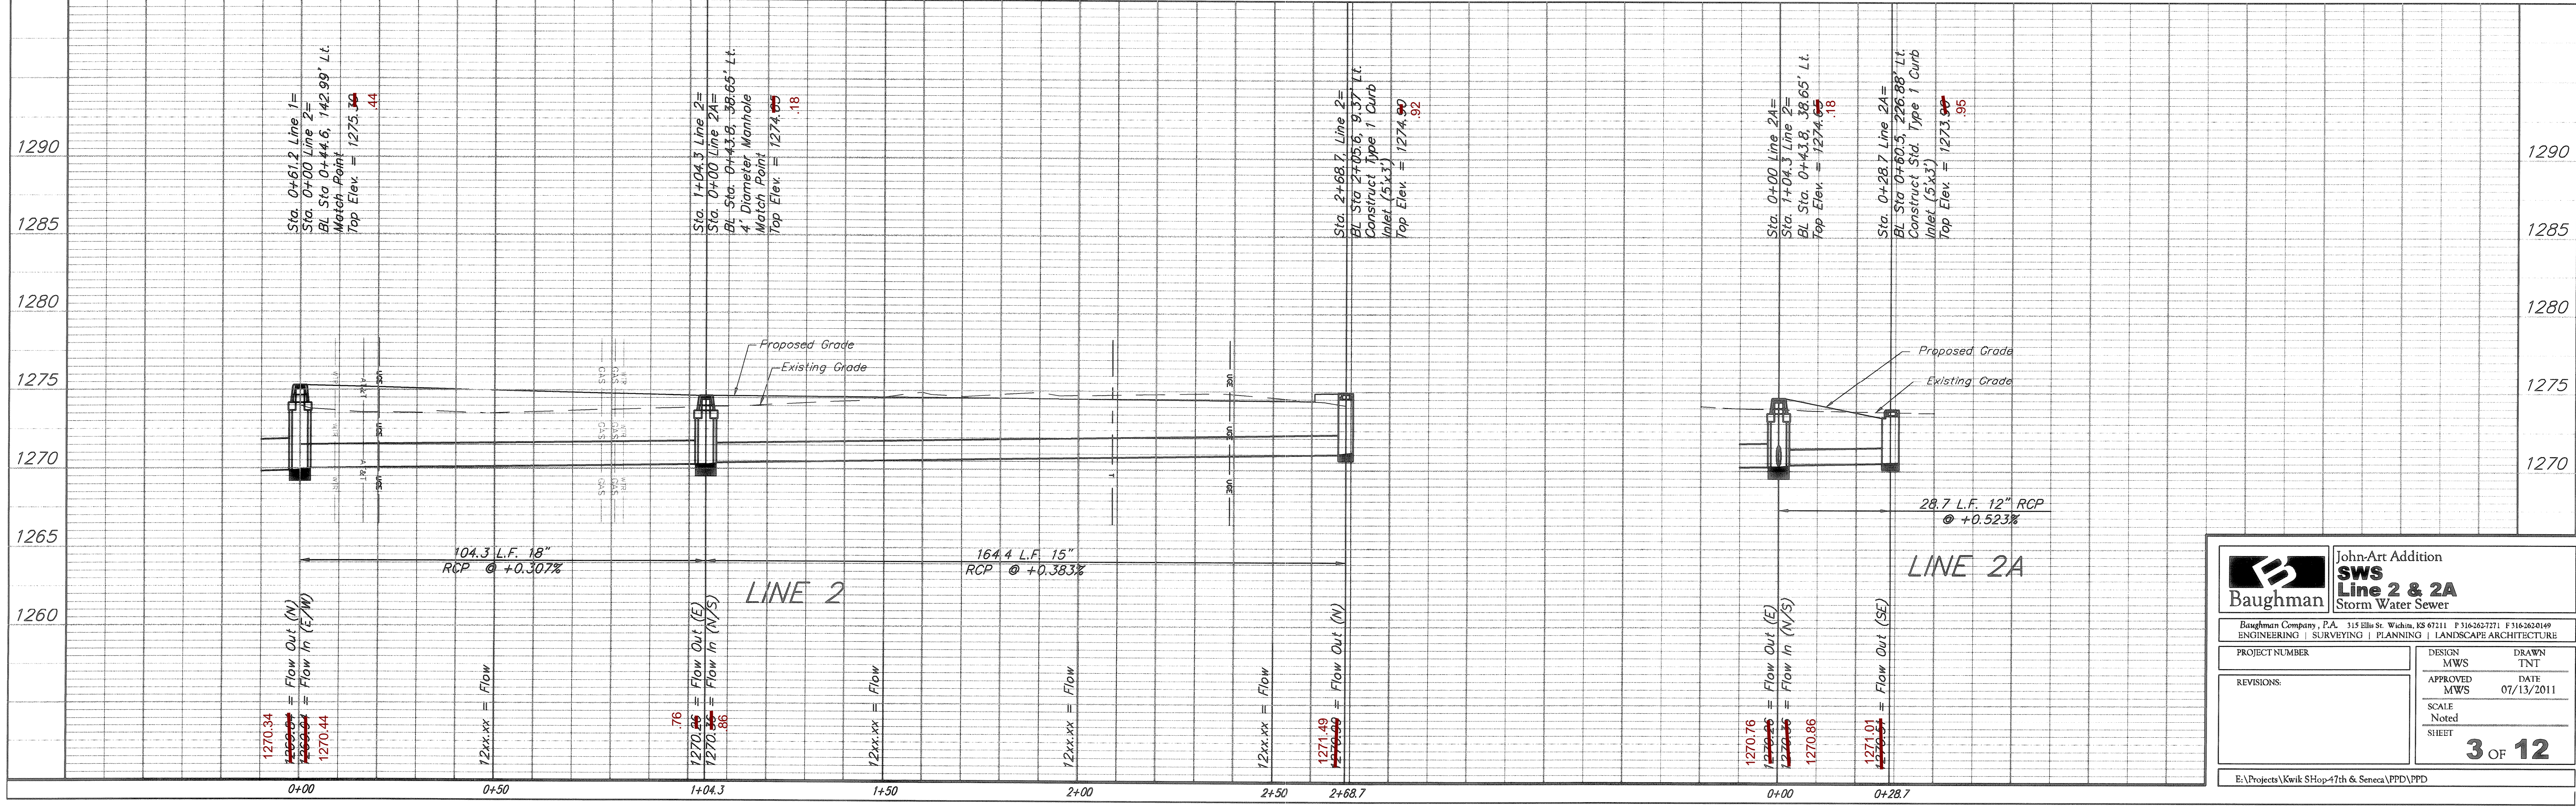
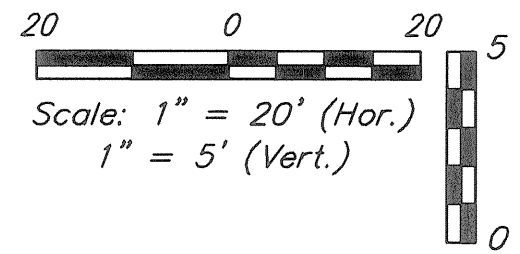


Benchmark - 1:
City of Wichita Benchmark, 74' North and 44' East
of Centerline of 47th and Seneca at Face of Walk.
Elevation = 1275.17 (NAVD 88)

Site Benchmark - 1:
Cross Cut on top of Sidewalk.
Elevation = 1275.72 (NAVD 88)

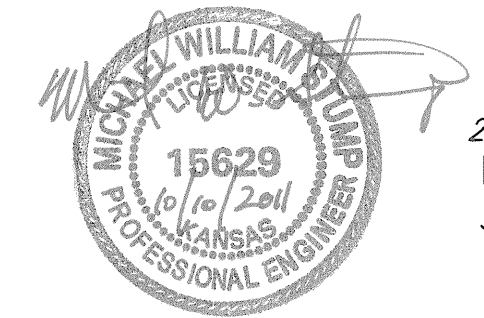

Baseline Sta 0+00 =
Northwest corner of Property
Line Lot 49 of John-Art
Addition Wichita, KS.

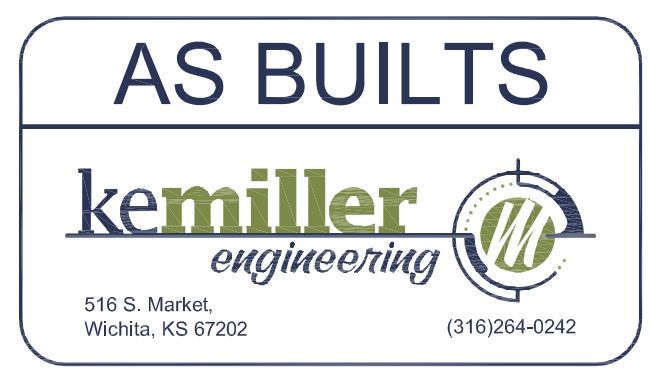

Baughman		John-Art Addition SWS Line 2 & 2A Storm Water Sewer	
Baughman Company, P.A. 315 1/2 S. Wichita, KS 67211 F 316-263-7271 F 316-263-8149 ENGINEERING SURVEYING PLANNING LANDSCAPE ARCHITECTURE			
PROJECT NUMBER	DESIGN MWS	DRAWN TNT	
REVISIONS:	APPROVED MWS	DATE 07/13/2011	
SCALE Noted		SHEET 3 OF 12	
E:\Projects\Kwik SHop\47th & Seneca\PPD\PPD			