

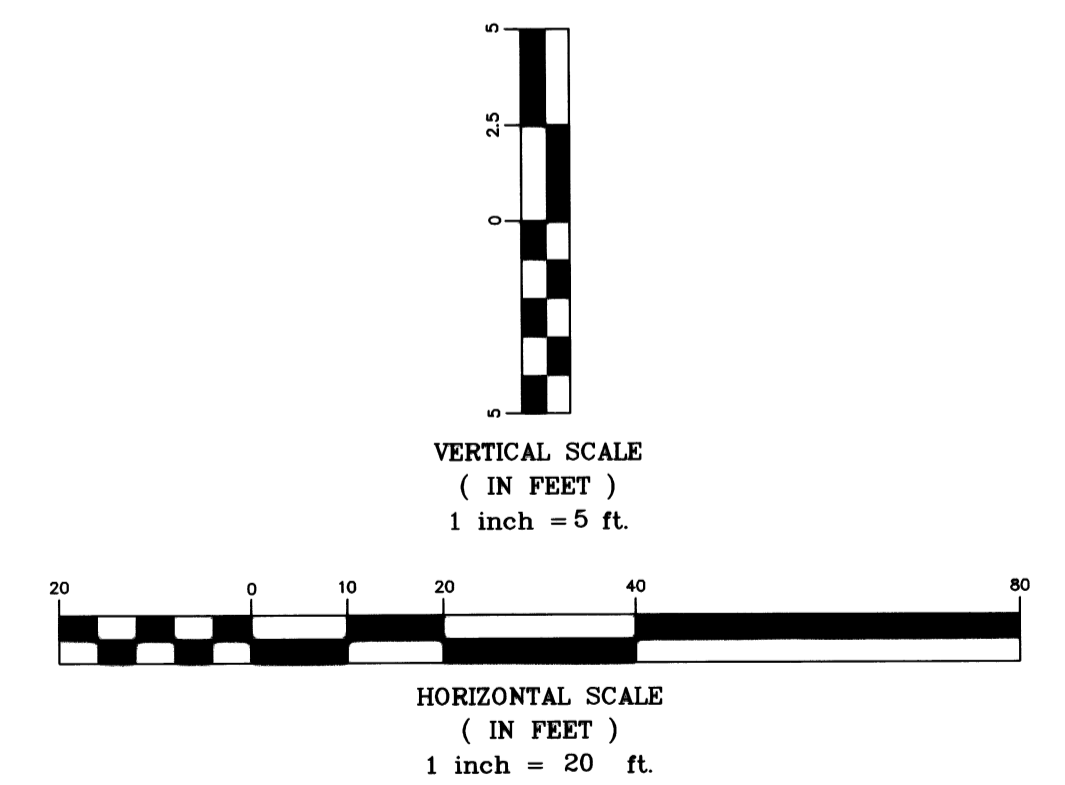


General Notes:

1. Field Verify depth of sanitary sewer crossing. If possible maintain 2.0 feet minimum clearance between sanitary sewer and water line. If not possible incase existing sanitary sewer to a minimum of 10.0 feet either side of crossing.

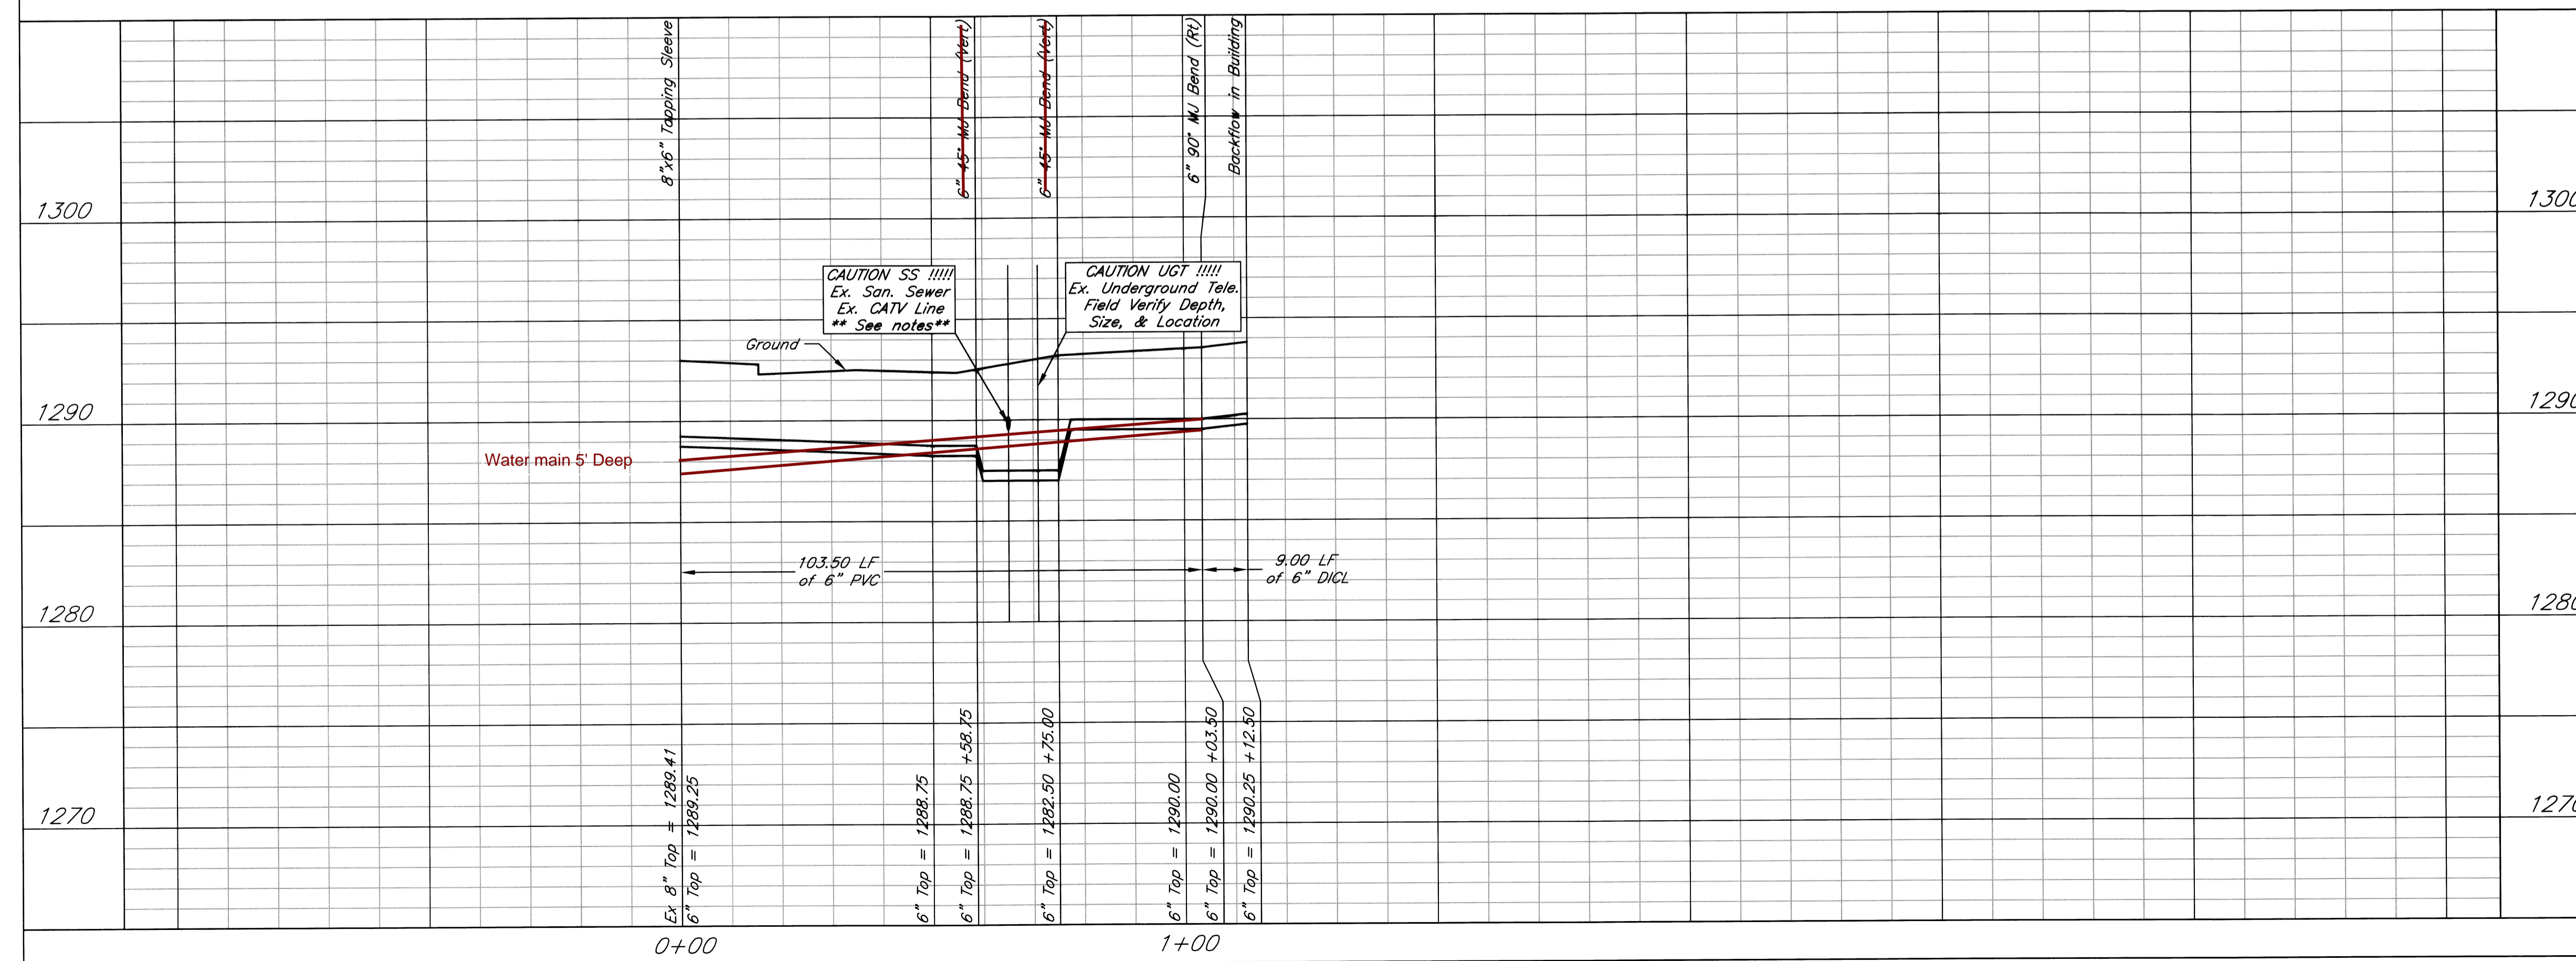

LTS Warehouse
Water Line
Wichita, Kansas

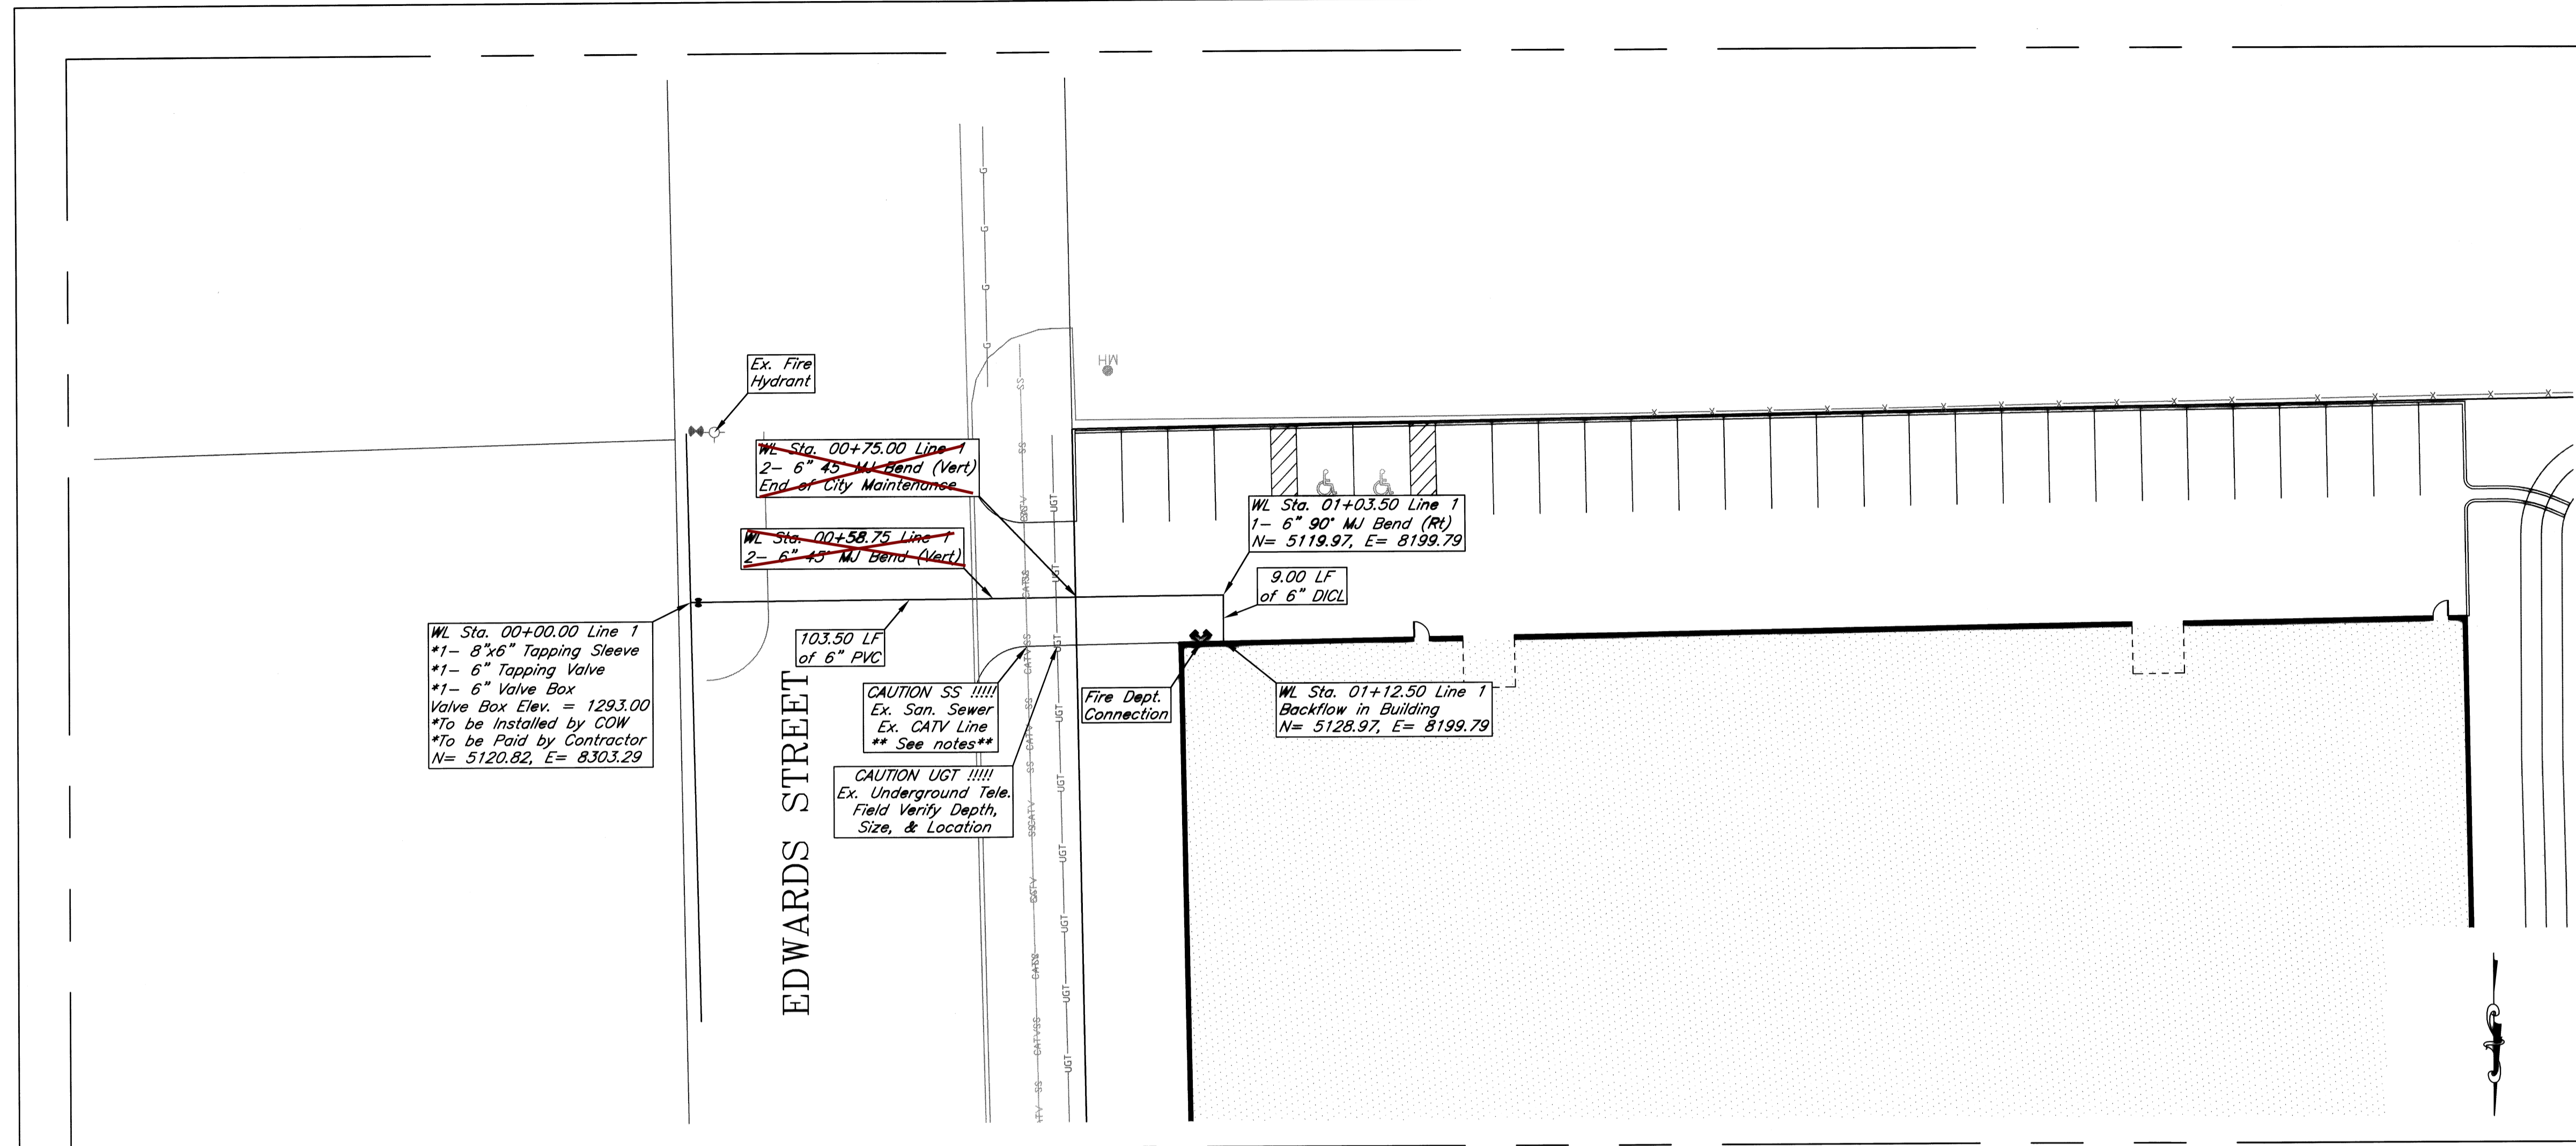

PROJECT NUMBER			
KEM NO. 11095	FILE	DATE 09/13/11	SHEET 2.0
DESIGN KM	DRAWN NS	REVISED	

516 S. Market, Wichita, KS 67202 (316)264-0242