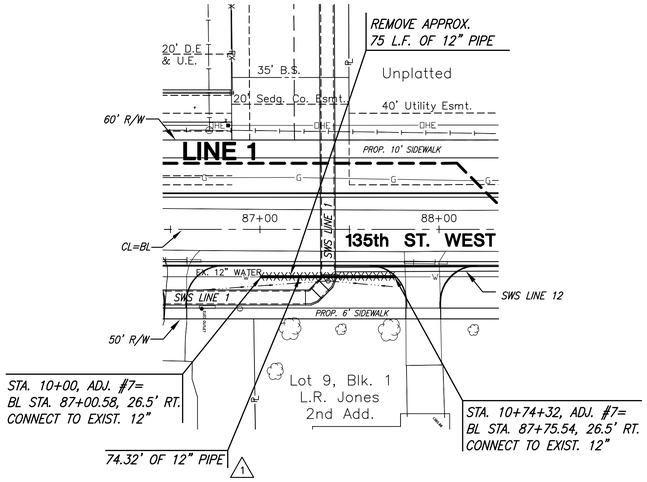

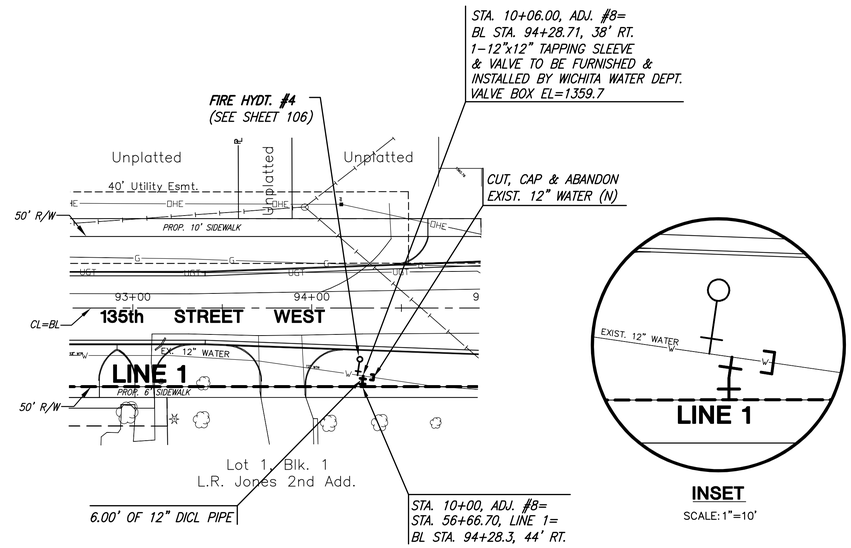

LEGEND

XXXXXXX — REMOVE EXIST. 12" WATER LINE.

NOTE:
CONTRACTOR TO VERIFY LOCATION OF EXISTING WATER LINES AND ALL OTHER UTILITIES PRIOR TO CONSTRUCTION.

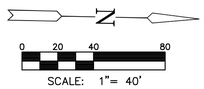

PLAN
ADJUSTMENT #7

PROFILE
SCALE: HORIZ. 1"=40'
SCALE: VERT. 1"=5'

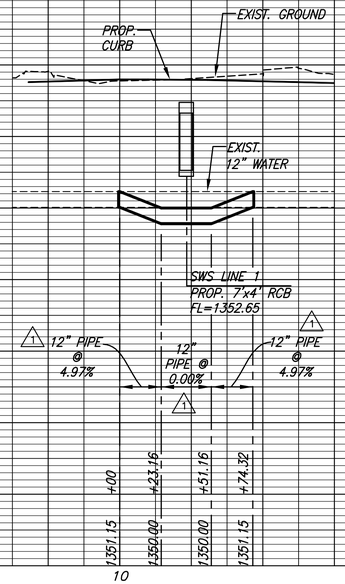

PLAN
ADJUSTMENT #8

PROFILE
SCALE: HORIZ. 1"=40'
SCALE: VERT. 1"=5'

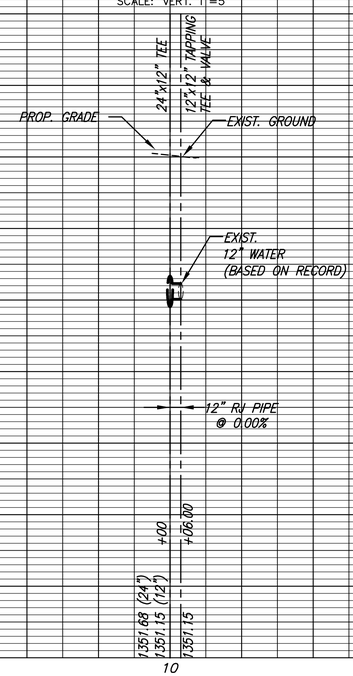

MKEC ENGINEERING CONSULTANTS, INC.
411 N. WEBB ROAD
WICHITA, KS. 67206
316 - 684 - 9600

JAY ANDLEY — LICENSED — No. 23288 — PROFESSIONAL ENGINEER — KANSAS

STREET IMPROVEMENTS FOR
135th Street West
from 13th Street to 21st Street North

12" WATERLINE ADJUSTMENTS #7 - #8
SHEET TITLE

MKEC PROJ #10265
PROJECT NUMBER

JRA — DESIGN BY
KKL — DRAWN BY
JRA — CHECKED BY

ISSUED: February 2012

REVISED
1 — Changed Pipe Callouts from "12" DICL PIPE" to "12" PIPE"

SHEET NO.
104R of 231

PLOTTED: Monday, March 12, 2012 @ 09:12AM
J:\Civil\10265\DWG\WTR\10265_C09 revised
10
10