


SHEET NO.	TOTAL SHEETS
34	36

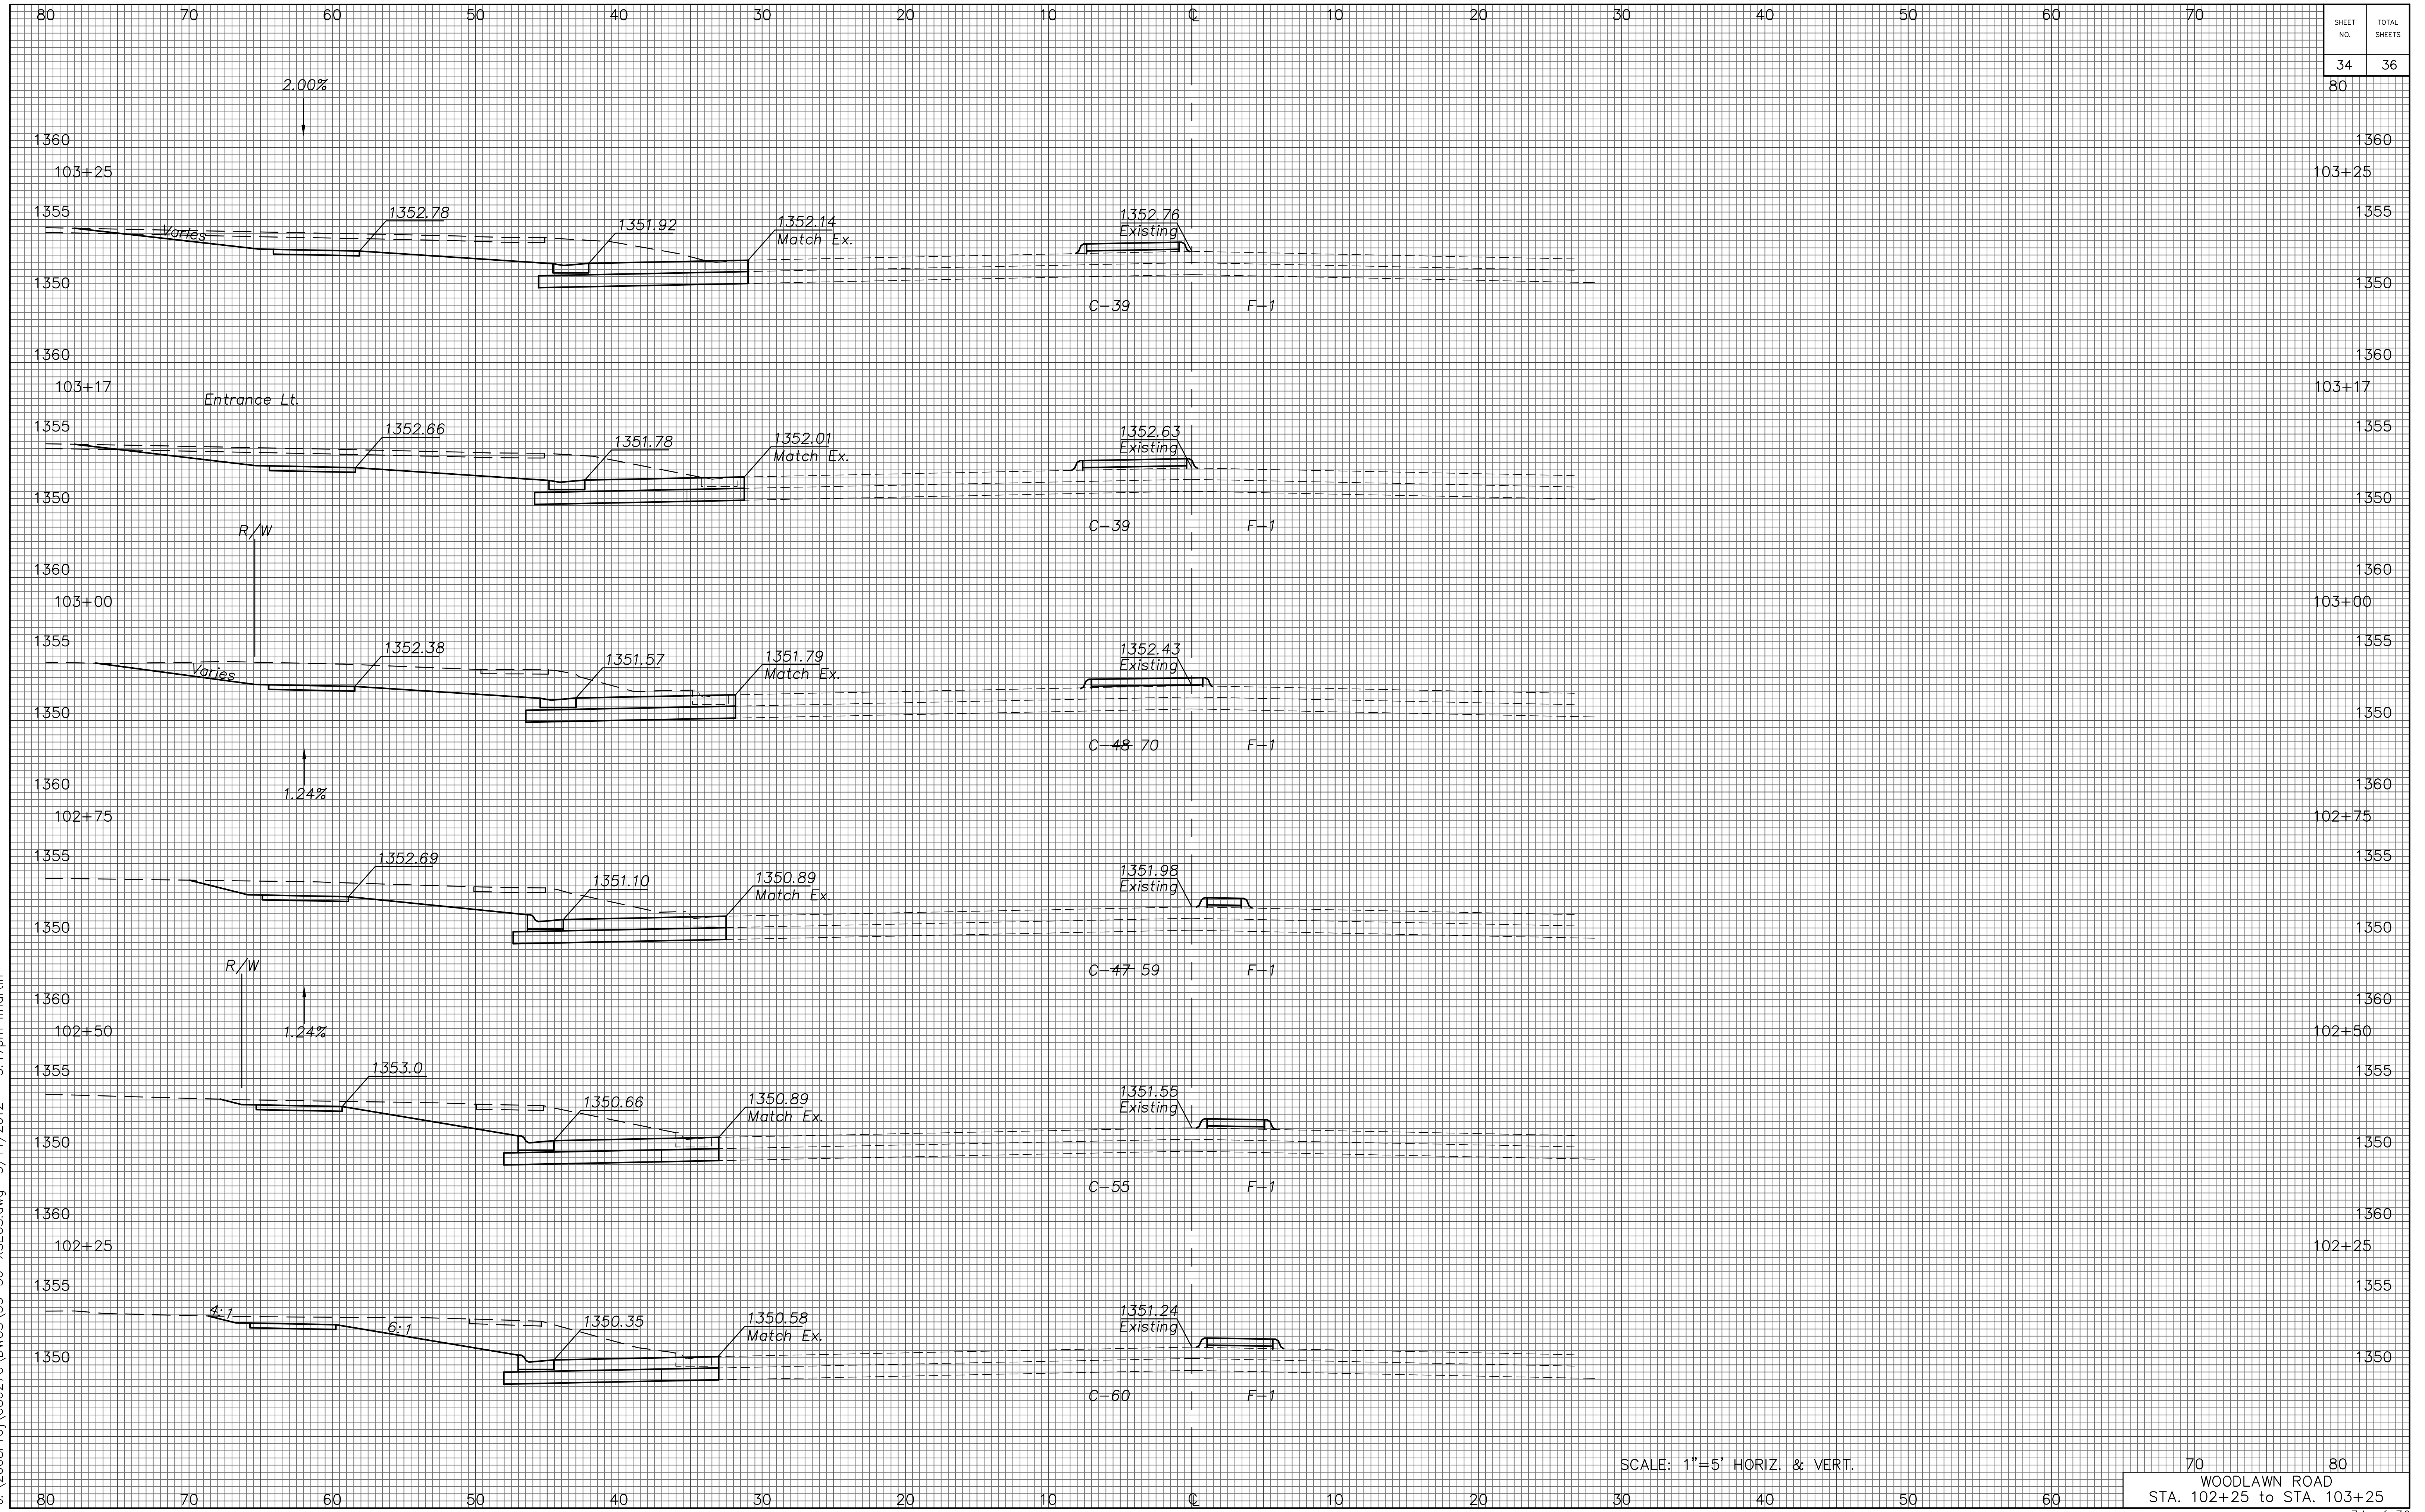

J:\2008Pro\066270\DWG\33-36-XSECS.dwg 3/14/2012 - 3:17pm I.martin

SCALE: 1"=5' HORIZ. & VERT.

70 80  
WOODLAWN ROAD  
STA. 102+25 to STA. 103+25