
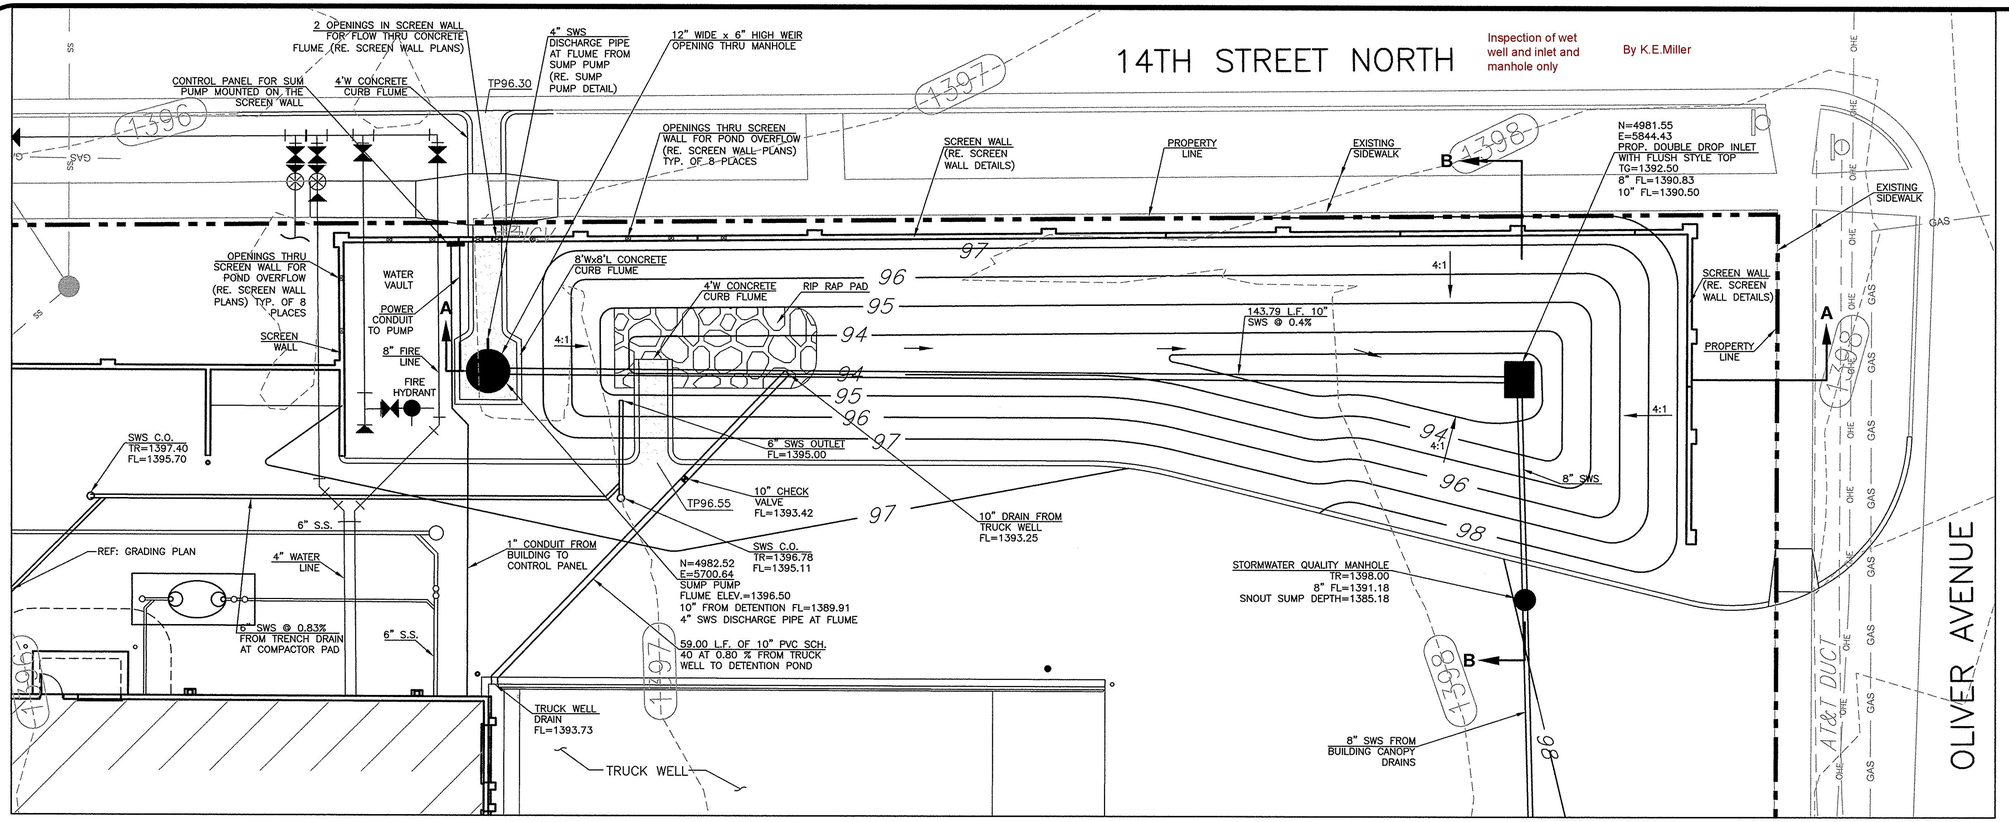



DETENTION POND PLAN

SCALE: 1"=10'-0"

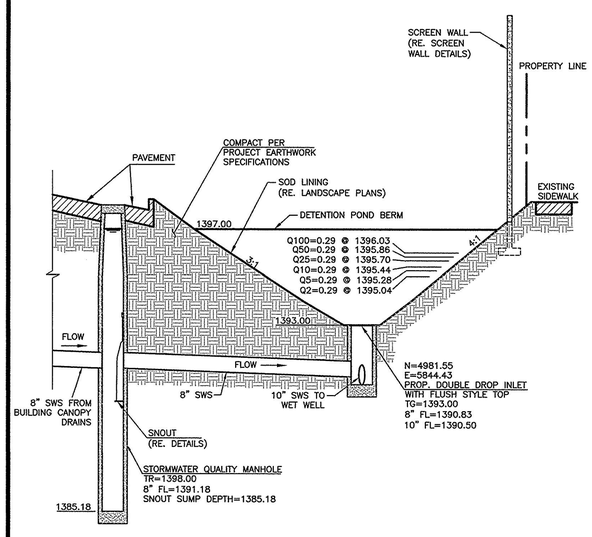

SECTION B–B

SCALE: HORIZ. 1"=10'-0"
VERT. 1"=3'-0"

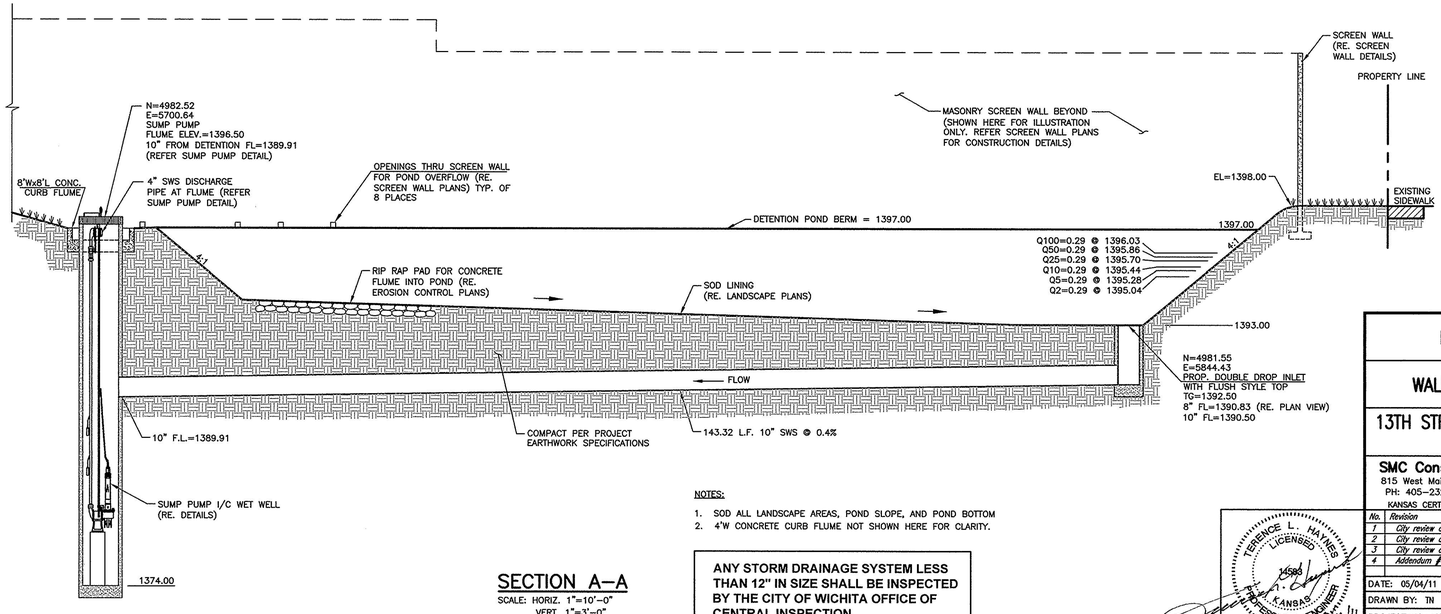

SECTION A–A

SCALE: HORIZ. 1"=10'-0"
VERT. 1"=3'-0"

NOTES:

1. SOD ALL LANDSCAPE AREAS, POND SLOPE, AND POND BOTTOM
2. 4'W CONCRETE CURB FLUME NOT SHOWN HERE FOR CLARITY.

ANY STORM DRAINAGE SYSTEM LESS THAN 12" IN SIZE SHALL BE INSPECTED BY THE CITY OF WICHITA OFFICE OF CENTRAL INSPECTION

SCALE: 1" = 10'

BENCHMARK

SITE BENCHMARK–1
"V" Chiseled on Conc.
NE Prop. Corner
Elevation=1398.36
DATUM = NAVD 1988

REFER STORM SEWER LOCATION PLAN SHEET C–9.1 FOR BENCHMARK LOCATION

DETENTION POND PLAN

WALMART MARKET #5873–01

13TH STREET NORTH & OLIVER AVENUE WICHITA, KANSAS

SMC Consulting Engineers, P.C.
815 West Main – Oklahoma City, OK 73106
PH: 405–232–7715 Fax: 405–232–7859
KANSAS CERTIFICATE OF AUTHORIZATION NO. E–335 EXP. DEC. 2011

No.	Revision	By	Date
1	City review comments	MDS	06/28/11
2	City review comments	MDS	07/20/11
3	City review comments	MDS	08/12/11
4	Addendum #1 – SMC review comments	MDS	08/26/11

DATE: 05/04/11
DRAWN BY: TN
PROJECT NO.: 4936.30
SCALE: NTS
SHEET NO. C–9.6
ENGINEER: TERENCE L. HAYNES, P.E. #14583

TERENCE L. HAYNES LICENSED 14583 KANSAS PROFESSIONAL ENGINEER 8/26/11
NOT VALID FOR CONSTRUCTION UNLESS SIGNED IN THIS BLOCK