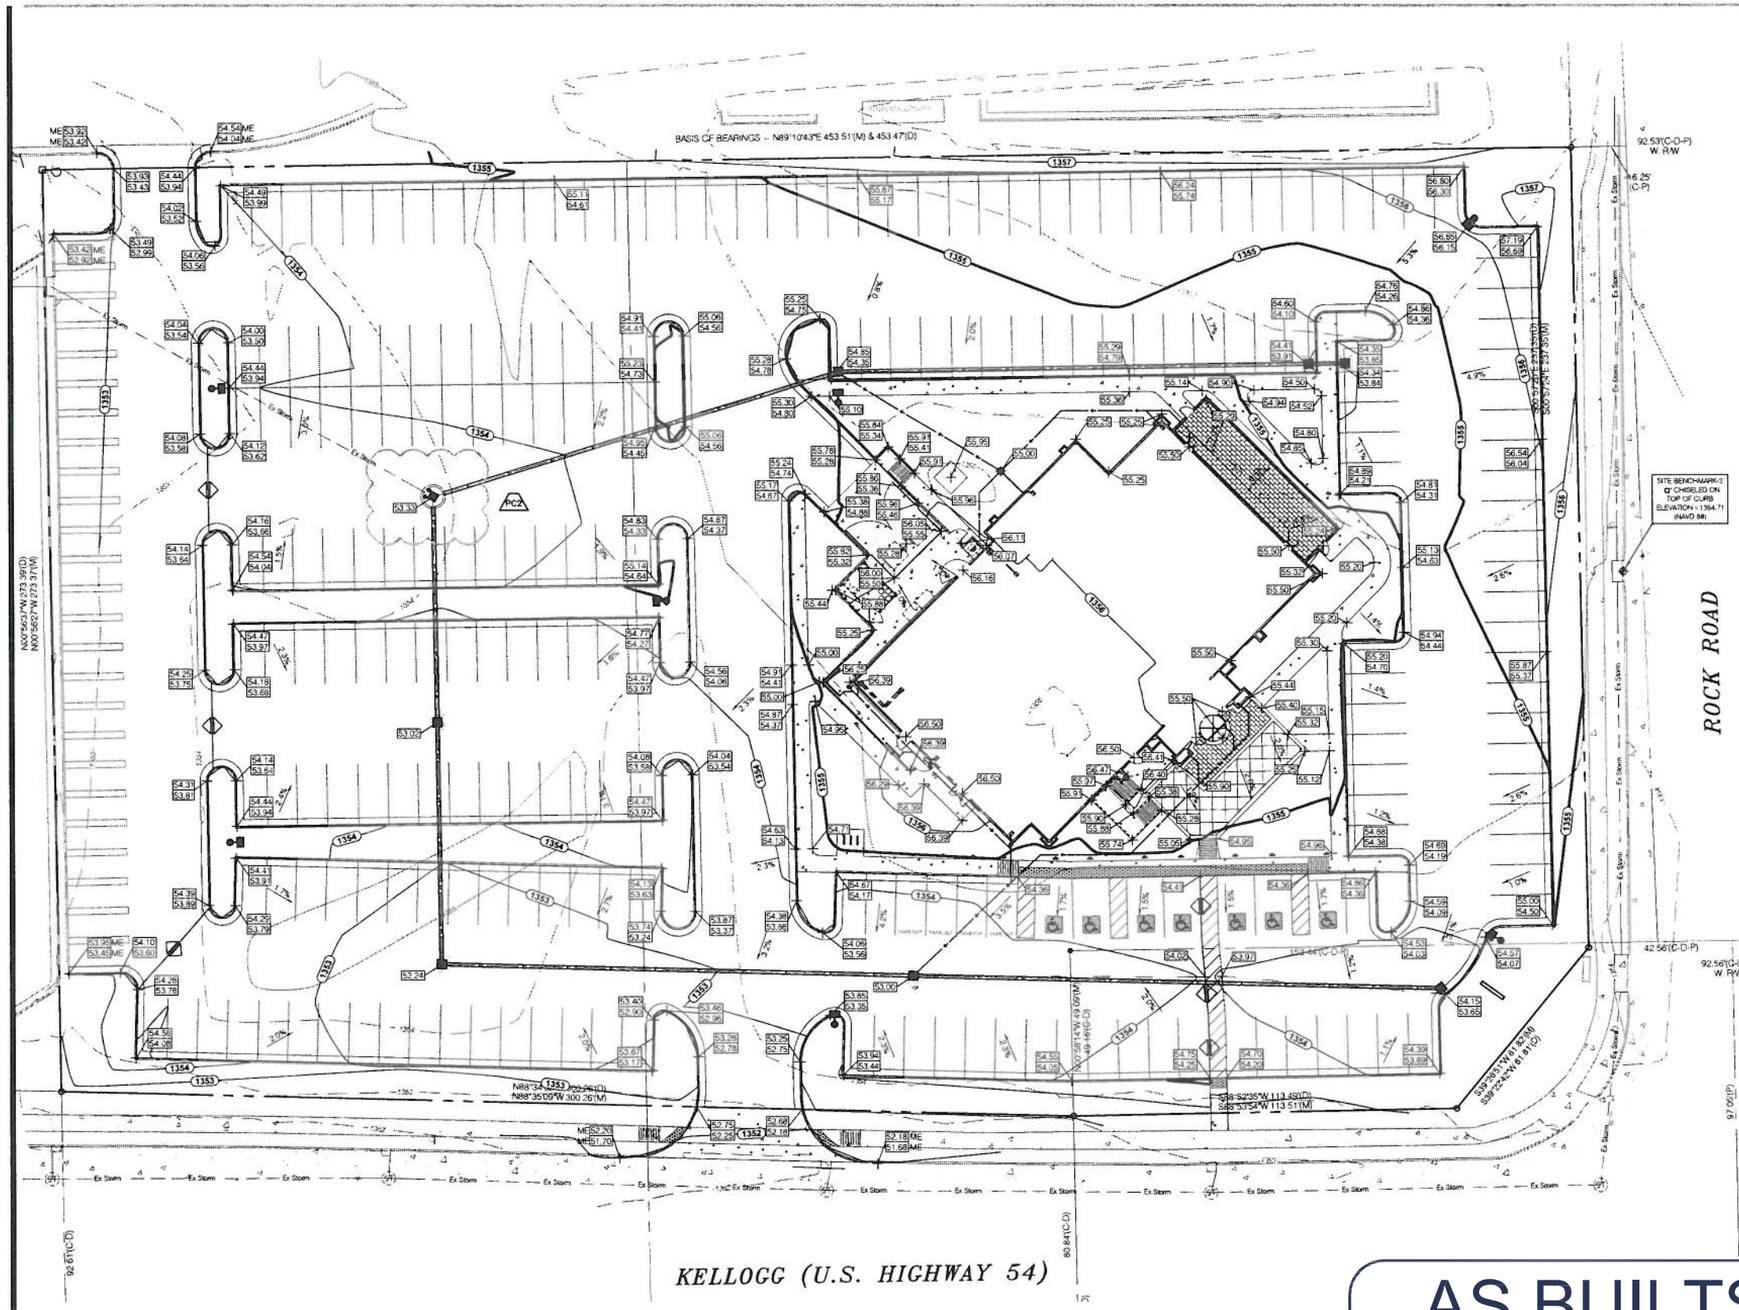

PLAN NOTES

1. PAVEMENT SHALL BE FLUSH WITH WALK IN ACCESSIBLE PARKING AREA. SEE DETAIL ON SHEET C8.
2. RAISE/LOWER ALL EXISTING UTILITIES EXPECTED TO BE AT GRADE TO PROPOSED GRADE ELEVATIONS.

GRADING LEGEND

PROPOSED SPOT ELEVATION	00.00 FG - FINISH GRADE
PROPOSED SPOT ELEVATION (AT VERTICAL ELEVATION CHANGE)	00.00 TC - TOP OF CURB; 00.00 PAVEMENT/FLOWLINE
PROPOSED SPOT ELEVATION (AT RETAINING WALL)	XX.XX TW - TOP OF WALL; XX.XX BW - BOTTOM OF WALL
PROPOSED CONTOUR	10
EXISTING ELEVATION	
6" PVC DRAIN LINE TO EXISTING STORM SYSTEM. SLOPE ALL PIPES 1% MIN	
10" AREA DRAIN TO BE NYOPLAST INLINE DRAIN WITH DOMED GRATE (OR APPROVED EQUAL)	
CROWN LINE (TYP.)	
MATCH EXISTING ELEVATION (TYP.)	ME

AS BUILTS

kemiller engineering
516 S. Market,
Wichita, KS 67202
(316)264-0242

CALL BEFORE YOU DIG !
KANSAS LAW REQUIRES NOTIFICATION OF THE UNDERGROUND FACILITY OWNER AT LEAST TWO (2) WORKING DAYS BUT NO MORE THAN FIFTEEN (15) CALENDAR DAYS PRIOR TO EXCAVATION OR DEMOLITION
Kansas One-Call
www.kansasonecall.com
1-800-DIG-SAFE

NORTH
0 10 20 40
SCALE: 1" = 20.00'

wd PARTNERS
brand : operations : build

7007 DISCOVERY BLVD
DUBLIN, OH 43017
614.634.7000 T
WDPARTNERS.COM

4D PROTOTYPE

BJ'S RESTAURANT & BREWHOUSE
7960 EAST KELLOGG
WICHITA, KANSAS 67207

JEFFREY ALAN TIBBITTS
LICENSED
17882
KANSAS
PROFESSIONAL ENGINEER
01/30/2012

REVISIONS
PC1 12/20/11
PC2 01/30/12

WD PROJECT: BJSB0167
PERMIT ISSUE DATE: 11/17/11
HEALTH SUBMITTAL:
BID ISSUE DATE: 12/19/11
CONSTRUCTION SET:

C2.1 SITE GRADING PLAN