

STA. 10+03.50, LINE 4
 INSTALL 15" RESTRAINED END
 SECTION W/ SEDIMENT BASIN
 N 1698423.4819
 E 1611992.7402



STA. 10+18.9, LINE 4
 INSTALL CURB INLET TYPE "B"
 INLET TOP=1352.74
 PROVIDE SEDIMENT BARRIER
 N 1698405.2458
 E 1611996.7116

STA. 11+72.8, LINE 4
 END 15" RCP STUB

STA. 11+68.8, LINE 4
 INSTALL CURB INLET TYPE "R"
 INLET TOP=1353.50 1353.03
 PROVIDE SEDIMENT BARRIER
 N 1698256.7279
 E 1612015.7683


SEDIMENT BASIN
 SEE DETAIL ON SHEET 4
 OF 12.

WEST 21ST STREET NORTH

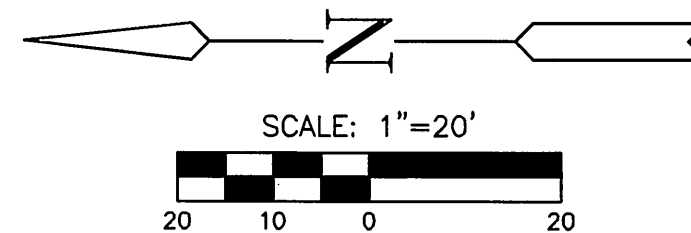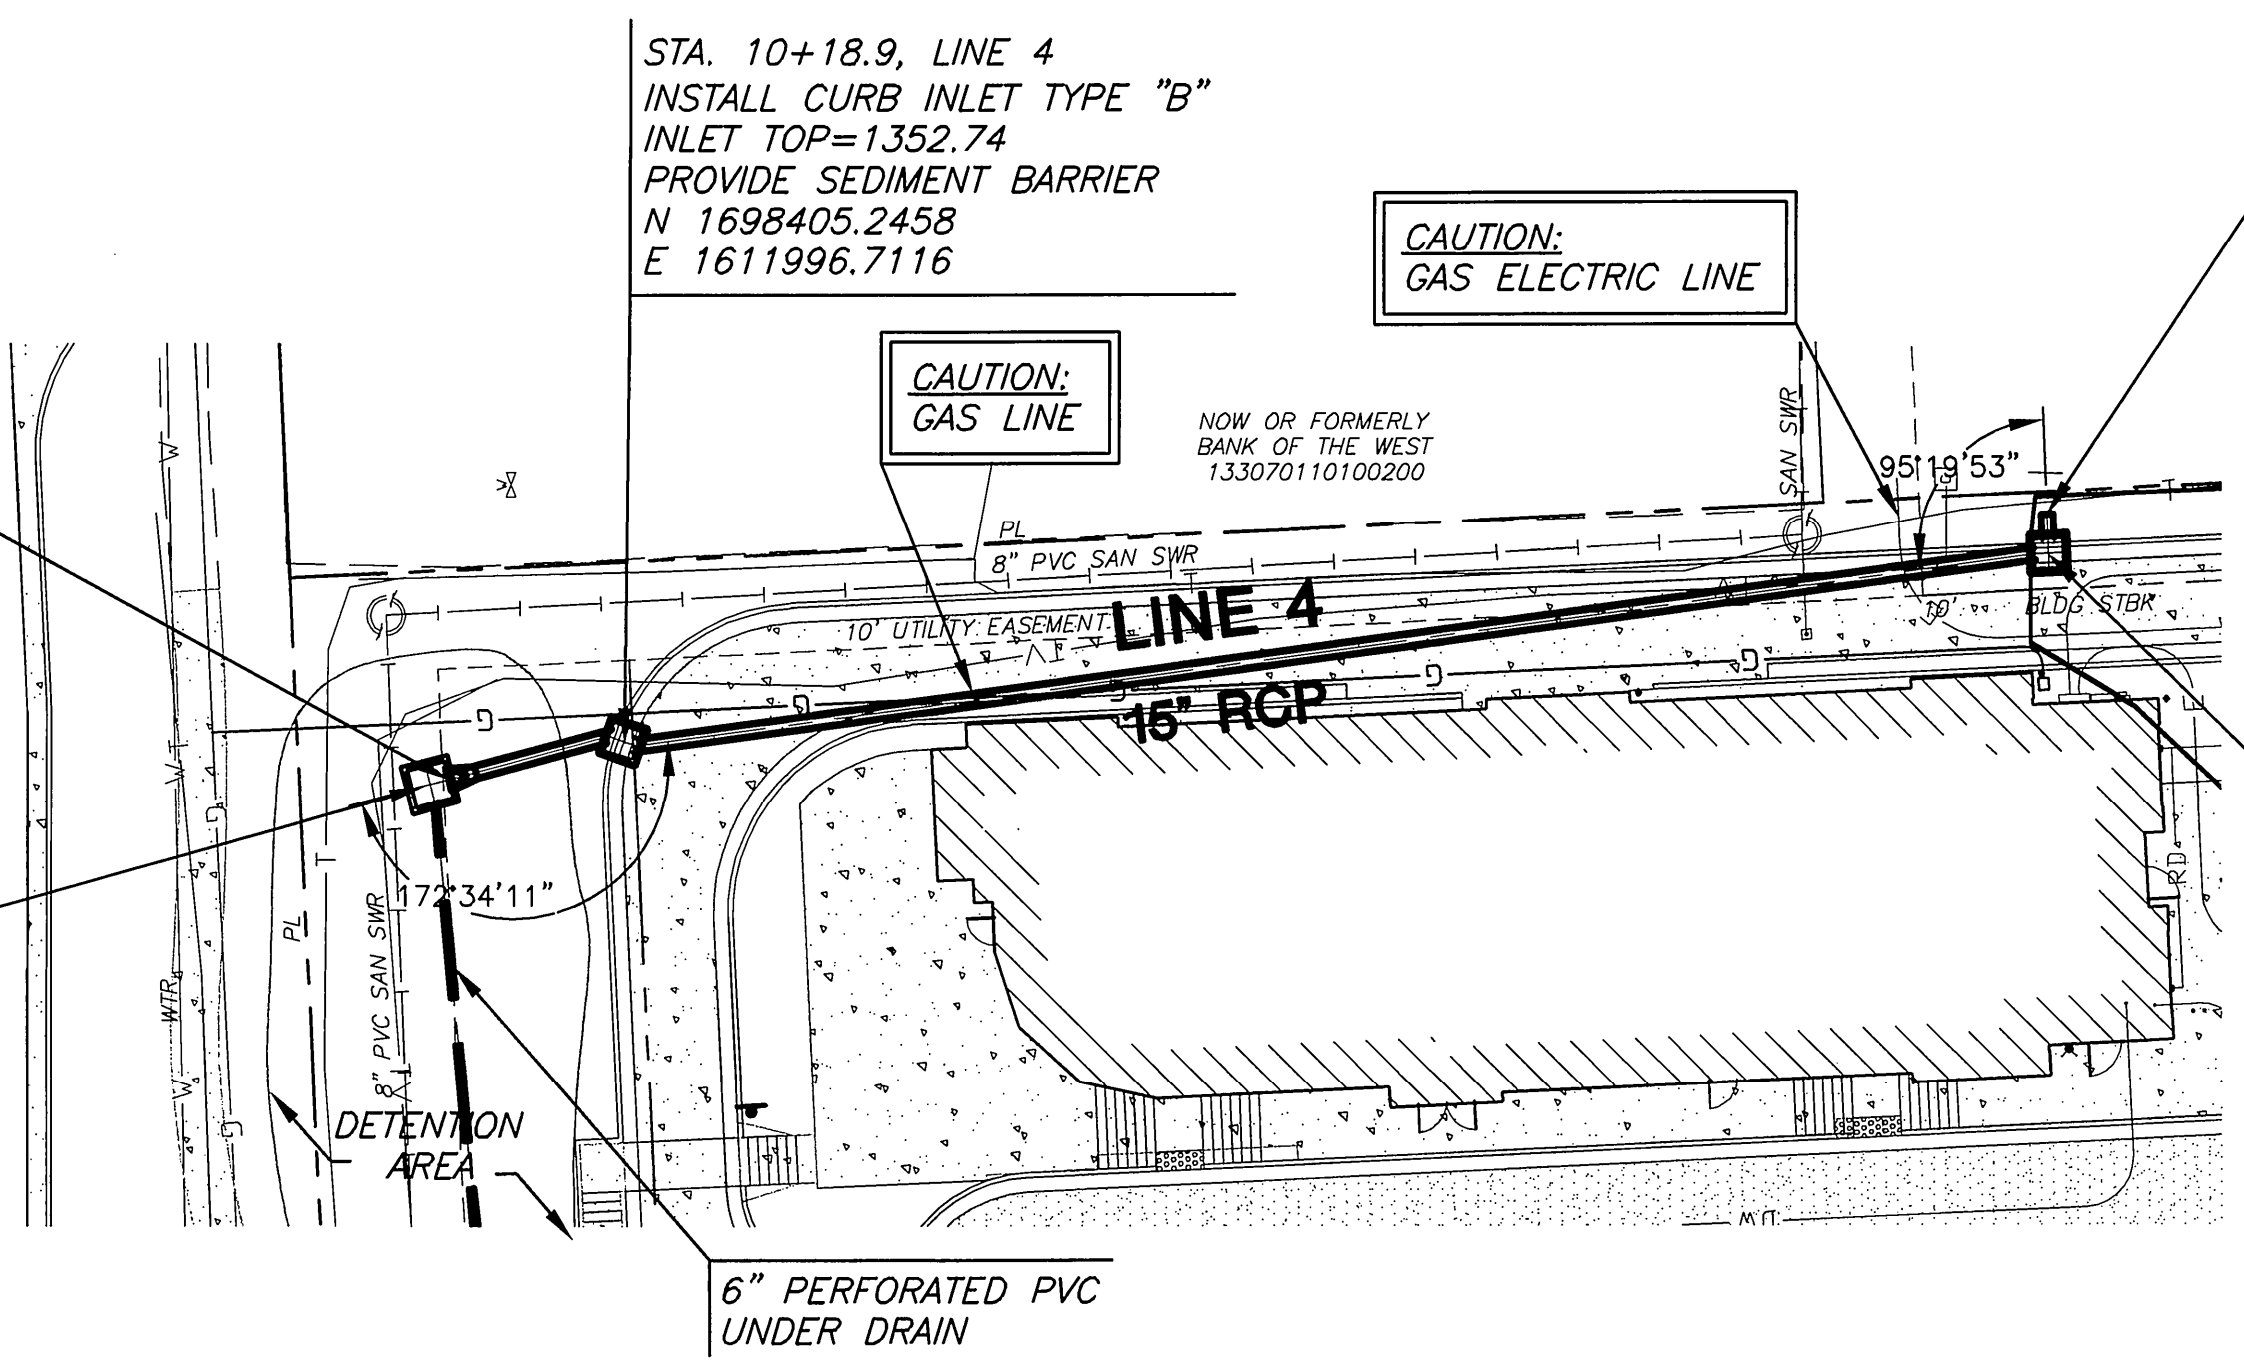

PLAN LINE 4

PROFILE LINE 4

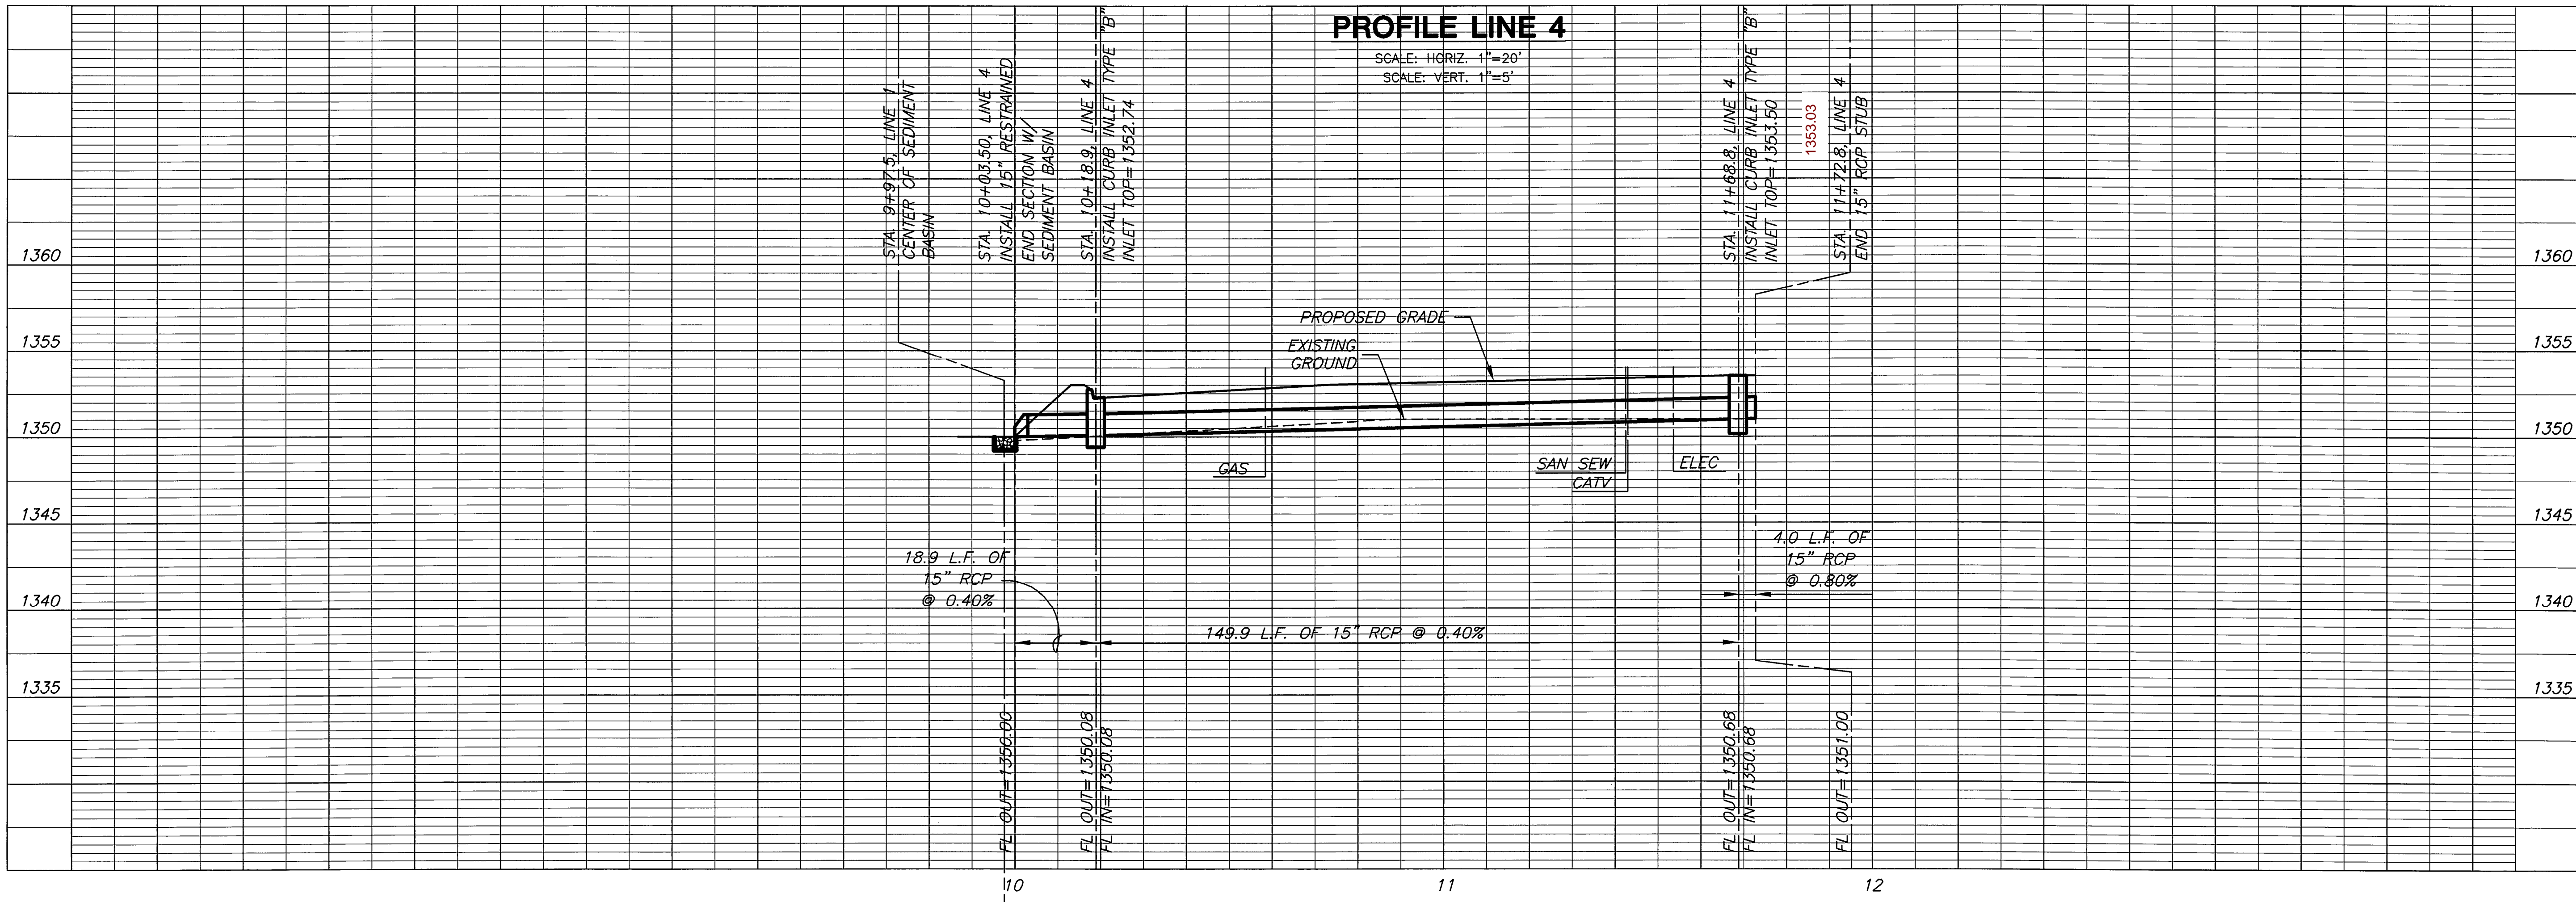

STORM WATER SEWER PLANS FOR
CHICK-FIL-A
 WICHITA, KANSAS

LINE 4
 SHEET TITLE
 1201010135
 PROJECT NUMBER

AJK | DM | GJA
 DESIGNED DRAWN CHECKED

ISSUED
 March 2012
 REVISED

SHEET NO.
 9 of 14