

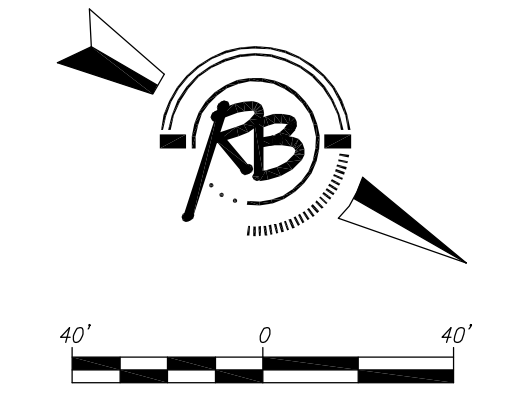


# Sierra Hills 2nd Addition

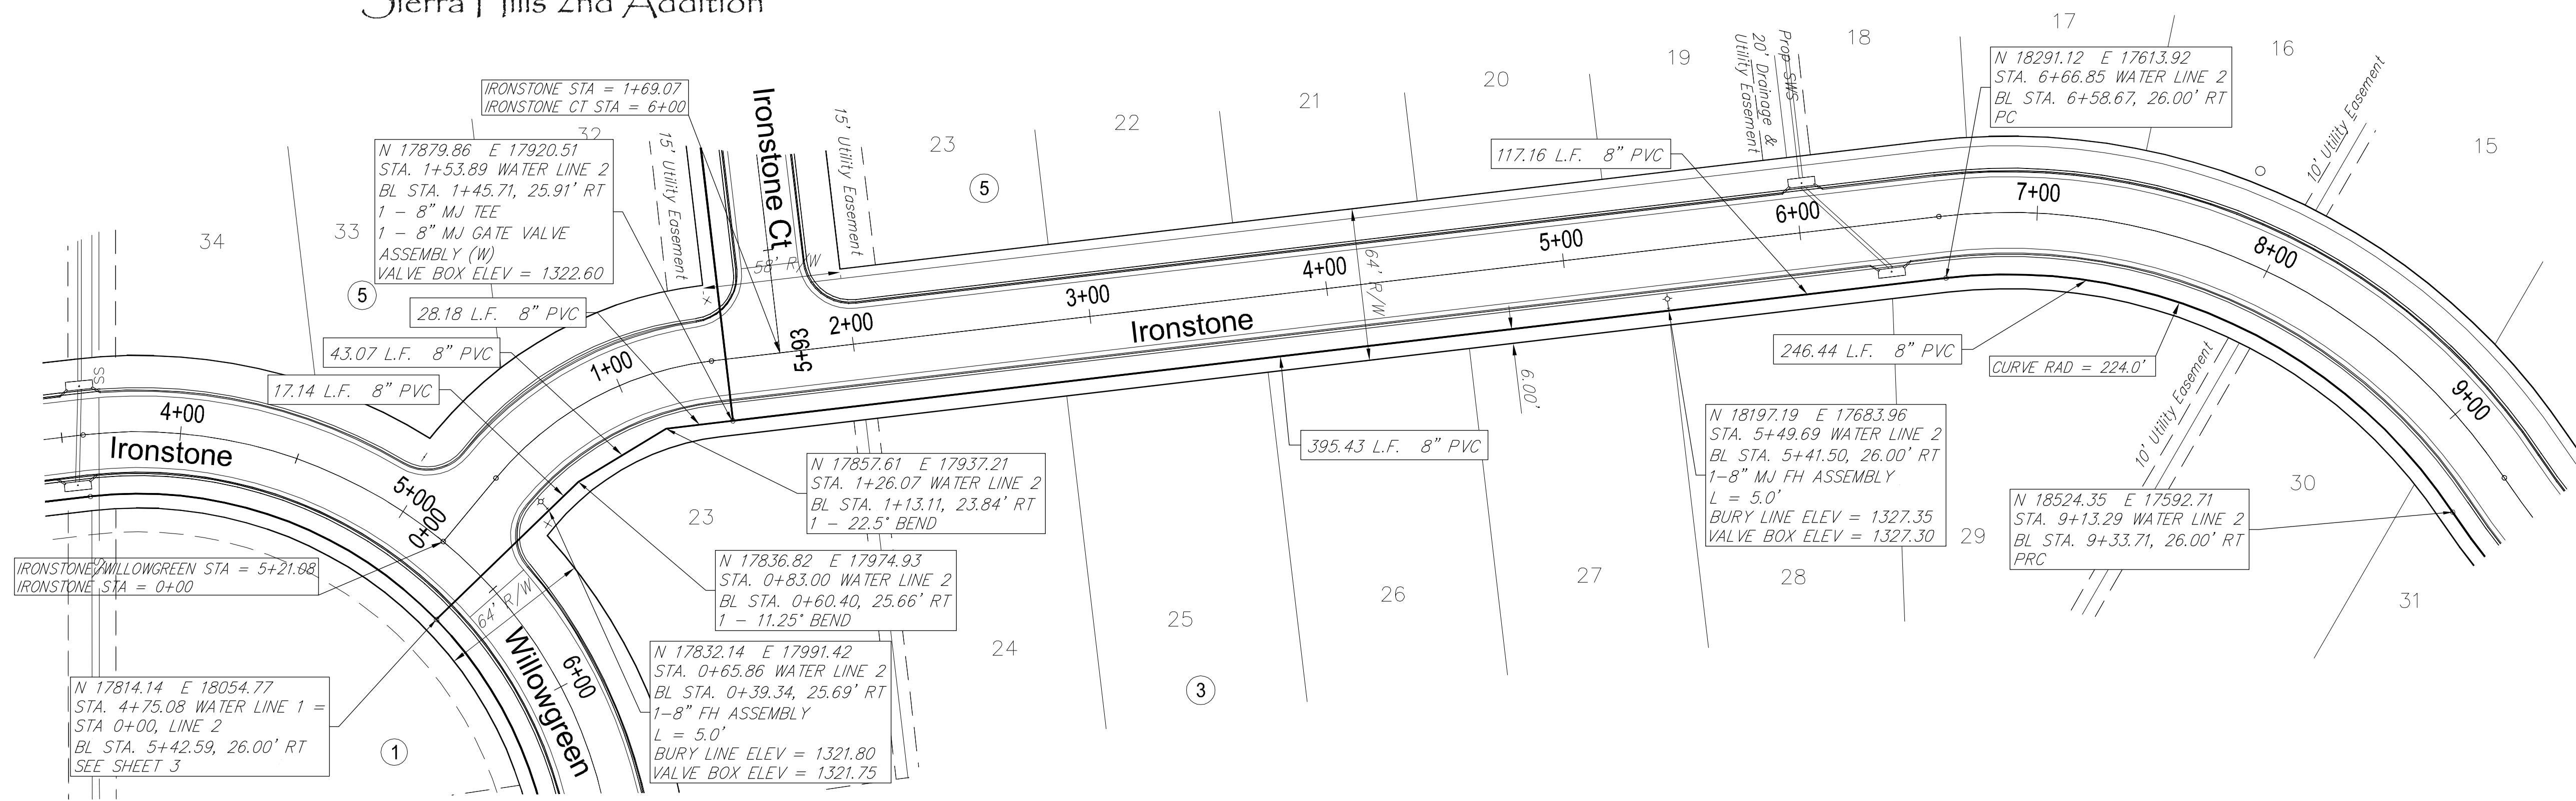

Ruggles & Bohm, P.A.  
 Engineering, Surveying, Land Planning  
 634 North Main  
 Wichita, Kansas 67203  
 www.ruggles.com  
 Email: ruggles@ruggles.com

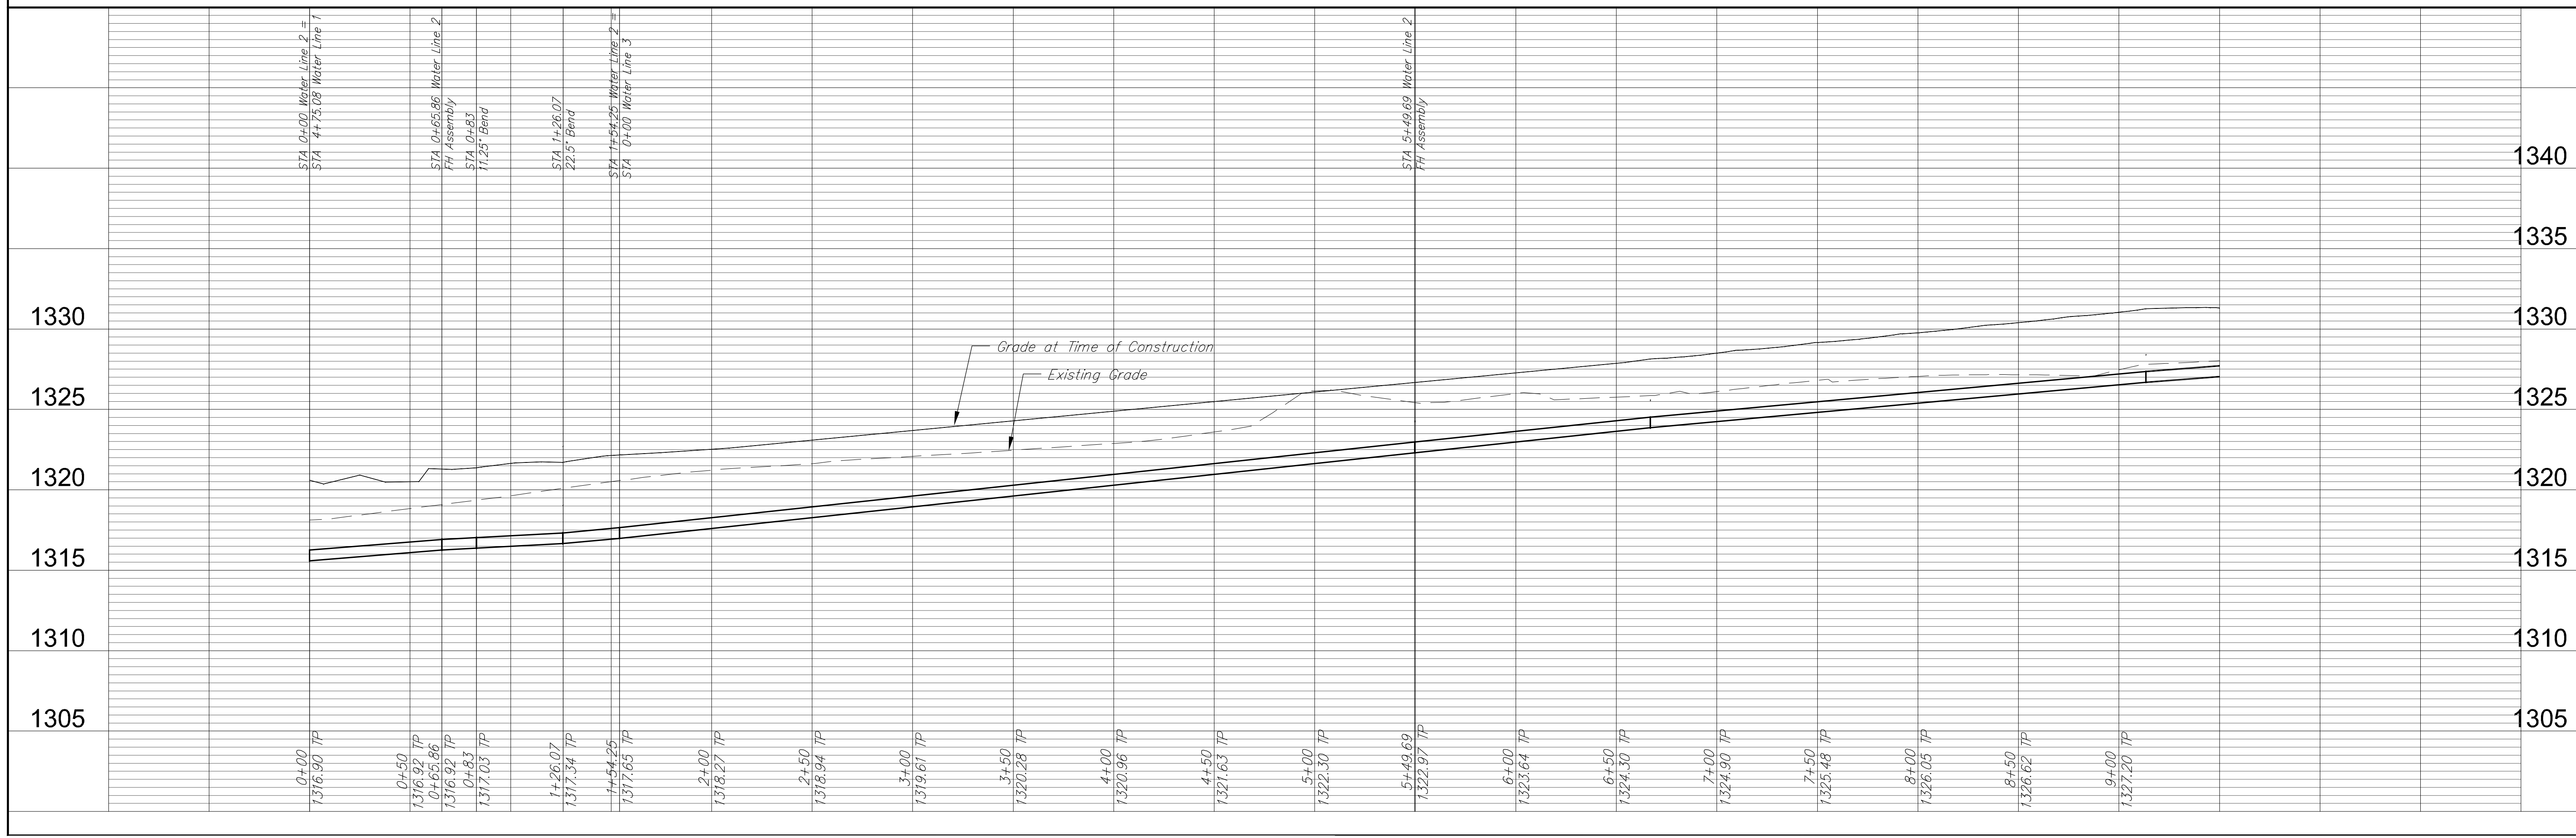

REVIEWED: EJC DATE: May 30, 2012

DESIGN: EJC DATE: ---

PROJECT NUMBER: 446-0050

DRAWING FILE: Water (Water Line 2)

PAVING IMPROVEMENTS  
 Water Line 2  
 WICHITA, KANSAS

RB JOB: 3268E  
 SHEET: 4 OF 13