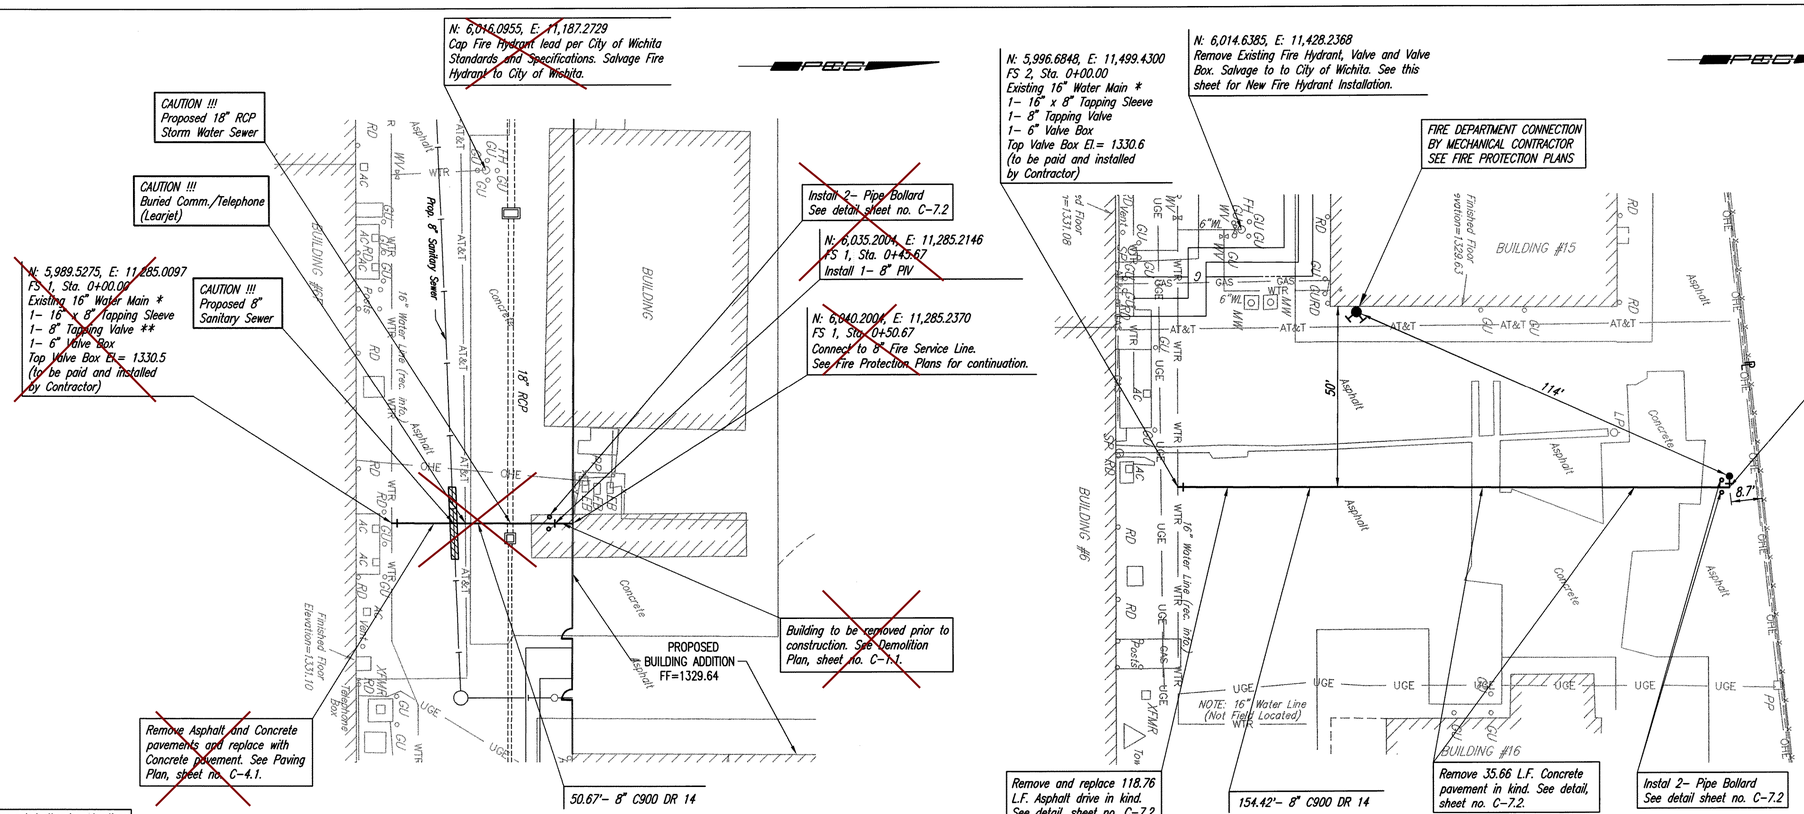

* PRIOR TO BEGINNING CONSTRUCTION, THE CONTRACTOR SHALL EXCAVATE THE EXISTING 16" WATER MAIN AT FS 1, STA 0+00.00 AND FS 2, STA 0+00.00 TO VERIFY PIPE SIZE, TYPE, FITTINGS, AND HORIZONTAL AND VERTICAL LOCATION. THE CONTRACTOR SHALL REPORT HIS FINDINGS TO THE ENGINEER SO THAT ANY NECESSARY PLAN MODIFICATIONS CAN BE MADE. ANY ADDITIONAL LABOR OR MATERIALS NECESSARY TO COMPLETE THE CONNECTION SHALL BE CONSIDERED SUBSIDIARY TO THE PROJECT.

** VALVE BOX TOP TO MATCH FINISHED GRADE OF PROPOSED CONCRETE PAVEMENT. CONTRACTOR TO CONFIRM ELEVATION AT TIME OF CONSTRUCTION.

NOTE: CONTRACTOR SHALL MAINTAIN UNINTERRUPTED UTILITY SERVICE TO ADJACENT FACILITIES DURING CONSTRUCTION. ANY LOSS OF UTILITY SERVICE SHALL BE COORDINATED WITH OWNER.

JAMES L. ARMOUR, P.E. - CITY ENGINEER
PRIVATE PROJECT NO. 1656 PPW (607853)

AS BUILTS

Contractor: Fire Protection Services

Project Inspector: Tom Jones

kemiller engineering
516 S. Market
Wichita, KS 67202
(316)264-0242

FIRE SERVICE LINE NO. 1 AND 2

PEC
303 SOUTH TOPEKA
WICHITA, KS 67202
316-262-2691 www.pec1.com

DATE
3/9/2012
BIDDING

HOWARD+HELMER architecture
www.howardandhelmer.com | kansas city + wichita
3500 north rock road
bldg. 500 wichita, ks 67226
316.634.1111 (p) 316.634.1016 (f)

MATTHEW BILLINGSLEA
LICENSED
20827
PROFESSIONAL ENGINEER
4/9/12

project no.
11279.00

The drawing and all information herein is the exclusive property of Howard & Helmer Architects P.A. and is not to be copied or used in any way without the express written consent of Howard & Helmer Architects P.A. All drawings, specification, ideas, designs and arrangements appearing herein constitute the original and unpublished Work of the Architect.

Copyright © 2012
Howard & Helmer
Architects P.A.

BOMBARDIER FLIGHT TEST CENTER
BUILDING B15
ONE LEARJET WAY
WICHITA, KANSAS

sheet
C-7.5

Saved 03-30-2012 8:36:49 AM by CSL
Plot Scale: 1:20 Date: 03/07/2012 8:58 AM by JAN
Q:\2011\11394\006\Site Civil\11394-006-C7_15-FS LINE NO 1