
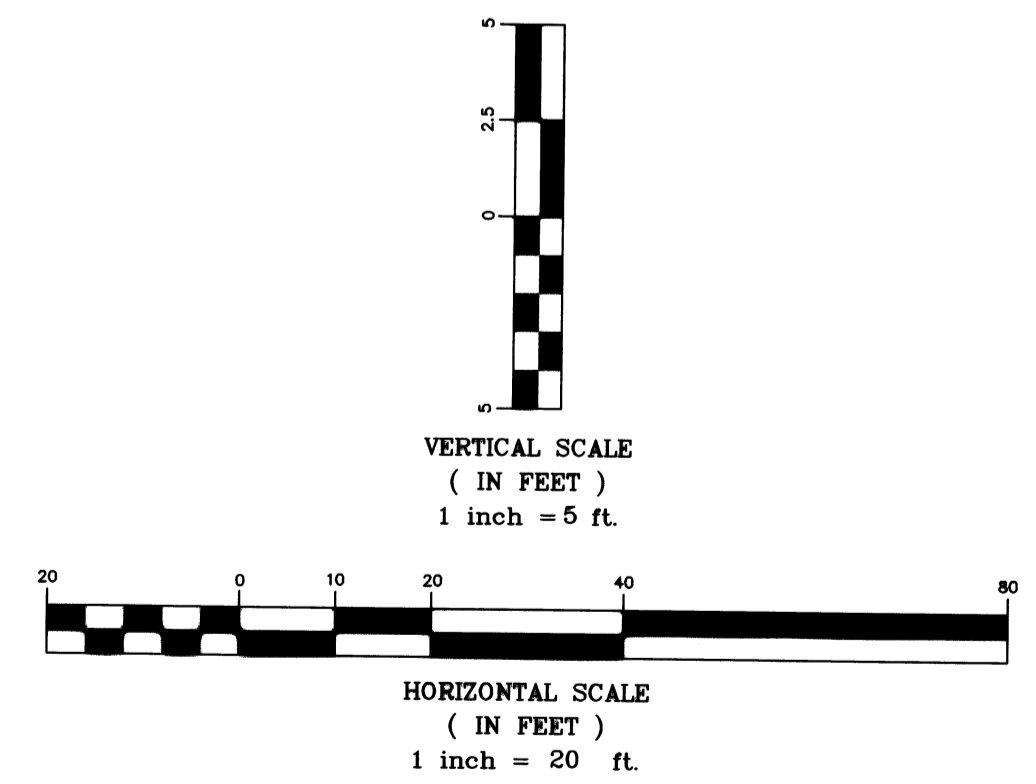
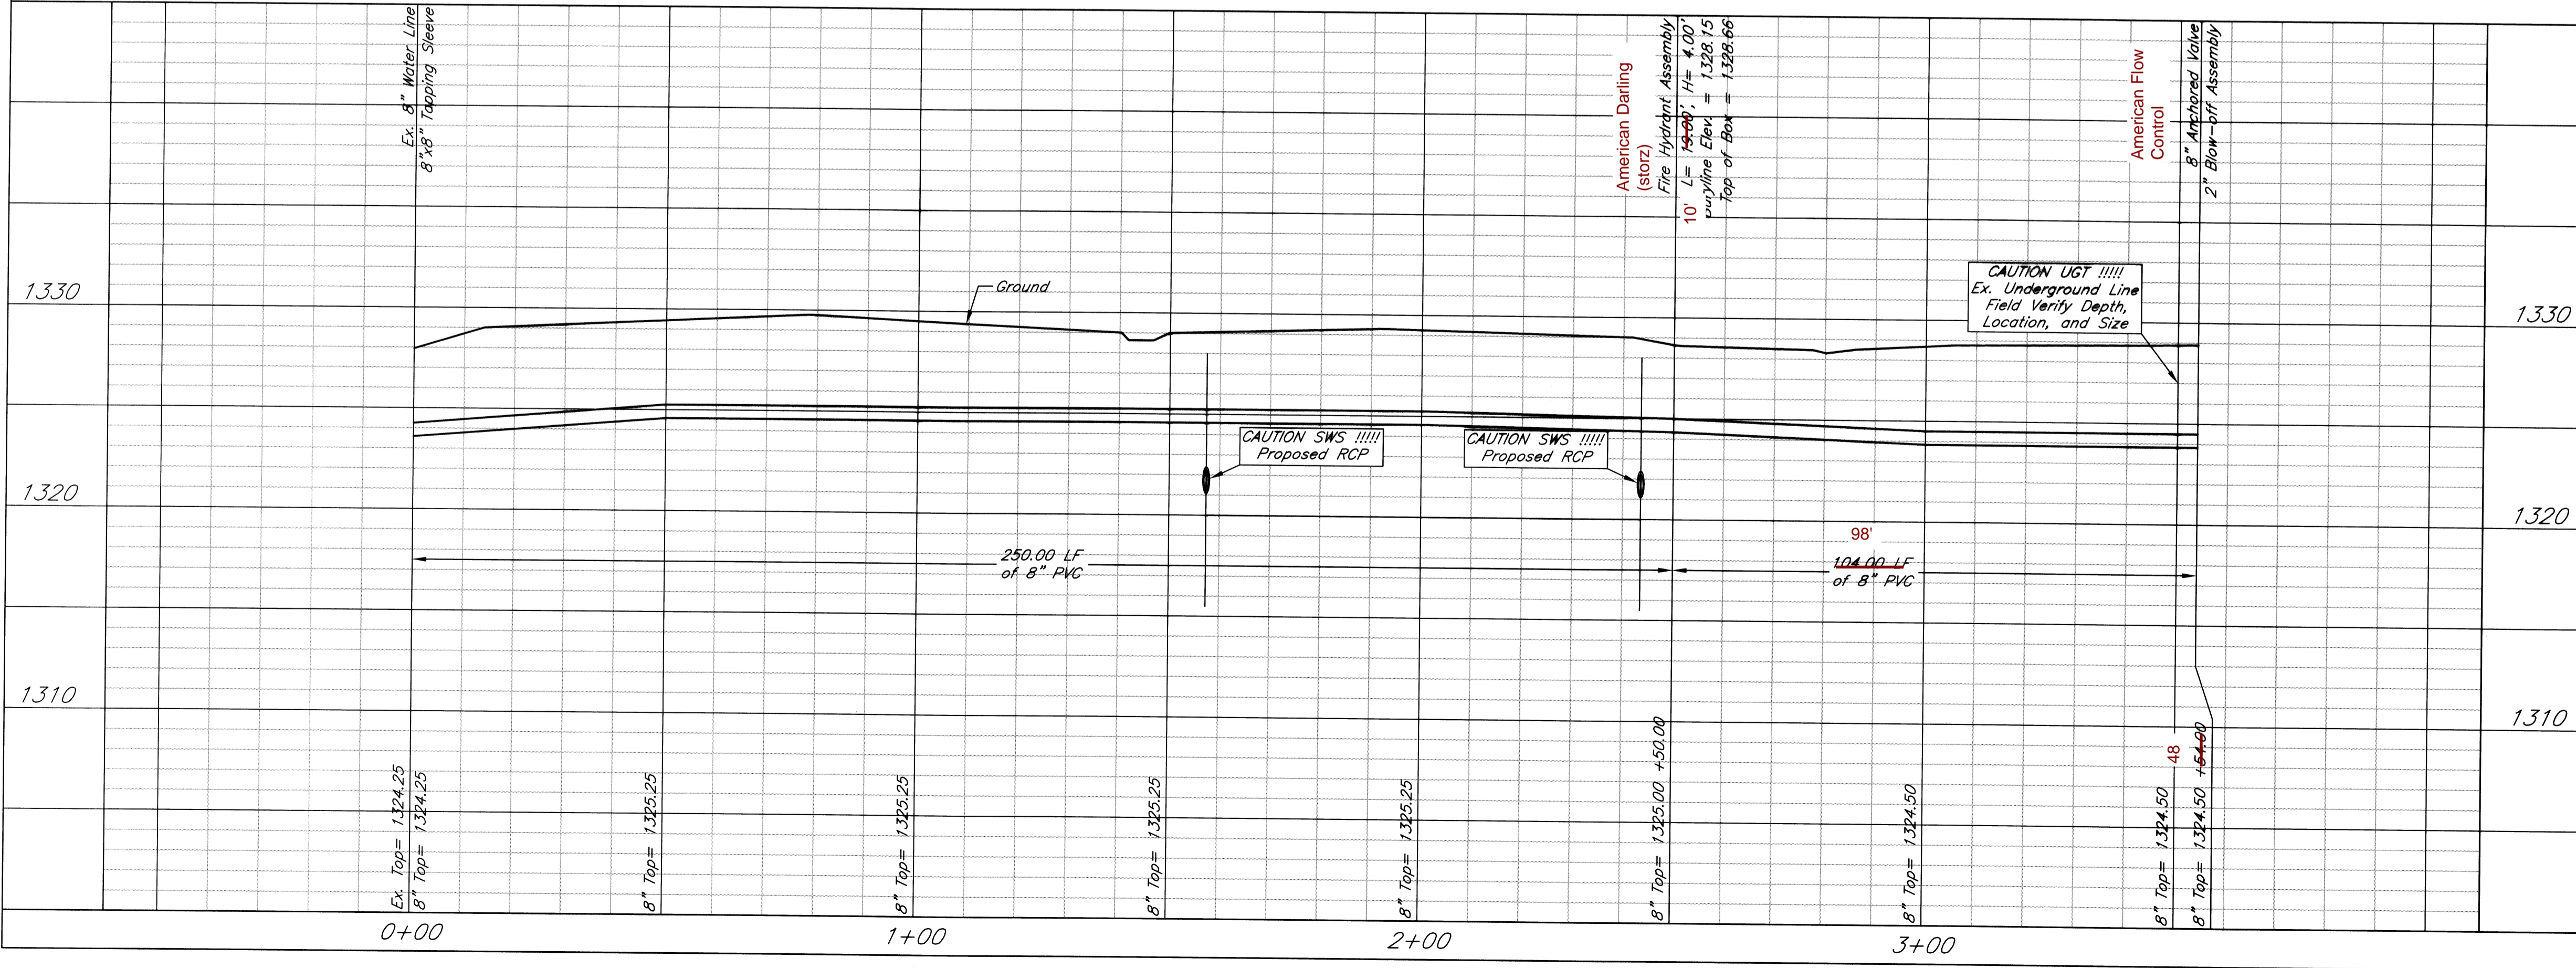


cl is center line of street

Tapping valve
24' from cl of street
Fire hyd. American
Darling (storz)
24.5' back of curb
Blow-off 24.5' back
of curb

BELLEVUE STREET

TYLER ROAD

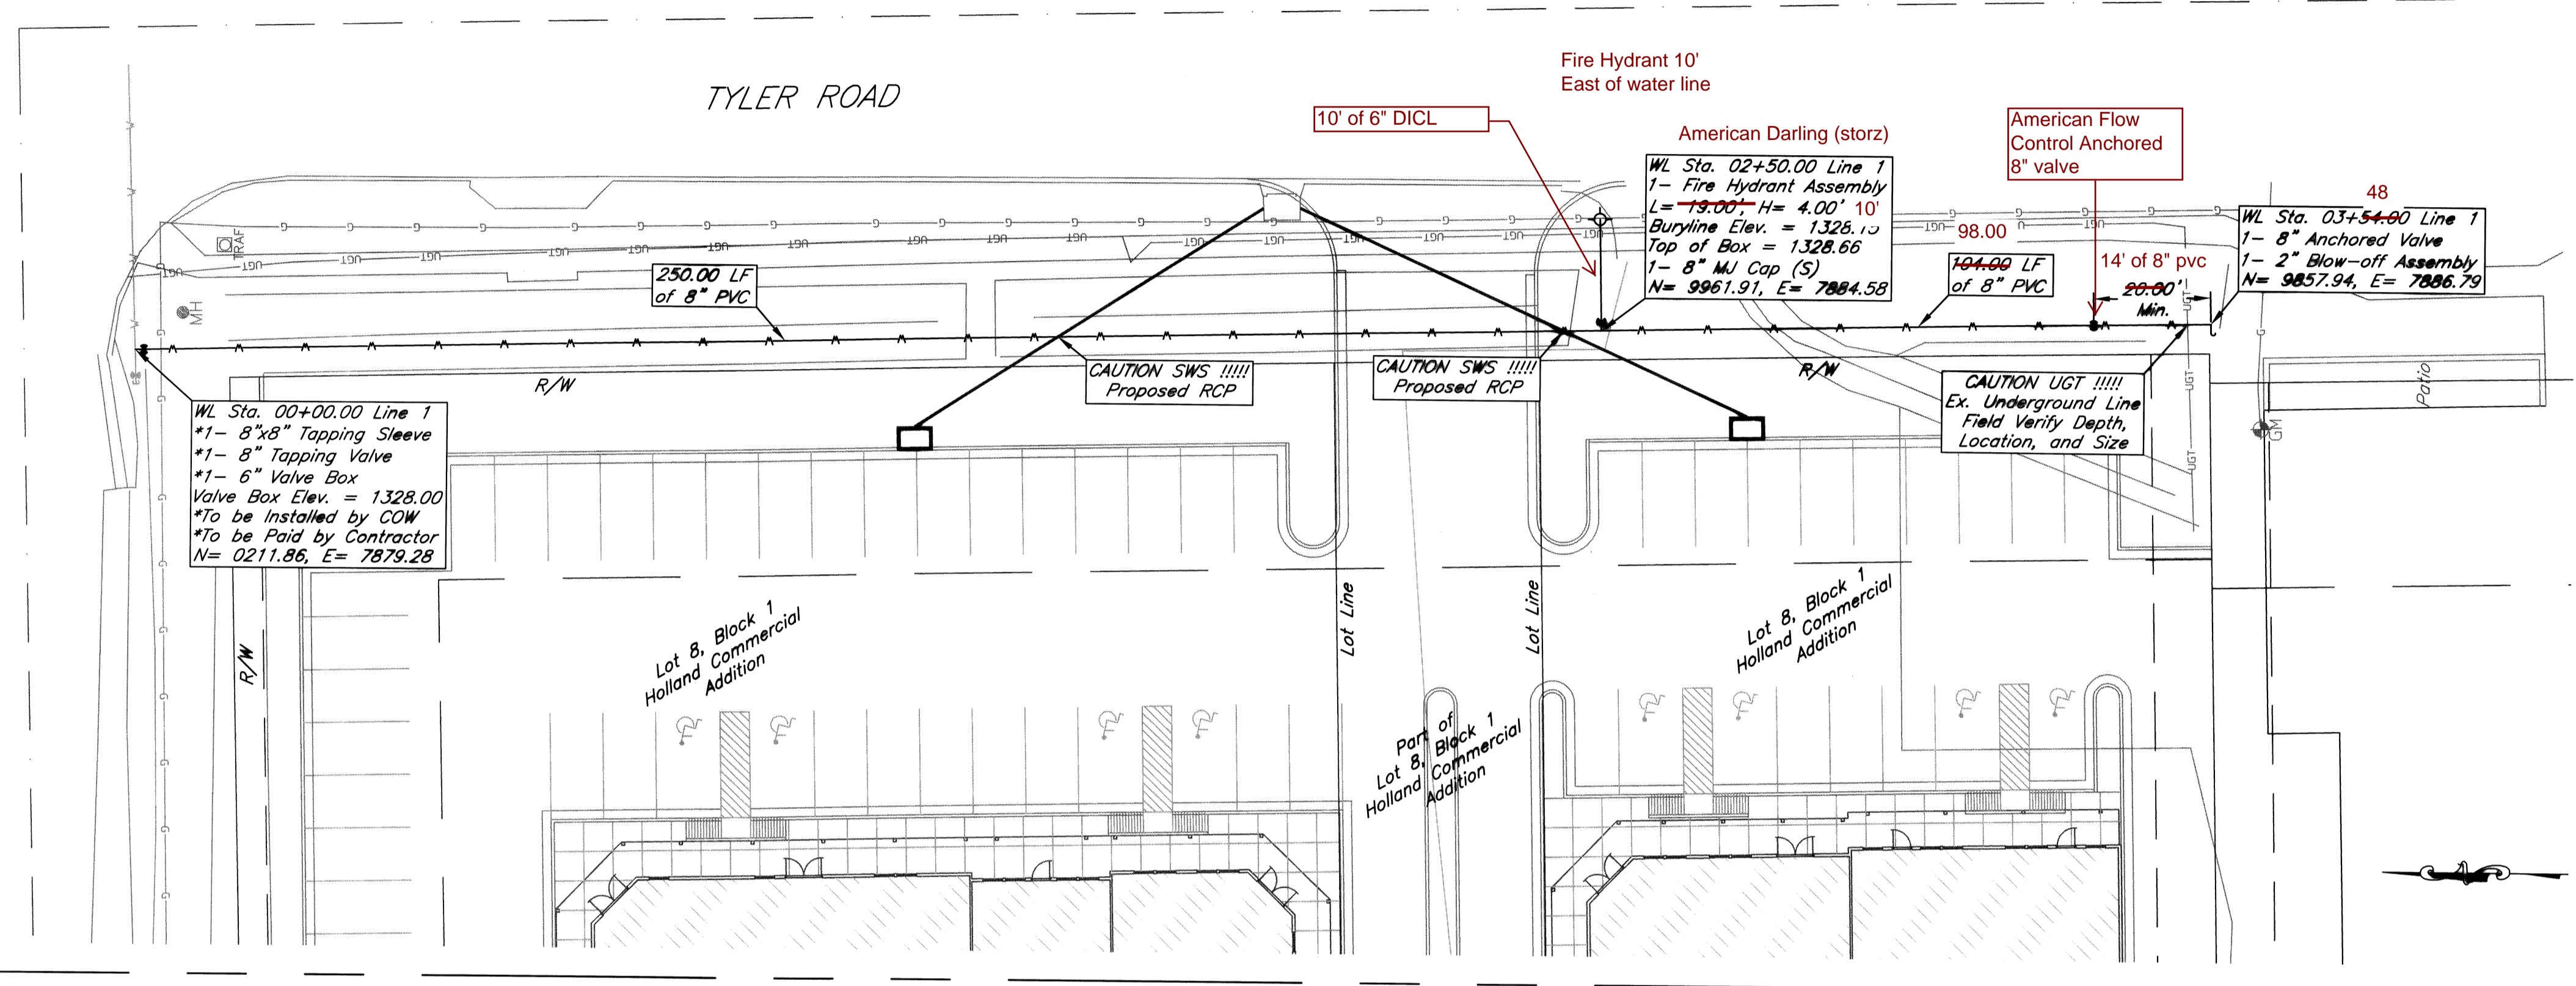

Lots 1,7,8, Block 1, Holland Commercial Add
Water Line
Wichita, Kansas

| | | | |
|-----------------------------|-------------|-------------------------------------|---------------------|
| kemiller engineering | | PROJECT NUMBER 1593 PPW (607853) | |
| KEM NO. 11025 | FILE | DATE 05/17/2011 | SHEET 2.0 |
| DESIGN KM | DRAWN NS | REVISED | |

516 S. Market, Wichita, KS 67202 (316)264-0242