

For both locations:
The clay service is broken at the first joint outside of the main and there is a cavity forming. The clay wye is broken and must be removed as part of the repair. A point repair on the 8" main should not be necessary.


MH 5847-324
326 N. Pinecrest
(visible under fence)
Approx MH depth = 18.0 ft

MH 5847-323
Approx MH depth = 12.8 ft

Service Connection Replaced:
Replace the 4" connection for 320 N. Pinecrest,
located at 52 ft. south of MH 5847-324.

Service Connection Replaced:
Replace the 4" connection for 321 N. Old
Manor located at 86 ft. south of MH 5847-324.

Estimated 40 lf of Silt Fence

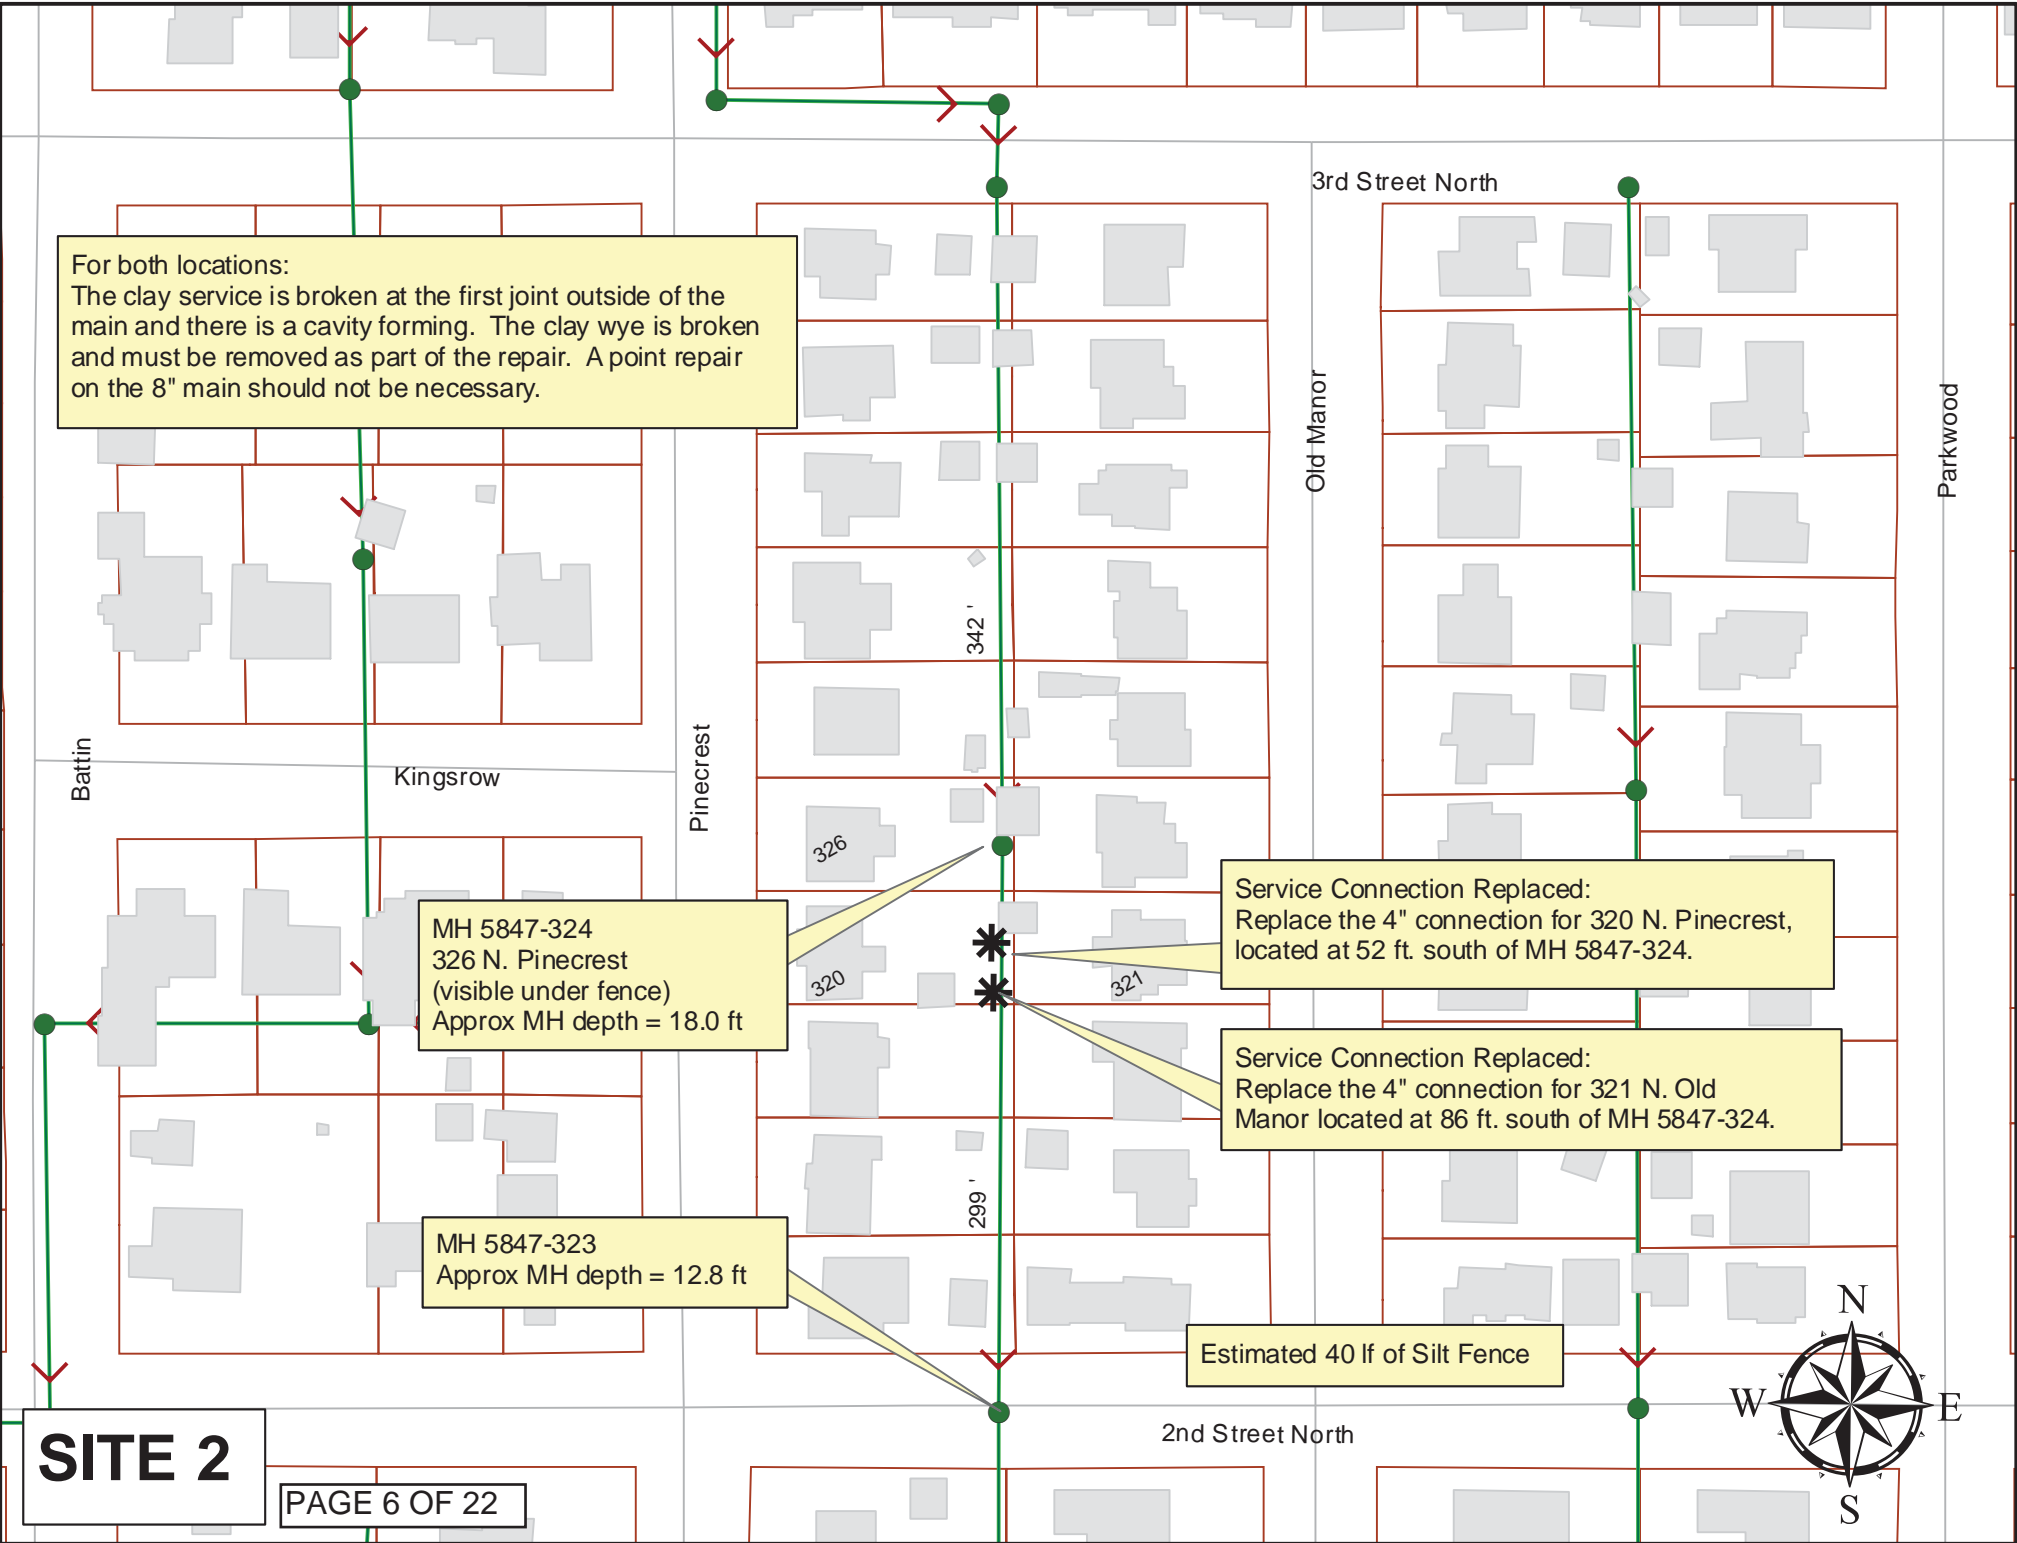

E KINGSROW ST

N PINECREST AVE

N OLD MANOR RD

MH 5847-324

320

321



Video Inspection Master Report

8/17/2012
7:53 AM

US Structure: 5847-324 **326 N PINECREST ST** **Date Insp:** 5/24/2012 **Basin:** E04D
DS Structure: 5847-323 **301 N OLD MANOR ST** **Dir Televised:** Upstream To Downstream

Pipe Information
Shape: Round **Length Status:** VCP **Project No.:** E-036
Dia/Ht: 8 **Material:** **Index:**
Length: 299.1 **Slope:** 0.400 **Surface:** Rear Easement

Obs. #	VTR	Distance	Location	Description	Rating	Ratings		Remain (gpm)
						Obsrvd (gpm)	Est. (gpm)	
1		0.0		5847-324 US Manhole	1			
2		9.9	326 N PINECREST	Wye Service	1			
3		22.0		Sealed Off Wye	1			
4		25.0		Sealed Off Wye	1			


5 52.5 320 N PINECREST 4" Wye Service 5 Cavity outside of the main / shed & tree

6		55.7		Sealed Off Wye	1			
7		82.9		Sealed Off Wye	1			


8 86.1 321 N OLD MANOR 4" Wye Service 5 Disconnected from the main

9		113.1		Sealed Off Wye	1			
10		116.0	315 N OLD MANOR	Break-In Conn	2			
11		142.7	314 N PINECREST	Wye Service	1			
12		146.9		Sealed Off Wye	1			
13		174.4		Sealed Off Wye	1			
14		177.2		Sealed Off Wye	1			
15		205.0	308 N PINECREST	Wye Service	4			
16		208.0	309 N OLD MANOR	Wye Service	1			
17		235.4		Sealed Off Wye	1			
18		238.7		Sealed Off Wye	1			
19		266.2	302 N PINECREST	Wye Service	2			
20		269.2	301 N OLD MANOR	Wye Service	2			
21		299.3		DS Manhole 5847-323	1			