

**WATER DISTRIBUTION SYSTEM IMPROVEMENTS
GREENWICH BUSINESS CENTER
PHASE 2**


LINE 1
SHEET TITLE
448-90519
PROJECT NUMBER

DFL / KKL / GJA
DESIGNED / DRAWN / CHECKED

ISSUED
September 2012
REVISED

SHEET NO.
4 of 13

STONEY POINTE ADD.

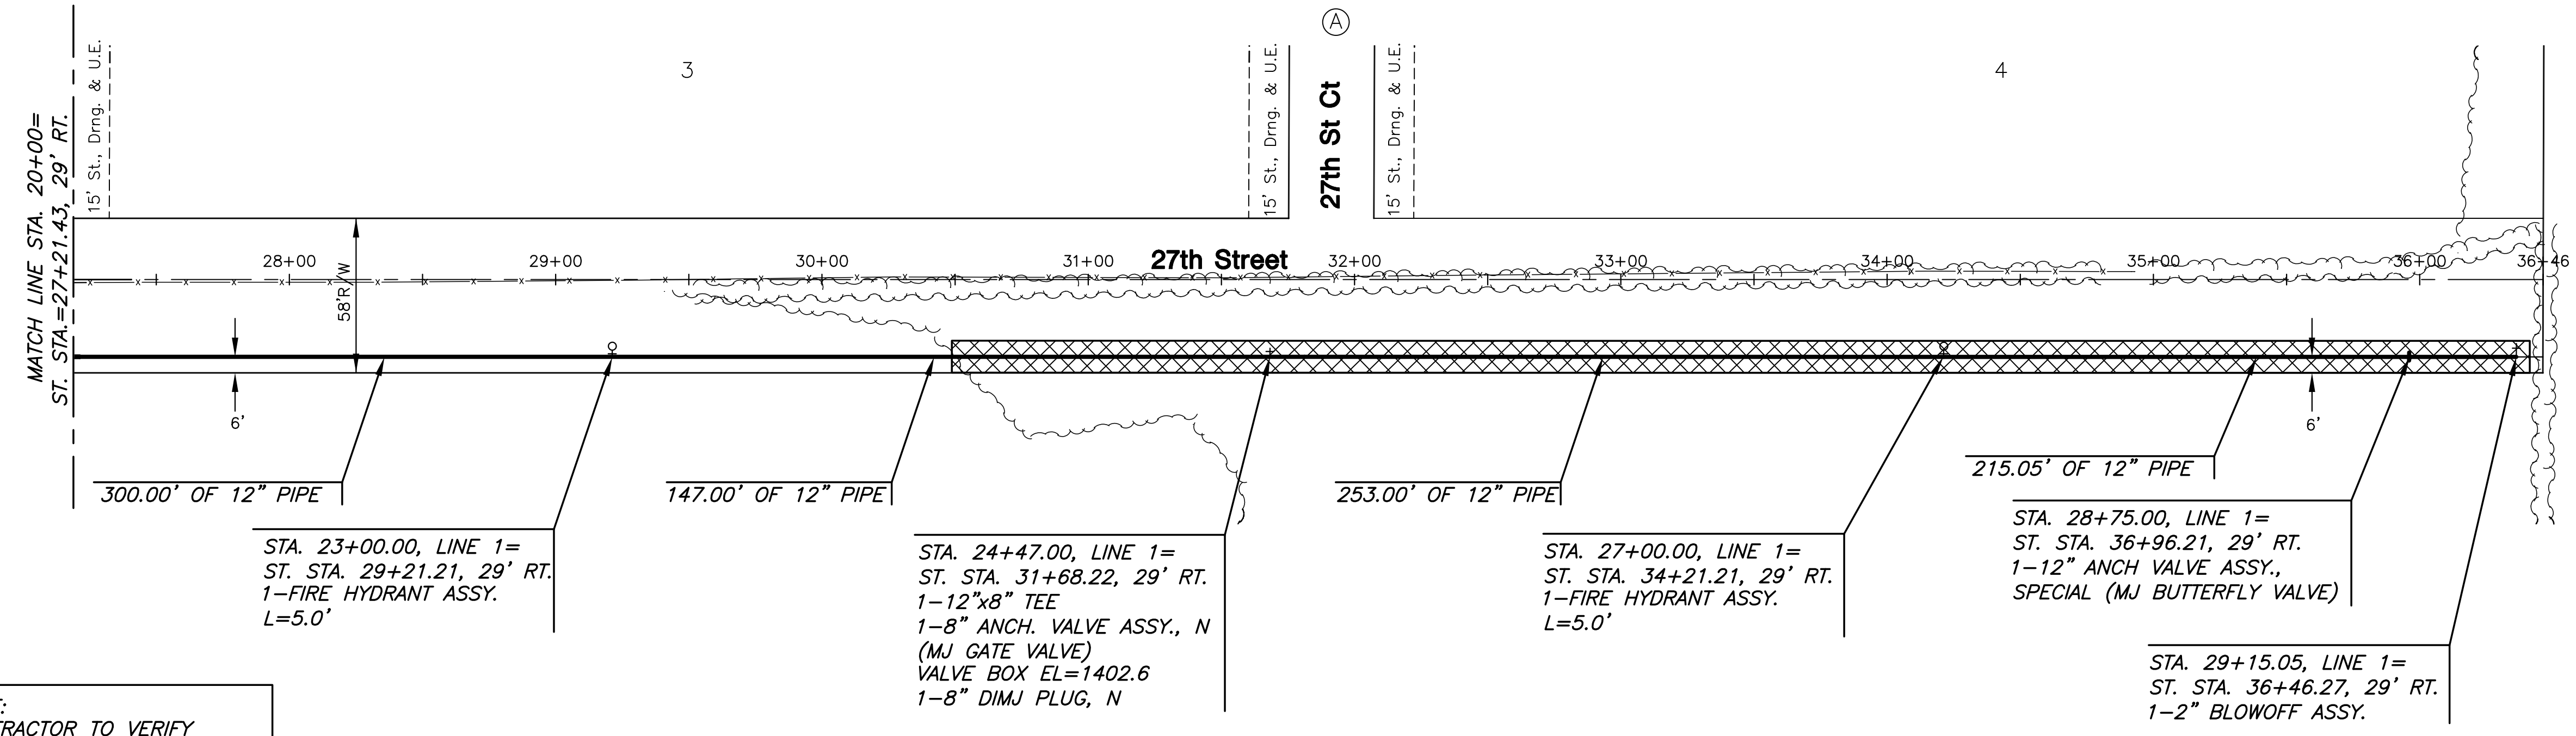

NOTE:
CONTRACTOR TO VERIFY
LOCATION AND ELEVATION OF
EXISTING WATER LINE AND
ALL OTHER UTILITIES PRIOR
TO CONSTRUCTION.

**PLAN LINE 1
PROFILE LINE 1**

