1510 PPW

WATER DISTRIBUTION SYSTEM IMPROVEMENTS

TO SERVE

WICHITA MID-CONTINENT AIRPORT

PRIVATE PROJECT NO. 1510 PPW (607853)

CITY OF WICHITA, KANSAS

JAMES L. ARMOUR, P.E. - CITY ENGINEER

HNTB

HNTB Architecture
The HNTB Companies
715 Kirk Drive
Kansas City, Missouri 64105
(816) 472-1201 Fax (816) 472-4063

GossenLivingston Architecture
420 South Emporia
Wichita, KS 67202
Tel: (316) 265-5887
Fax: (316) 265-5646
Email: architects@gla1.com

Professional Engineering Consultants, P.A.
303 S. TOPEKA • WICHITA, KANSAS 67202
316-262-2691 • FAX 316-262-3003
www.pec1.com

INDEX OF SHEETS

SHEET NO. CU100	WATERLINE TITLE SHEET
SHEET NO. CU101	WATERLINE KEY MAP AND GENERAL NOTES
SHEET NO. CU102	WATERLINE HORIZONTAL AND VERTICAL CONTROL
SHEET NO. CU103	STANDARD WATER ASSEMBLY DETAILS
SHEET NO. CU104	WATERLINE NO. 1 PLAN/PROFILE
SHEET NO. CU105	WATERLINE NO. 2 PLAN/PROFILE
SHEET NO. CU304-CU306	SOIL EROSION BMP DETAILS

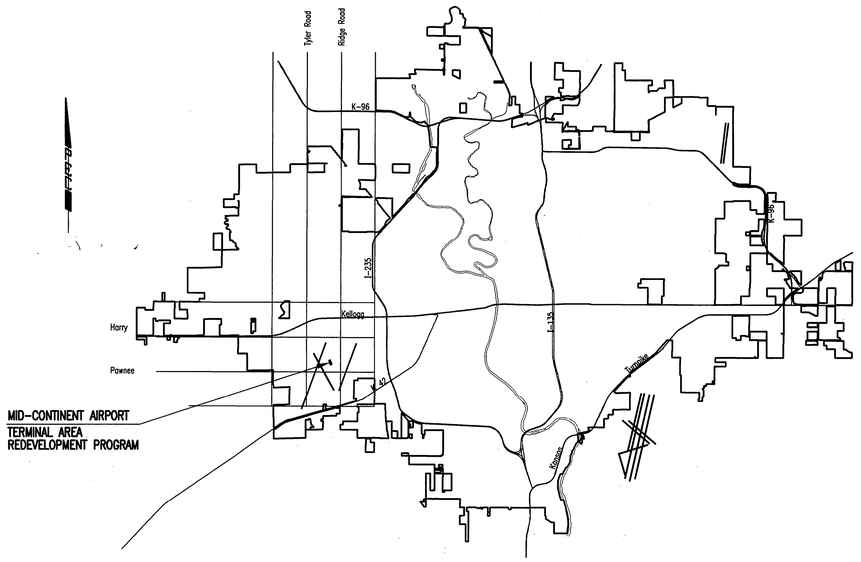

LOCATION MAP

APPROVED AS NOTED
BY CITY ENGINEER OF WICHITA,
BY WICHITA WATER UTILITIES,
& BY WICHITA FIRE DEPARTMENT

Water Mains (Public Works) [signature] 12/29/09

Water Mains (Water Utilities) [signature] 12/30-09

Fire Prot. Line Bob Thompson WFD 1-04-10

NOTE TO CONTRACTORS

PUBLIC PROPERTY:
Inspection and testing for the waterline is to be provided by a Licensed Consulting Engineering Firm under contract with the Owner/Developer. Said inspection to be in accordance with the City of Wichita standard construction engineering practices and certified by a Licensed Professional Engineer licensed in the State of Kansas. No work shall be performed in dedicated easements or public right-of-way by the Contractor without such inspection nor shall any work be commenced without written authorization by the City Engineer. All Construction and Materials shall comply with the City of Wichita Specifications and Standards (on file and available in the City Engineer's Office).

PRIVATE PROPERTY:
Installation and testing for the fire protection line is to be performed by a City of Wichita licensed fire protection contractor in accordance with the fire codes as adopted by the City of Wichita. All materials and construction practices for the fire protection line shall comply with the fire codes as adopted by the City of Wichita (available from the City of Wichita Fire Department). The Contractor shall not commence work without notification and approval of the Wichita Fire Department.
Inspection of the fire protection line is to be provided by the City of Wichita Fire Department and by a licensed Consulting Engineering Firm under contract with the Owner/Developer.
The contractor shall not start work until the project inspector is assigned to the project and present on the site. Any work done without inspection will be required to be uncovered for inspection.

WICHITA MID-CONTINENT AIRPORT
Air Capital Terminal 3
PACKAGE # 3
LANDSIDE UTILITIES PHASE I &
MID-CONTINENT DRIVE RELOCATION

ISSUE: BID SET

DATE:	JUNE 8, 2009
HNTB PROJECT NO.:	34912
CLIENT PROJECT NO.:	06481
DRAWN BY:	
CHECKED BY:	
APPROVED BY:	

REVISION	DATE	DESCRIPTION
△		
△		
△		
△		
△		

WATERLINE TITLE SHEET

CU100

DECEMBER 2009

PLANS PREPARED BY

PROFESSIONAL ENGINEERING CONSULTANTS, P.A.

ENGINEERS
WICHITA, KANSAS

RECORD DRAWINGS
CONTRACTOR: Dondlinger & Sons Construction Co., Inc,
INSPECTOR: Ken Tompkins (PEC-Allied Lab)
Date of Substantial Completion: 04/27/2010

DARWIN R. CRONK LICENSED 14896 KANSAS PROFESSIONAL ENGINEER 12-29-09

CITY OF WICHITA PROJECT NO. 1510 PPW (607853)

Copyright HNTB Corporation 2009

Saved 12-29-2009 8:42:48 AM by NCL
Plot Scale 1:1 12-29-2009 9:02:16 AM by NCL
Q:\2006\06481\003\PACKAGE 3 LANDSIDE UTILITIES AND LOOP ROAD\2009-12-03 CHANGE ORDER\PPW\06481-003-CU100-PPWLTitle