



FHWA REGION NO.	STATE	PROJECT NO.	FISCAL YEAR	SHEET NO.	TOTAL SHEETS
7	KANSAS	87N-0503-01	2009	3	3

FEDERAL Project No. ARRA-N050(301)

**4'x6'-6" Reinforced Concrete Manhole Details**  
(Upstream Manhole Shown)



See "Std. Reinforced Concrete Manhole Detail", Sheet 45 of Paving Plans for Reinforcing Information.

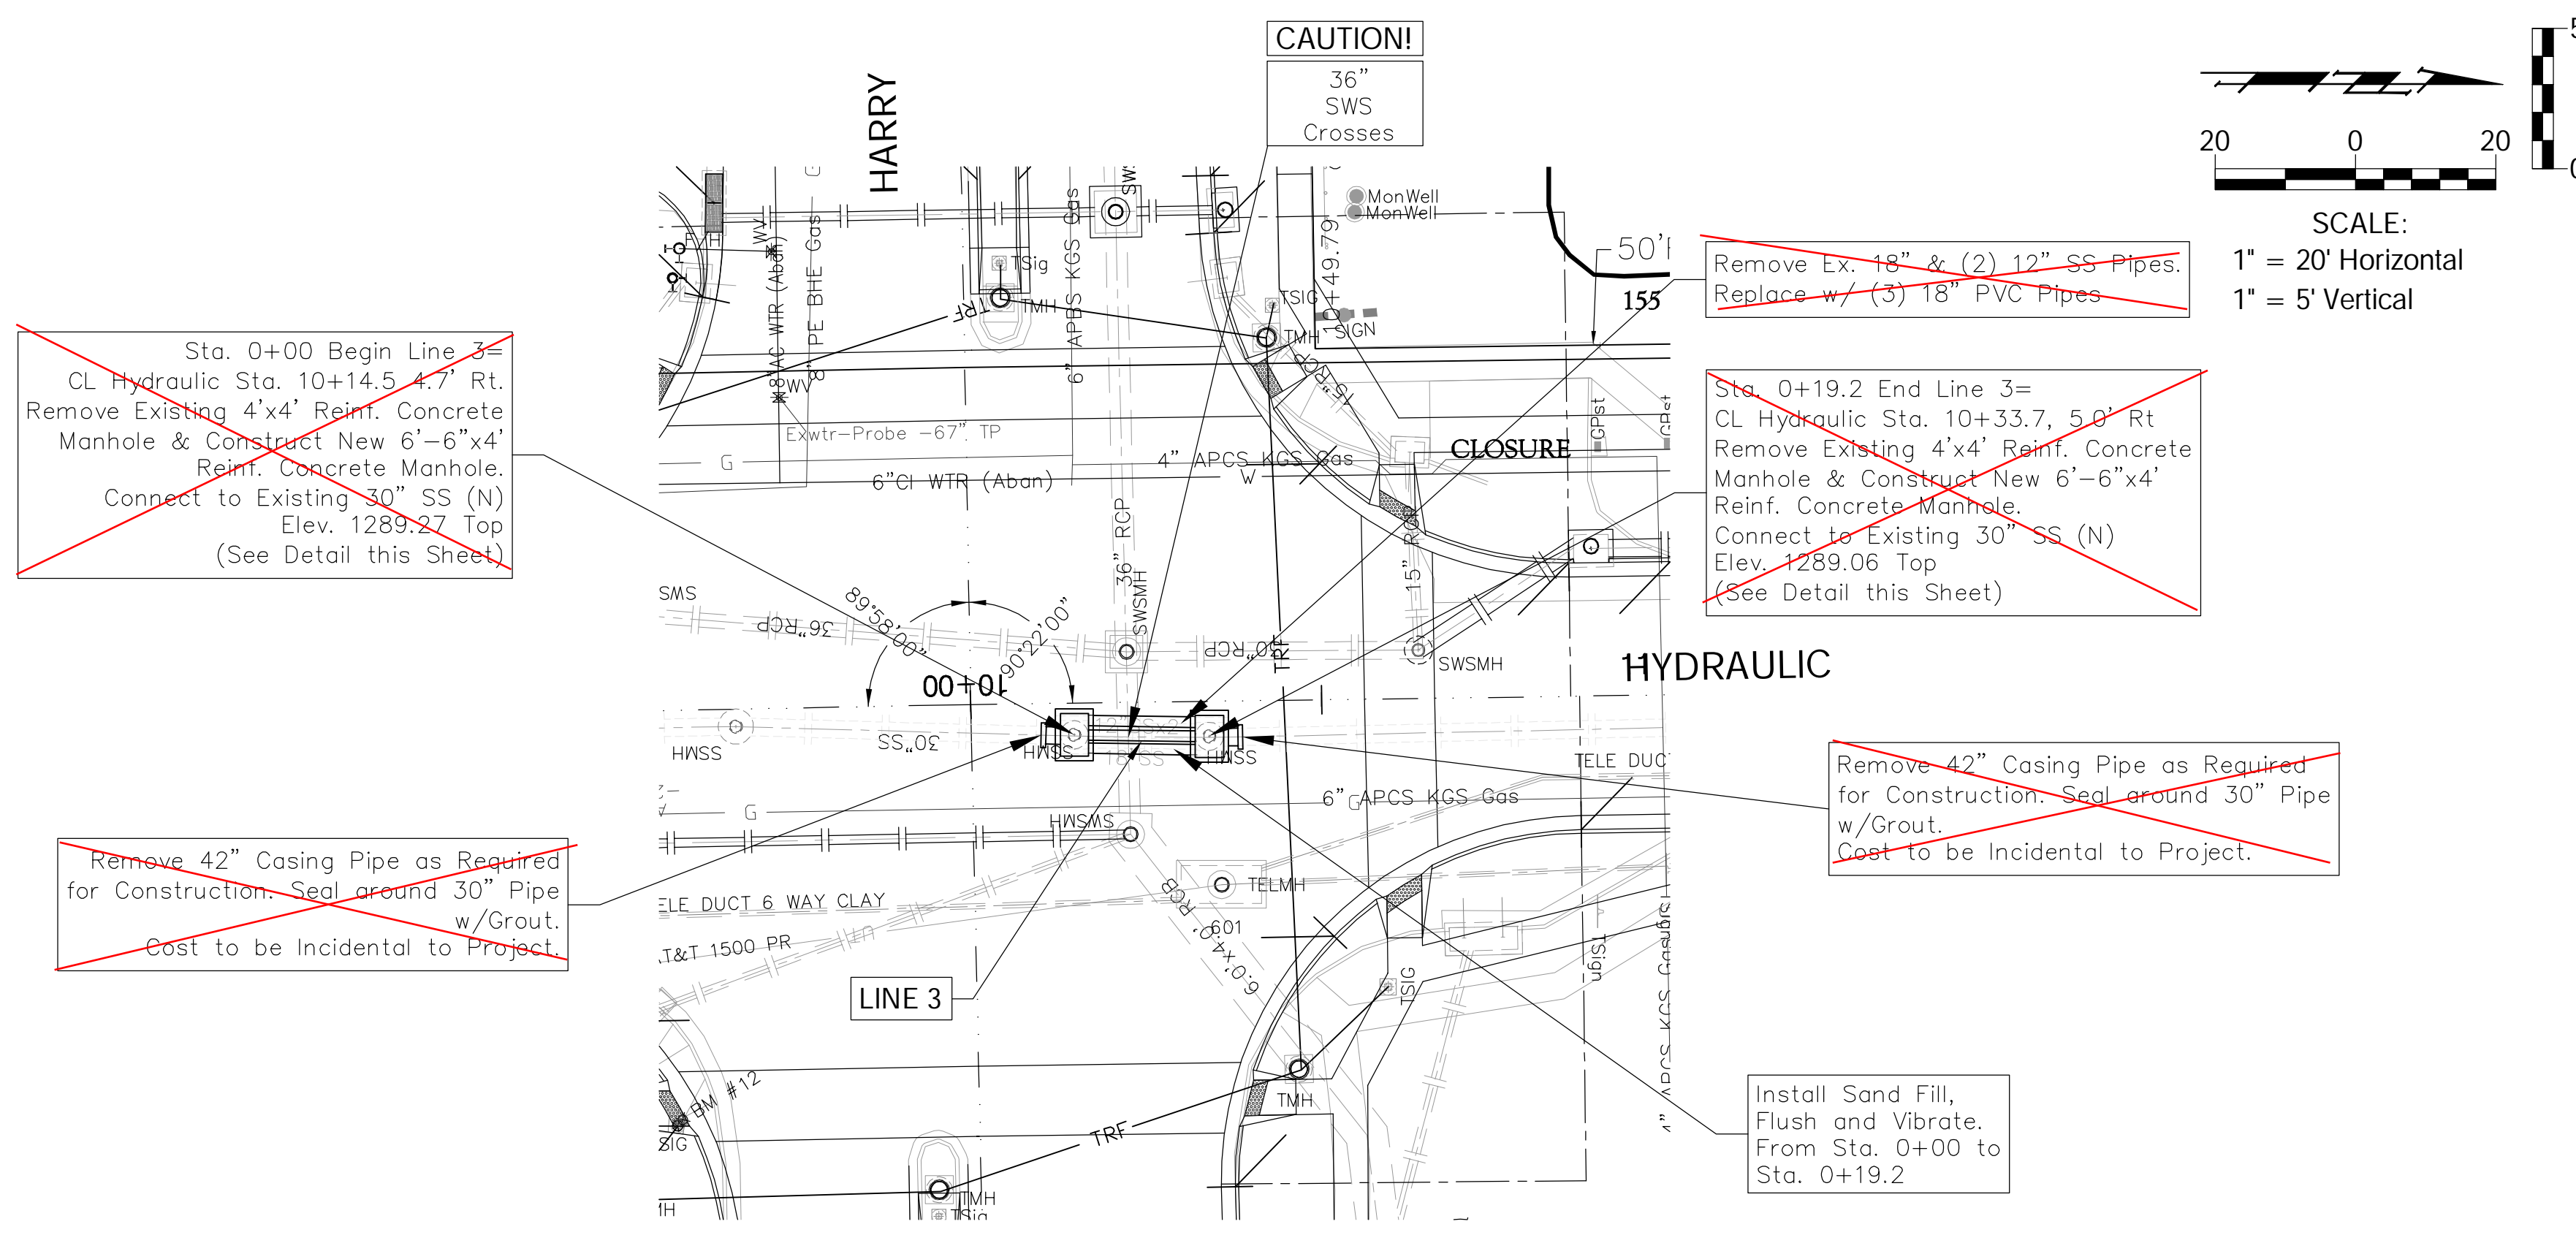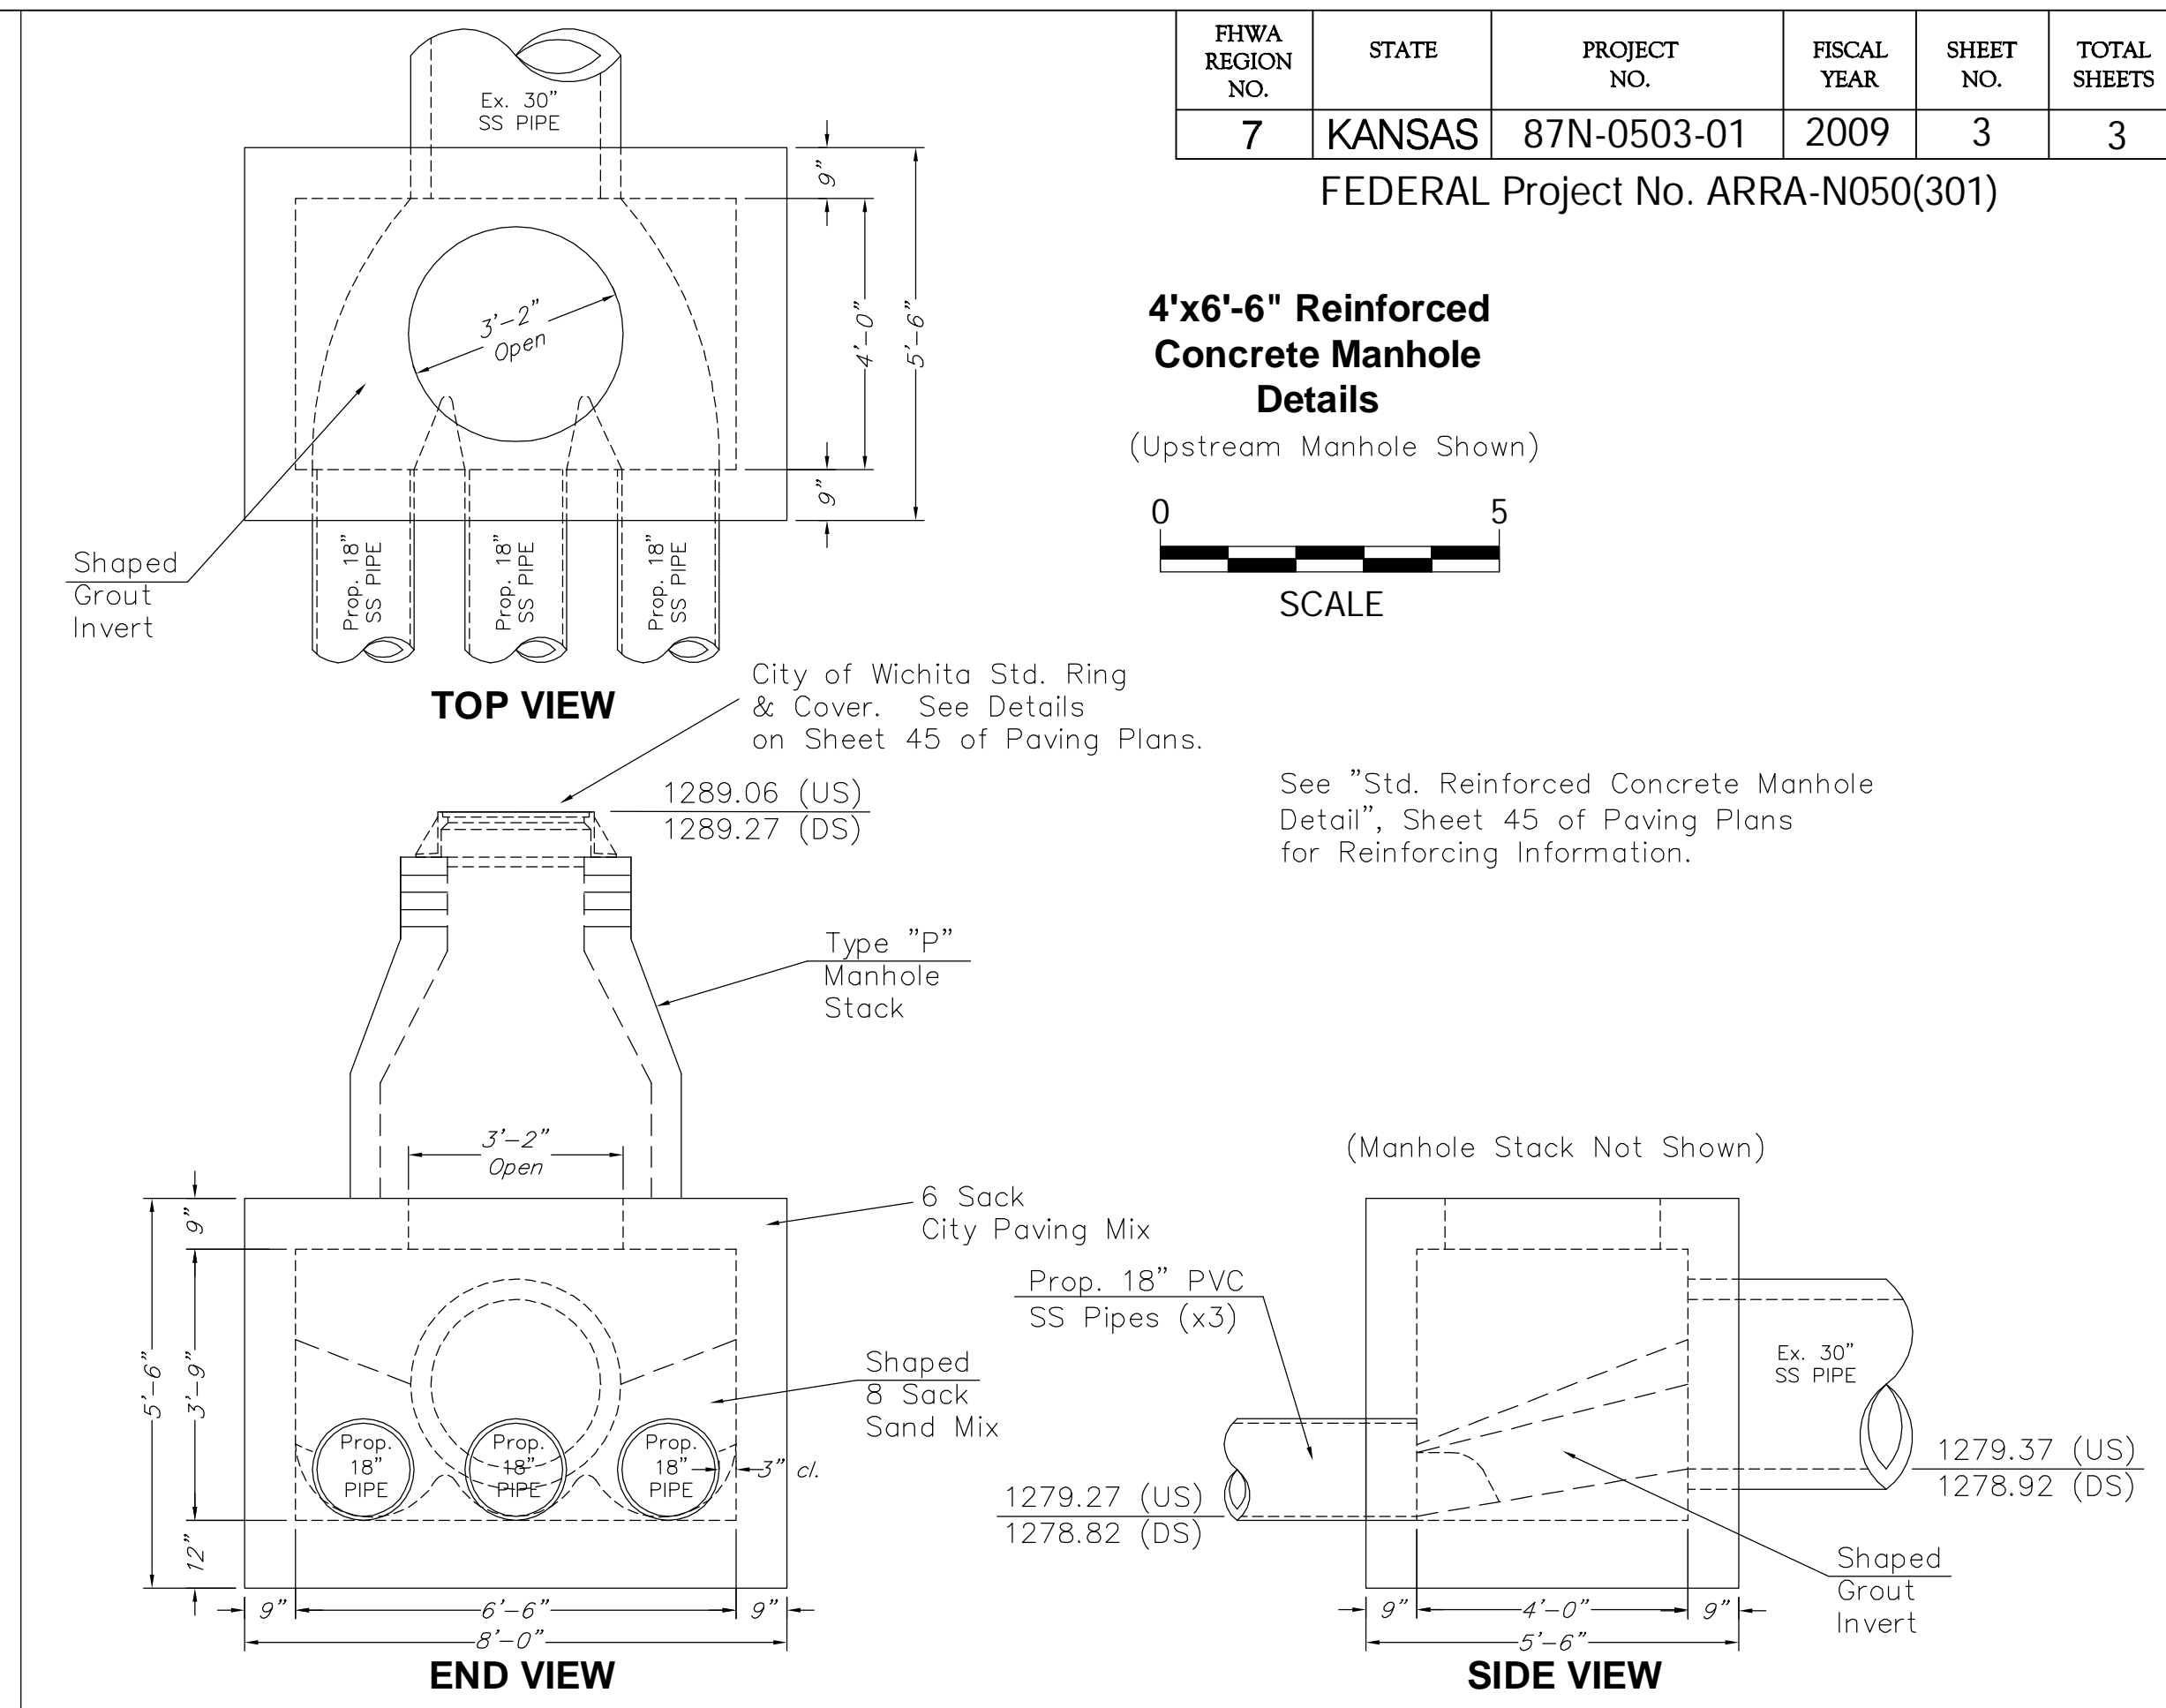

**Line 3**

**NO RECONSTRUCTION DONE DUE TO CONFLICT ON SS & SWS. SS LINED WITH CIPP (See Change Order #2)**

NOTE: Pavement Removed Shall be Replaced With Temporary Asph. Pvmnt. (6").

