



Sierra Hills 2nd Addition

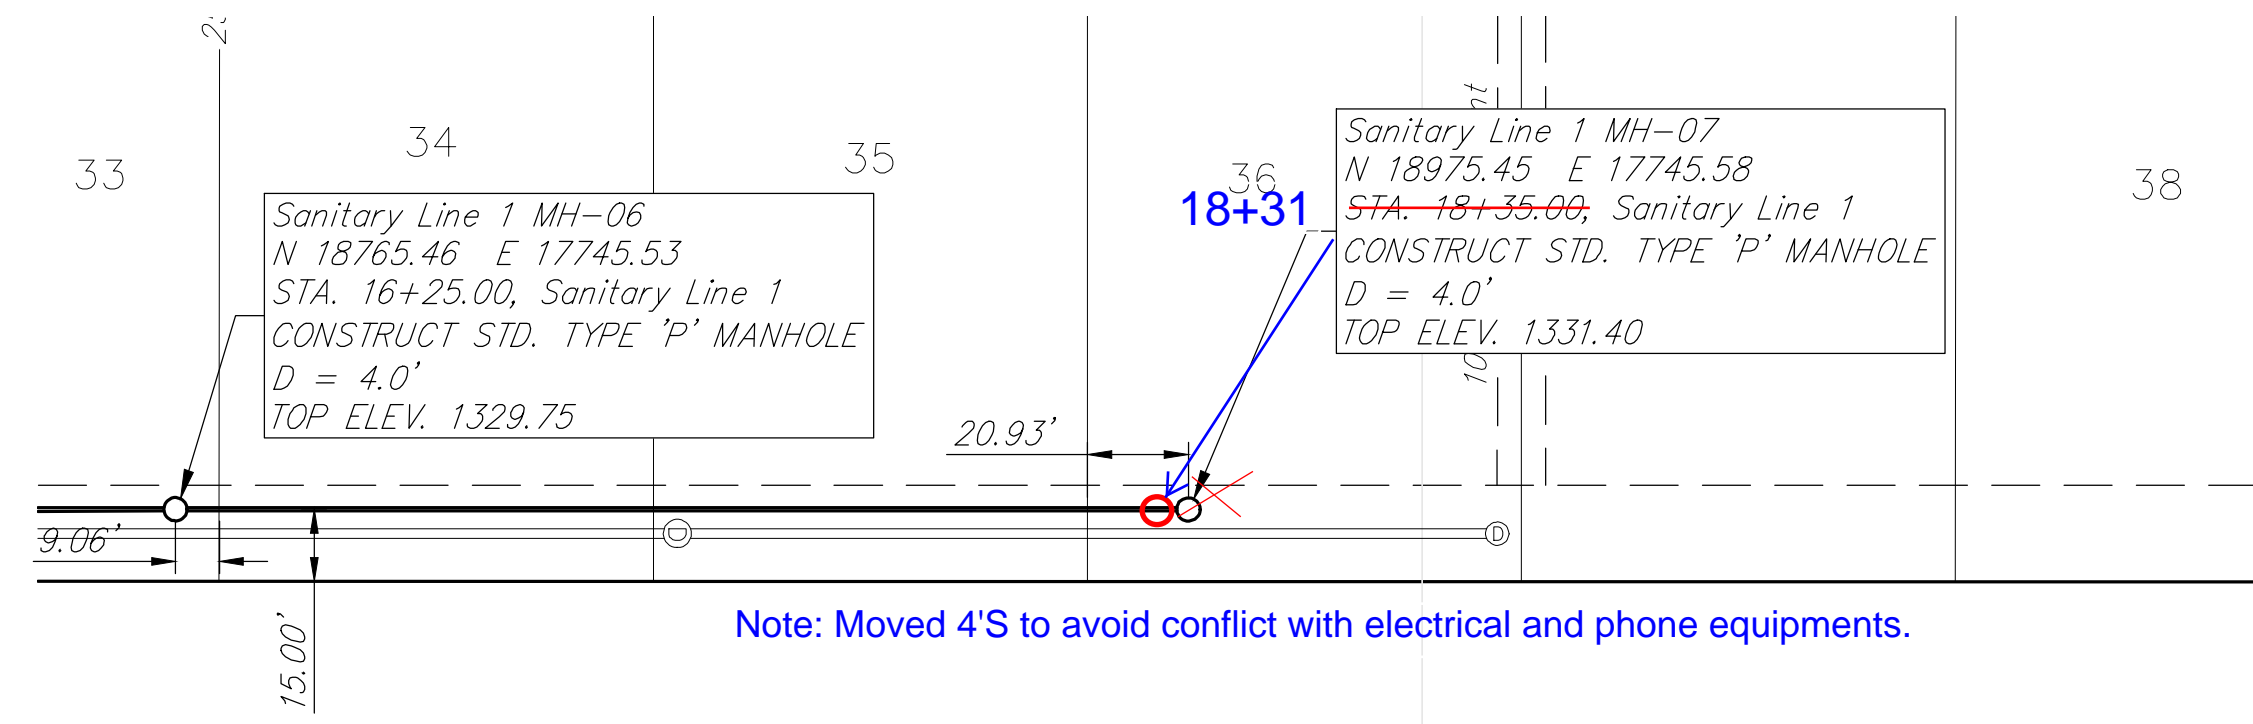

Sierra Hills 2nd Addition

Ruggles & Bolmer, P.A.
Engineering, Surveying, Land Planning
100 North Main
Wichita, Kansas 67203
www.ruggles.com

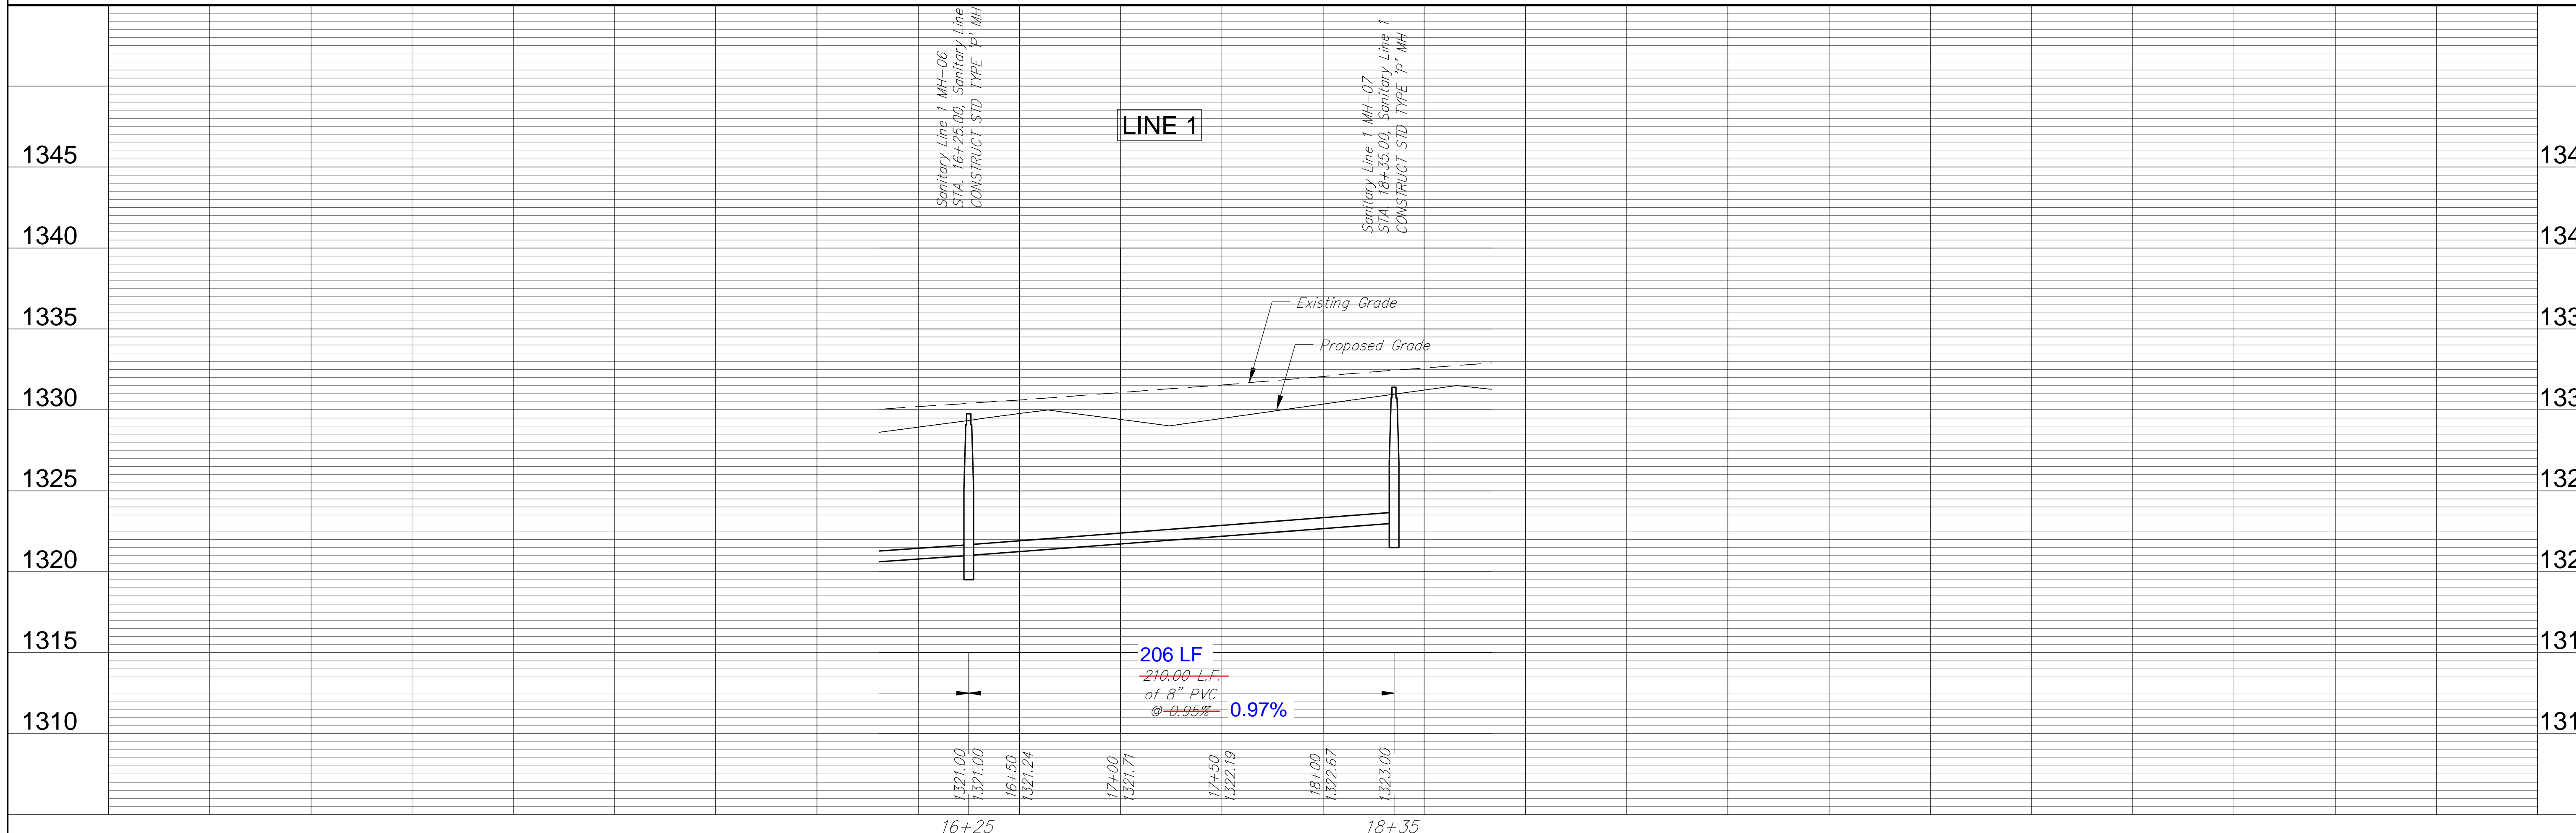

REVISION
DRAWN
DESIGN
DATE
APRIL 24, 2012

PROJECT NUMBER
488-8884
DRAWING FILE
SS {SS Line 1 (3)}

Sanitary Sewer
Line 1
WICHITA, KANSAS

RB JOB
3929E
SHEET
4
of
13