


SEWER SERVICE TABLE

NUMBER	TYPE	LOCATION			FOR INFORMATION ONLY	
		LOT NO.	BLOCK NO.	LINE NO.	STATION \ DIRECTION	APPROXIMATE LENGTH 4" PIPE VERTICAL      HORIZONTAL
1	8" X 4" Tee Saddle	1	2	1	-0+46/Rt. 0+47.6 8.0'	-22.0' 22.5'
2	8" X 4" Tee Saddle	8	2	1A	-0+65/Lt. 0+66.5 12.0'	-13.0' 14.0'

NOTE: Vertical Riser Pipe shall be extended to 2' minimum above ground water elevation and 4' maximum below proposed ground elevation.

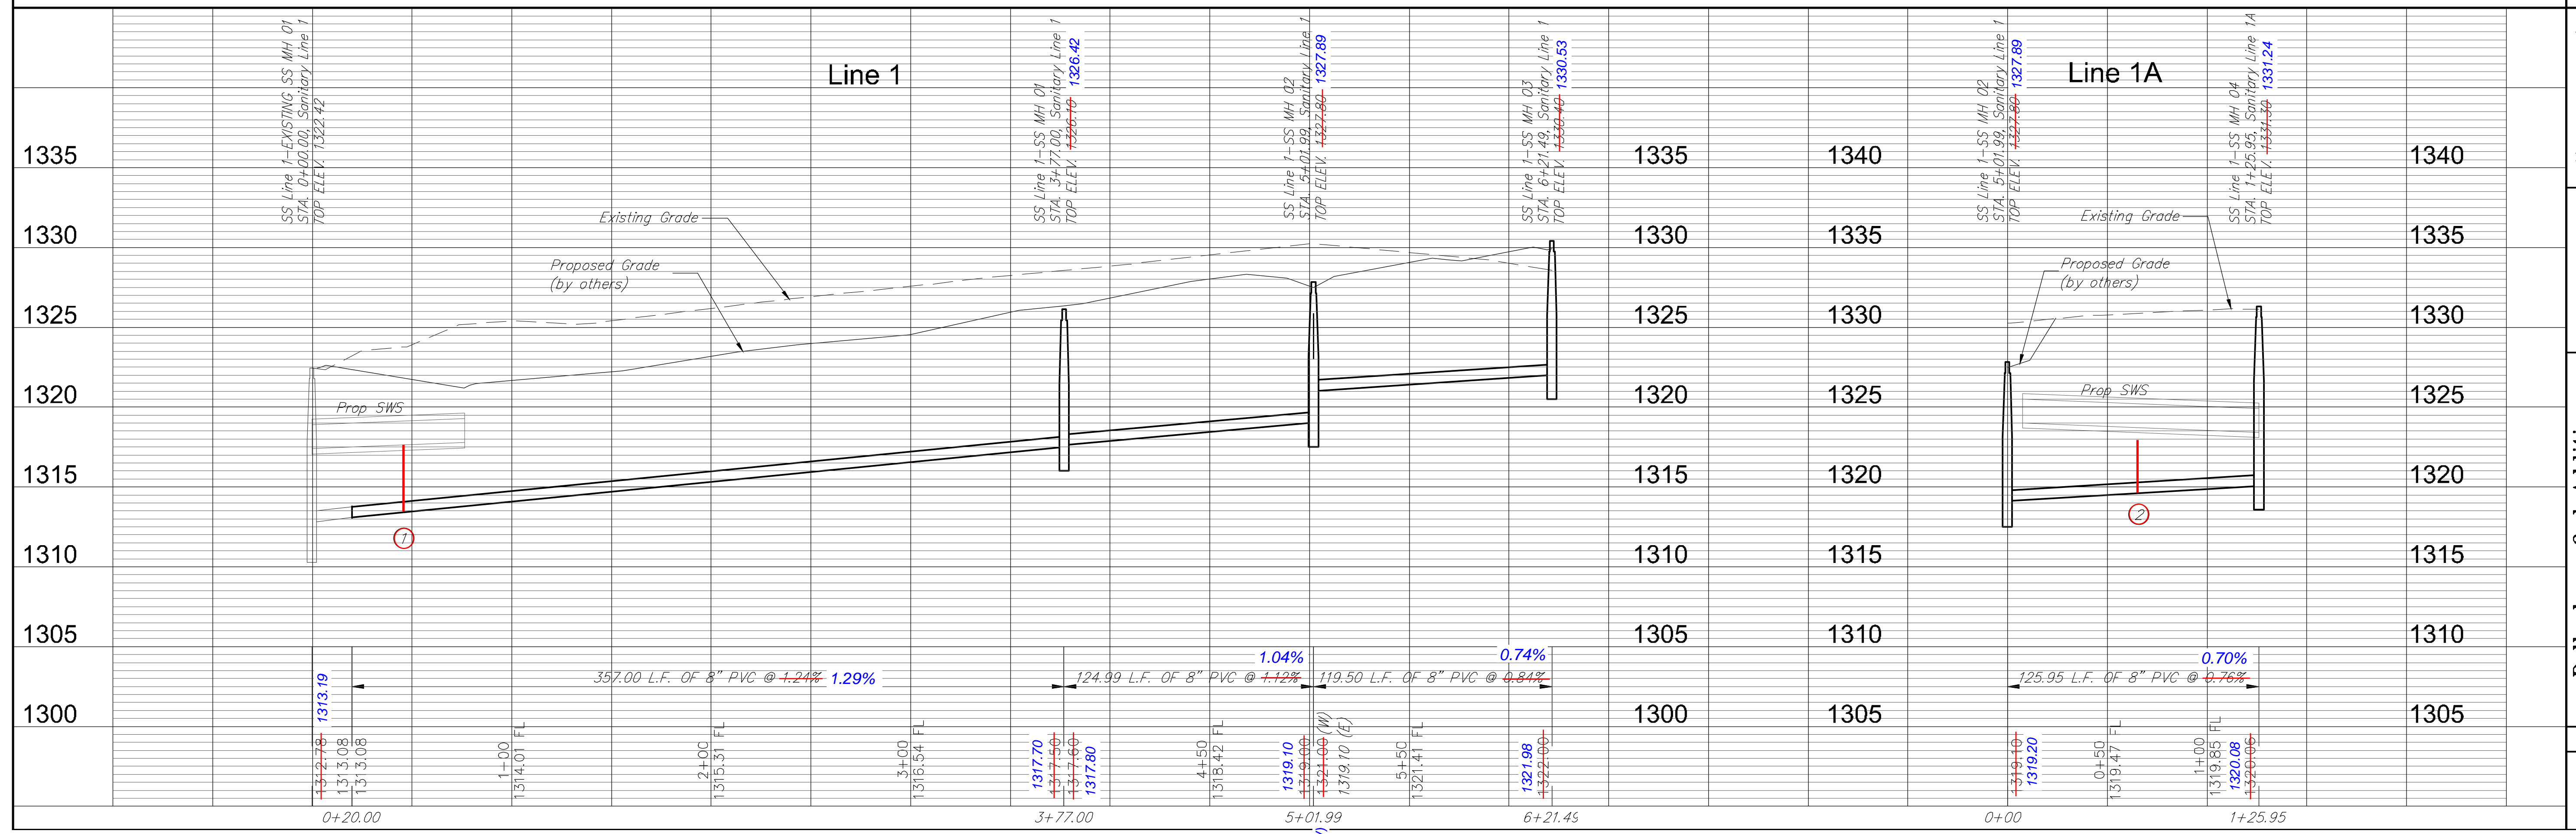

**Bellechase 3rd Addition  
SS LINE 1 & 1A  
WICHITA, KANSAS**

PROJECT NUMBER 468-84658	DRAWING FILE Eng Base SS Line 1 & 1A	DESIGN EUG	UTILITY	DATE Feb. 5, 2013	REVIEW
		REVIEW	REVIEW	REVIEW	REVIEW

Ruggles & Bohm, L.A.  
 Engineering, Surveying, Land Planning  
 800 North Main  
 Wichita, Kansas 67202  
 www.rugglesandbohm.com

RB JOB  
4057E  
SHEET  
2  
15