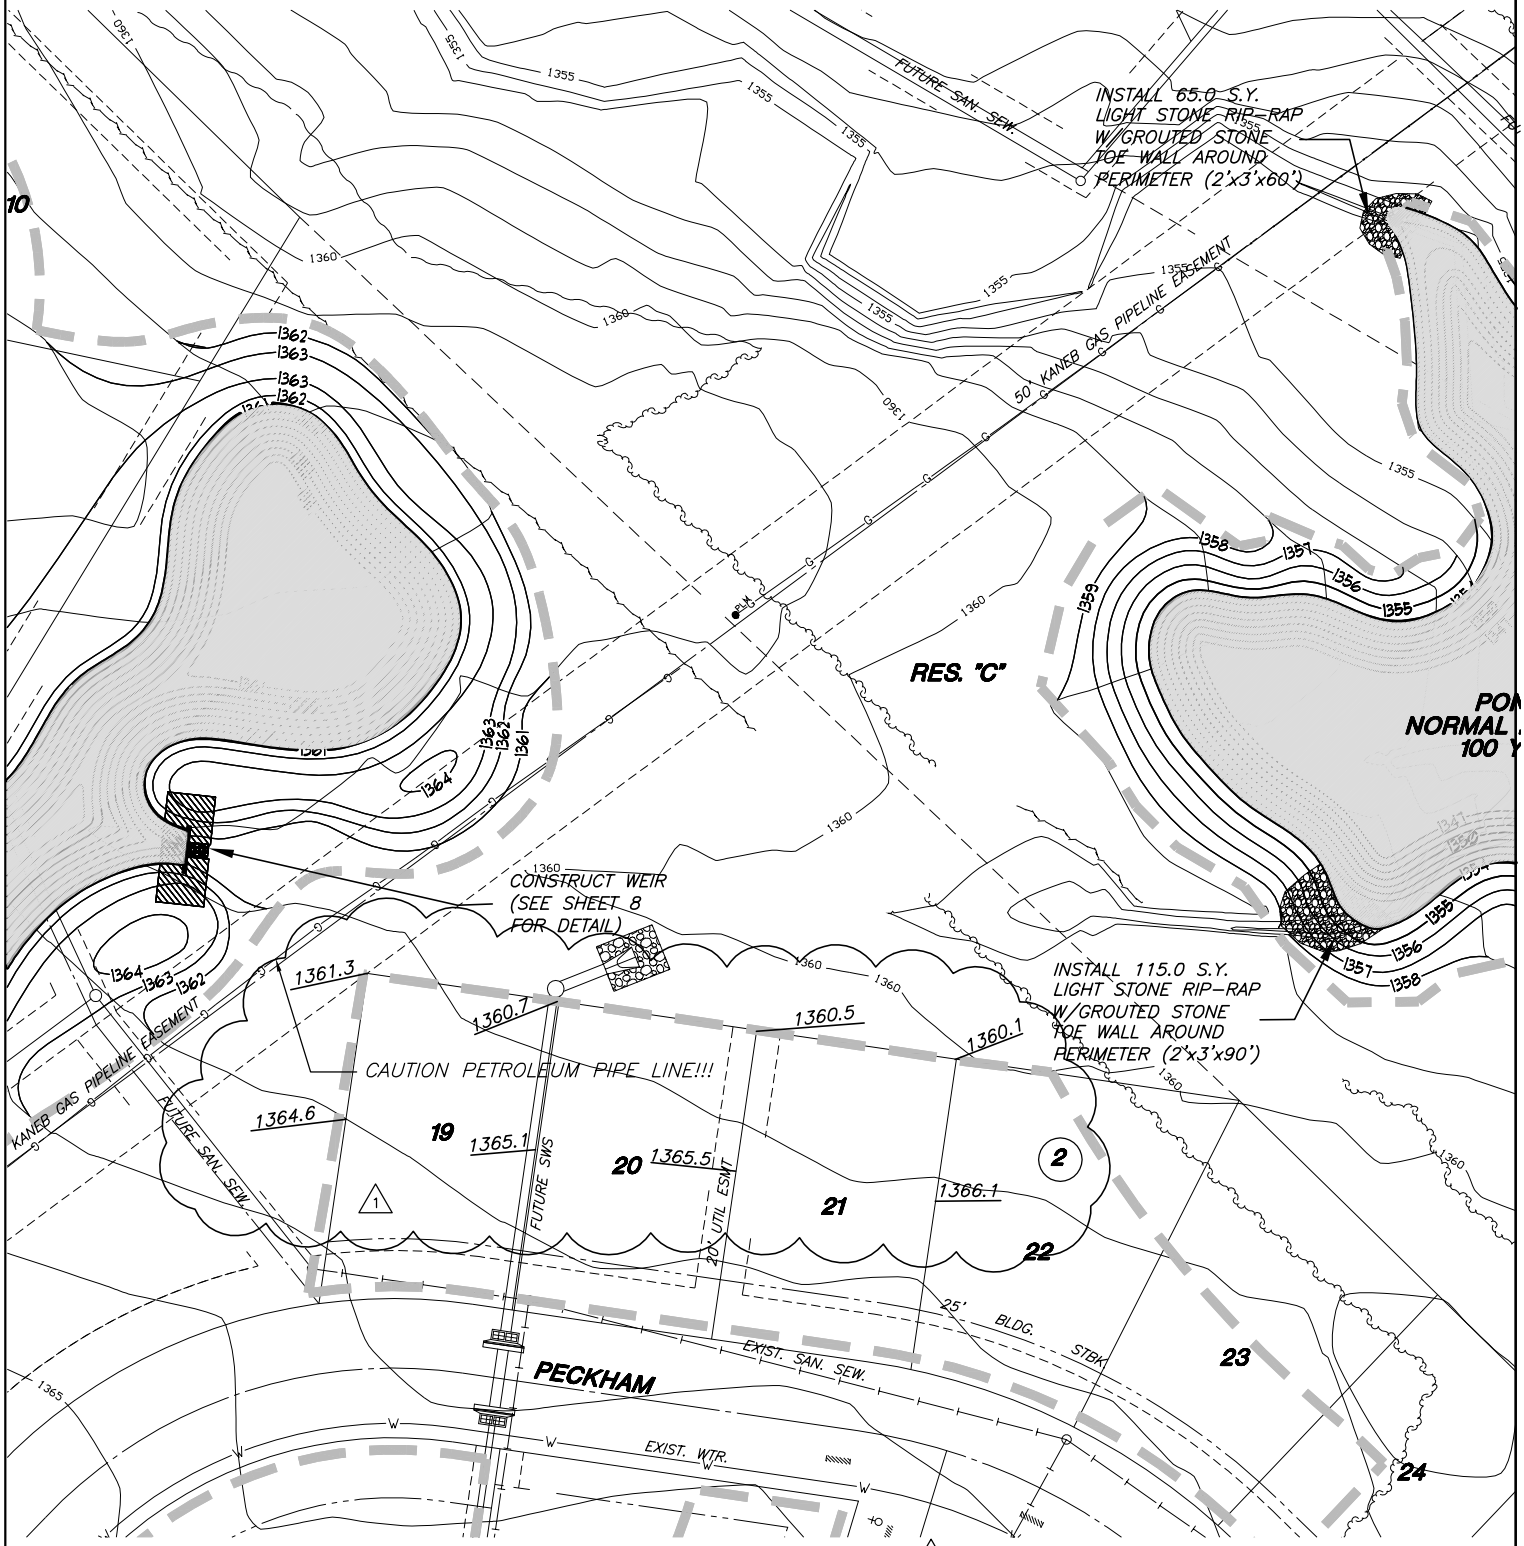

1 REVISION 02/17/03

0 40 80 160

SCALE: 1" = 40'

H:\CIVIL\02167\DWG\GRAD\PONDS\02167GD1

MKEC ENGINEERING CONSULTANTS
411 N. WEBB ROAD
WICHITA, KS. 67206
316 - 684 - 9600

HAWTHORNE ADDITION
PROJECT NAME

PARTIAL (REVISION)
SHEET TITLE

DRK	DMU	DRK
DESIGN BY:	DRAWN BY:	CHECKED BY:
JANUARY 2003	02167	3 / 46
DATE	JOB NO.	SHEET/OF