



1 REVISION 02/17/03

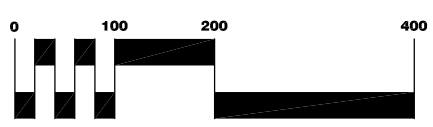

SCALE: 1" = 100'

H:\CIVIL\02167\DWG\GRAD\PONDS\02167LGI

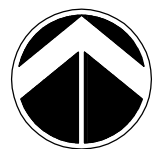

MKEC
 ENGINEERING CONSULTANTS
 411 N. WEBB ROAD
 WICHITA, KS. 67206
 316 - 684 - 9600

HAWTHORNE ADDITION
 PROJECT NAME

PARTIAL (REVISION)
 SHEET TITLE

DRK DESIGN BY:	DMU DRAWN BY:	DRK CHECKED BY:
JANUARY 2003 DATE	02167 JOB NO.	13 / 46 SHEET/OF