


| Point Table | | | |
|-------------|----------|----------|-----------------|
| Point # | Northing | Easting | Raw Description |
| 1 | 18732.55 | 11316.63 | Iron |
| 2 | 18776.01 | 11269.65 | Iron |
| 3 | 18804.64 | 11238.69 | Iron |
| 4 | 18851.62 | 11282.15 | Iron |
| 5 | 18822.67 | 11194.95 | Iron |
| 6 | 18886.63 | 11197.23 | Iron |
| 7 | 18953.71 | 11067.66 | Iron |
| 8 | 18954.14 | 11131.65 | Iron |
| 9 | 19022.53 | 11067.20 | Iron |
| 10 | 19021.60 | 10927.20 | Iron |
| 11 | 19085.59 | 10926.77 | Iron |
| 12 | 19086.53 | 11066.77 | Iron |
| 13 | 19096.47 | 11066.70 | Iron |
| 14 | 19096.90 | 11130.70 | Iron |
| 15 | 19190.06 | 11104.74 | Iron |
| 16 | 19145.11 | 11150.30 | Iron |
| 17 | 19231.35 | 11145.48 | Iron |
| 18 | 19272.63 | 11186.22 | Iron |
| 19 | 19272.37 | 11103.91 | Iron |
| 20 | 19313.65 | 11144.65 | Iron |
| 21 | 19363.63 | 11065.52 | Iron |
| 22 | 19363.88 | 11123.52 | Iron |
| 23 | 19514.87 | 11064.86 | Iron |
| 24 | 19515.12 | 11122.86 | Iron |
| 25 | 19473.31 | 11384.24 | Iron |
| 26 | 19428.35 | 11429.79 | Iron |
| 27 | 19521.64 | 11467.83 | Iron |
| 28 | 19521.36 | 11403.83 | Iron |
| 29 | 19533.36 | 11467.78 | Iron |
| 30 | 19597.36 | 11467.50 | Iron |
| 31 | 19534.01 | 11615.81 | Iron |
| 32 | 19598.01 | 11615.53 | Iron |
| 33 | 19466.48 | 11684.11 | Iron |
| 34 | 19466.93 | 11748.10 | Iron |
| 35 | 19246.38 | 11685.64 | Iron |
| 36 | 19249.59 | 11749.62 | Iron |
| 37 | 19198.37 | 11596.28 | Iron |
| 38 | 19153.42 | 11641.84 | Iron |
| 39 | 19099.13 | 11588.27 | Iron |
| 40 | 19035.92 | 11652.33 | Iron |
| 41 | 18990.97 | 11697.89 | Iron |
| 42 | 19056.75 | 11672.89 | Iron |
| 43 | 19011.80 | 11718.44 | Iron |
| 44 | 19090.80 | 11686.72 | Iron |
| 45 | 19091.24 | 11750.72 | Iron |
| 46 | 19180.54 | 11686.10 | Iron |
| 47 | 19185.59 | 11750.06 | Iron |
| 48 | 18736.26 | 11840.58 | Iron |
| 49 | 18690.10 | 11884.91 | Iron |
| 50 | 18820.13 | 11995.18 | Iron |
| 51 | 18757.80 | 12009.71 | Iron |
| 52 | 18867.21 | 12032.28 | Iron |
| 53 | 18867.66 | 12096.28 | Iron |
| 54 | 19186.81 | 12030.06 | Iron |
| 55 | 19250.81 | 12029.61 | Iron |
| 56 | 19511.31 | 12027.80 | Iron |
| 57 | 19511.75 | 12091.80 | Iron |
| 58 | 19737.36 | 11466.89 | Iron |
| 59 | 19737.08 | 11402.89 | Iron |

| Point Table | | | |
|-------------|----------|----------|-----------------|
| Point # | Northing | Easting | Raw Description |
| 60 | 19734.98 | 10922.45 | Iron |
| 6001 | 18977.65 | 11125.50 | 0+00.00 |
| 6002 | 19080.91 | 11124.81 | 1+03.27 |
| 6003 | 19112.12 | 11124.60 | 1+34.48 |
| 6004 | 19138.46 | 11135.31 | 1+62.91 |
| 6005 | 19227.62 | 11223.29 | 2+88.17 |
| 6006 | 19311.49 | 11306.05 | 4+06.00 |
| 6007 | 19313.31 | 11307.84 | 4+08.55 |
| 6008 | 19327.54 | 11321.89 | 4+28.55 |
| 6009 | 19329.44 | 11323.76 | 4+31.22 |
| 6011 | 19432.57 | 11425.52 | 5+76.10-PC |
| 6012 | 19521.62 | 11461.83 | 6+74.77-PT |
| 6013 | 19591.33 | 11461.53 | 7+44.48 |
| 6014 | 19707.33 | 11461.02 | 8+60.48 |
| 6015 | 19727.33 | 11460.93 | 8+85.48 |
| 6017 | 19271.87 | 11178.45 | 0+63.00 |
| 6018 | 19319.64 | 11130.04 | 1+31.01 |
| 6019 | 19349.25 | 11117.58 | 1+63.13 |
| 6020 | 19522.65 | 11116.83 | 3+36.53 |
| 6021 | 19539.45 | 11133.48 | 3+60.18 |
| 6022 | 19572.36 | 11133.33 | 3+93.09 |
| 6023 | 19595.53 | 11109.96 | 4+26.00 |
| 6024 | 19595.38 | 11077.05 | 4+58.91 |
| 6025 | 19561.97 | 11043.93 | 5+05.97 |
| 6026 | 19539.05 | 11044.03 | 5+28.88 |
| 6029 | 19079.76 | 10951.81 | 1+73.00 |
| 6030 | 19079.63 | 10931.81 | 1+93.00 |
| 6037 | 19591.38 | 11472.53 | 0+11.00 |
| 6038 | 19591.80 | 11567.53 | 1+06.00 |
| 6039 | 19591.88 | 11587.53 | 1+26.00 |

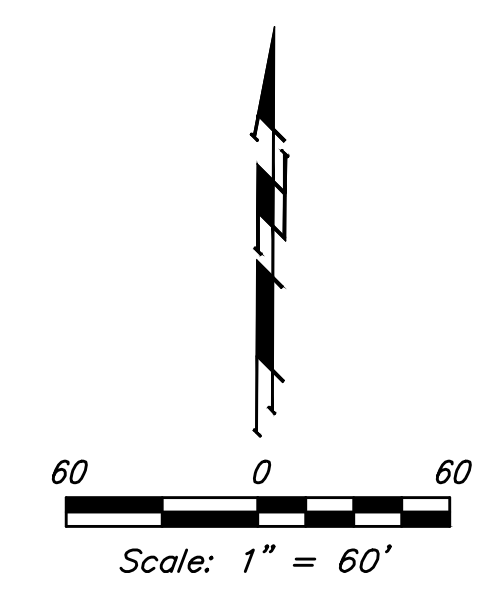

Baughman THE WOODS ADDITION - PHASE 4
COORDINATES
 Water Distribution System

Baughman Company, P.A. 315 Ellis St. Wichita, KS 67211 P 316-262-7271 F 316-262-0149
 ENGINEERING | SURVEYING | PLANNING | LANDSCAPE ARCHITECTURE

| | | |
|-----------------------------|----------------|-------------------|
| PROJECT NUMBER 448-90505 | DESIGN AEG | DRAWN JAK |
| REVISIONS: | APPROVED | DATE 9/17/13 |
| | SCALE Noted | SHEET 12 OF 13 |