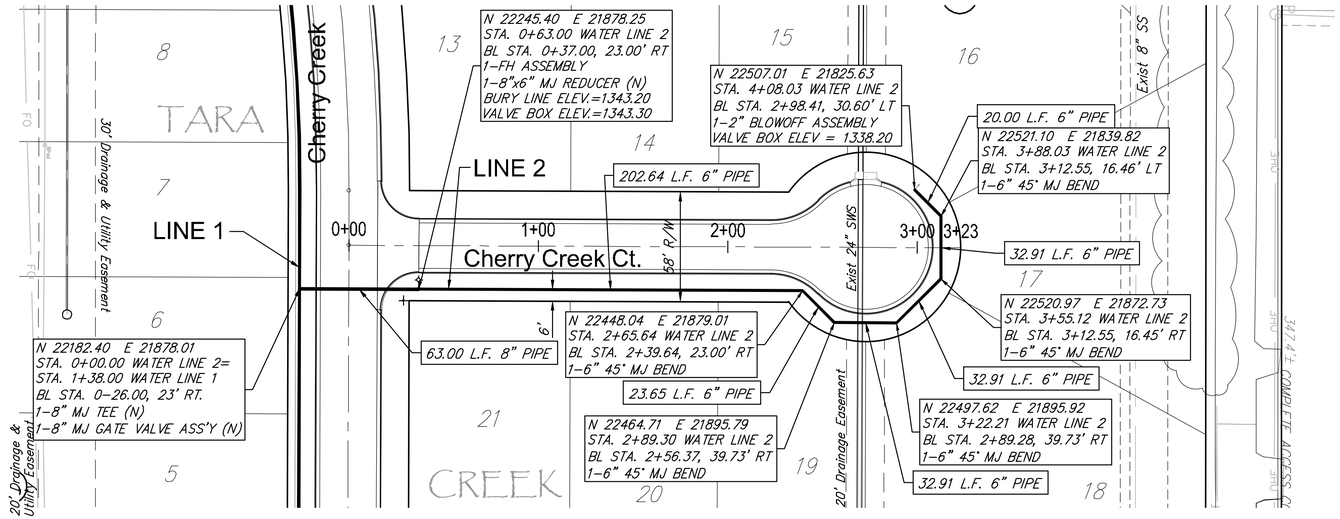

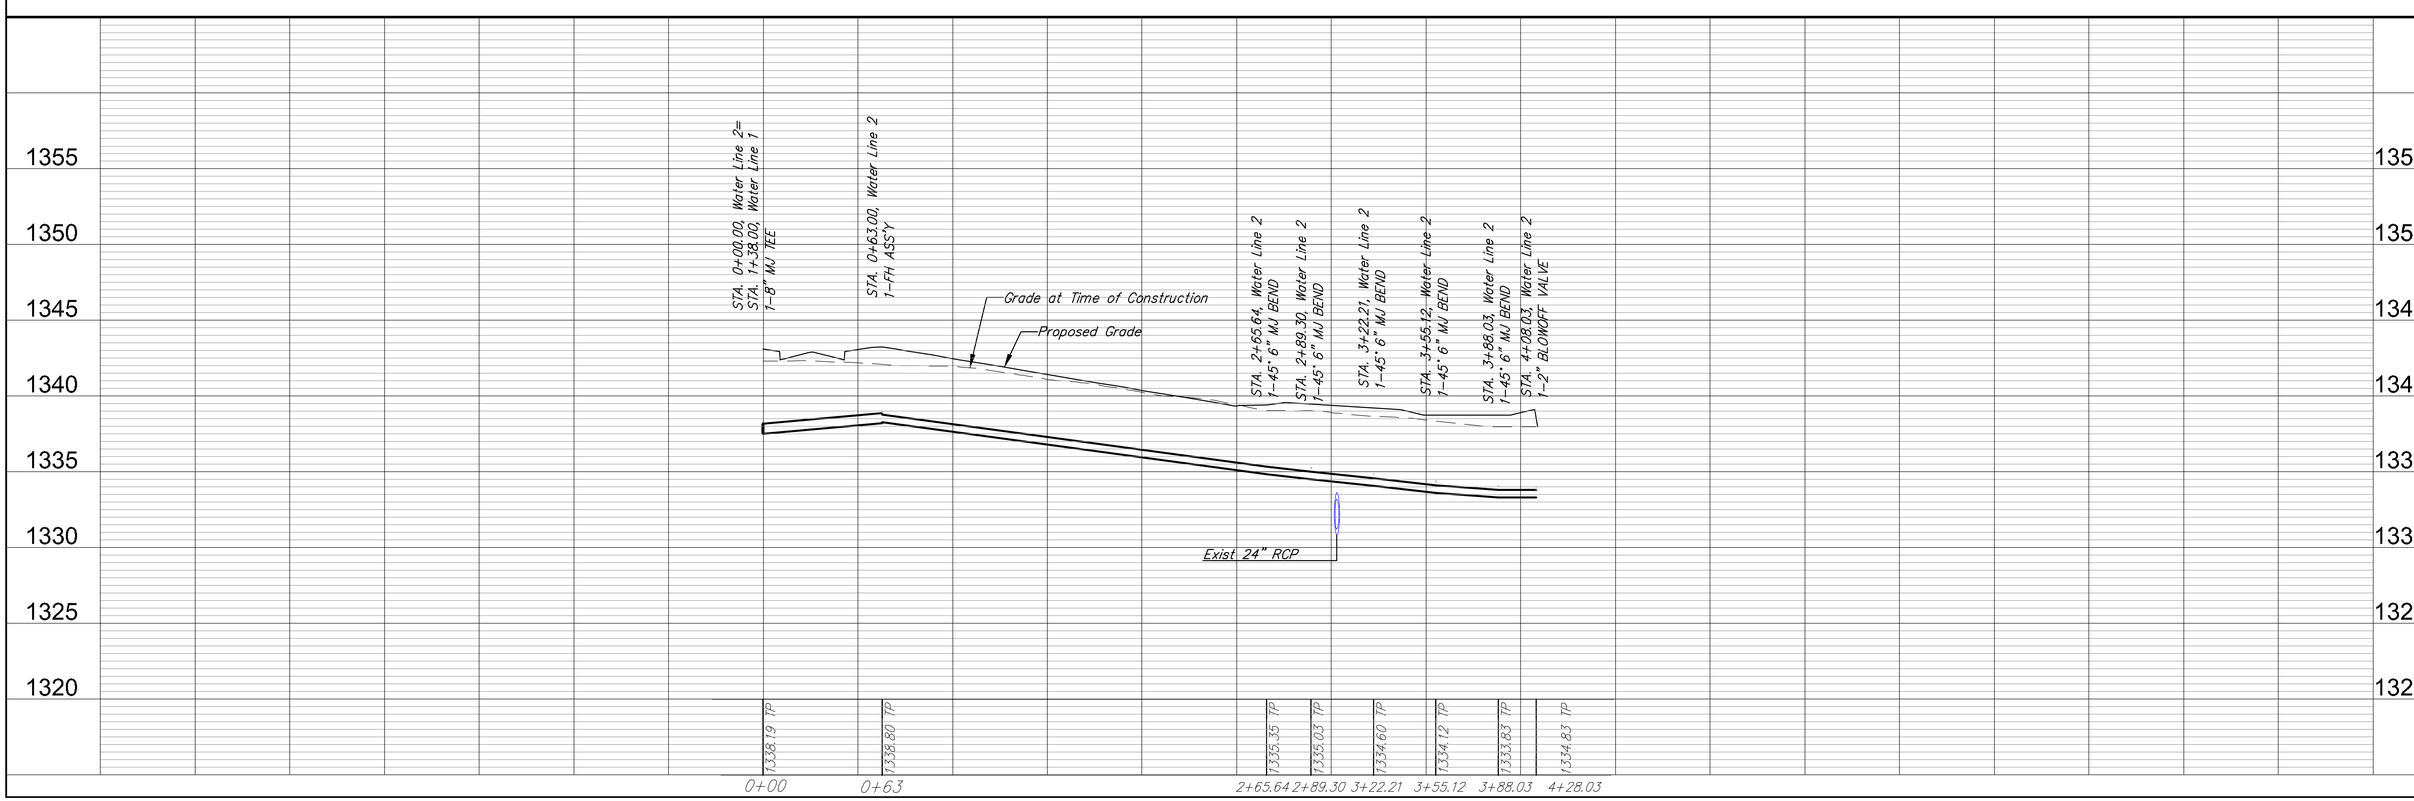

RUGGLES & BOHM

DESIGN CMB | DRAWN RA | REVISED
UTILITY | DATE Oct. 25, 2007 | REVIEW

PROJECT NUMBER 448-90297
DRAWING FILE Water Line 2

TARA CREEK ADDITION
WATER LINE 2
WICHITA, KANSAS

RB JOB 3032E
SHEET 4
X