


Scale: 1" = 100'


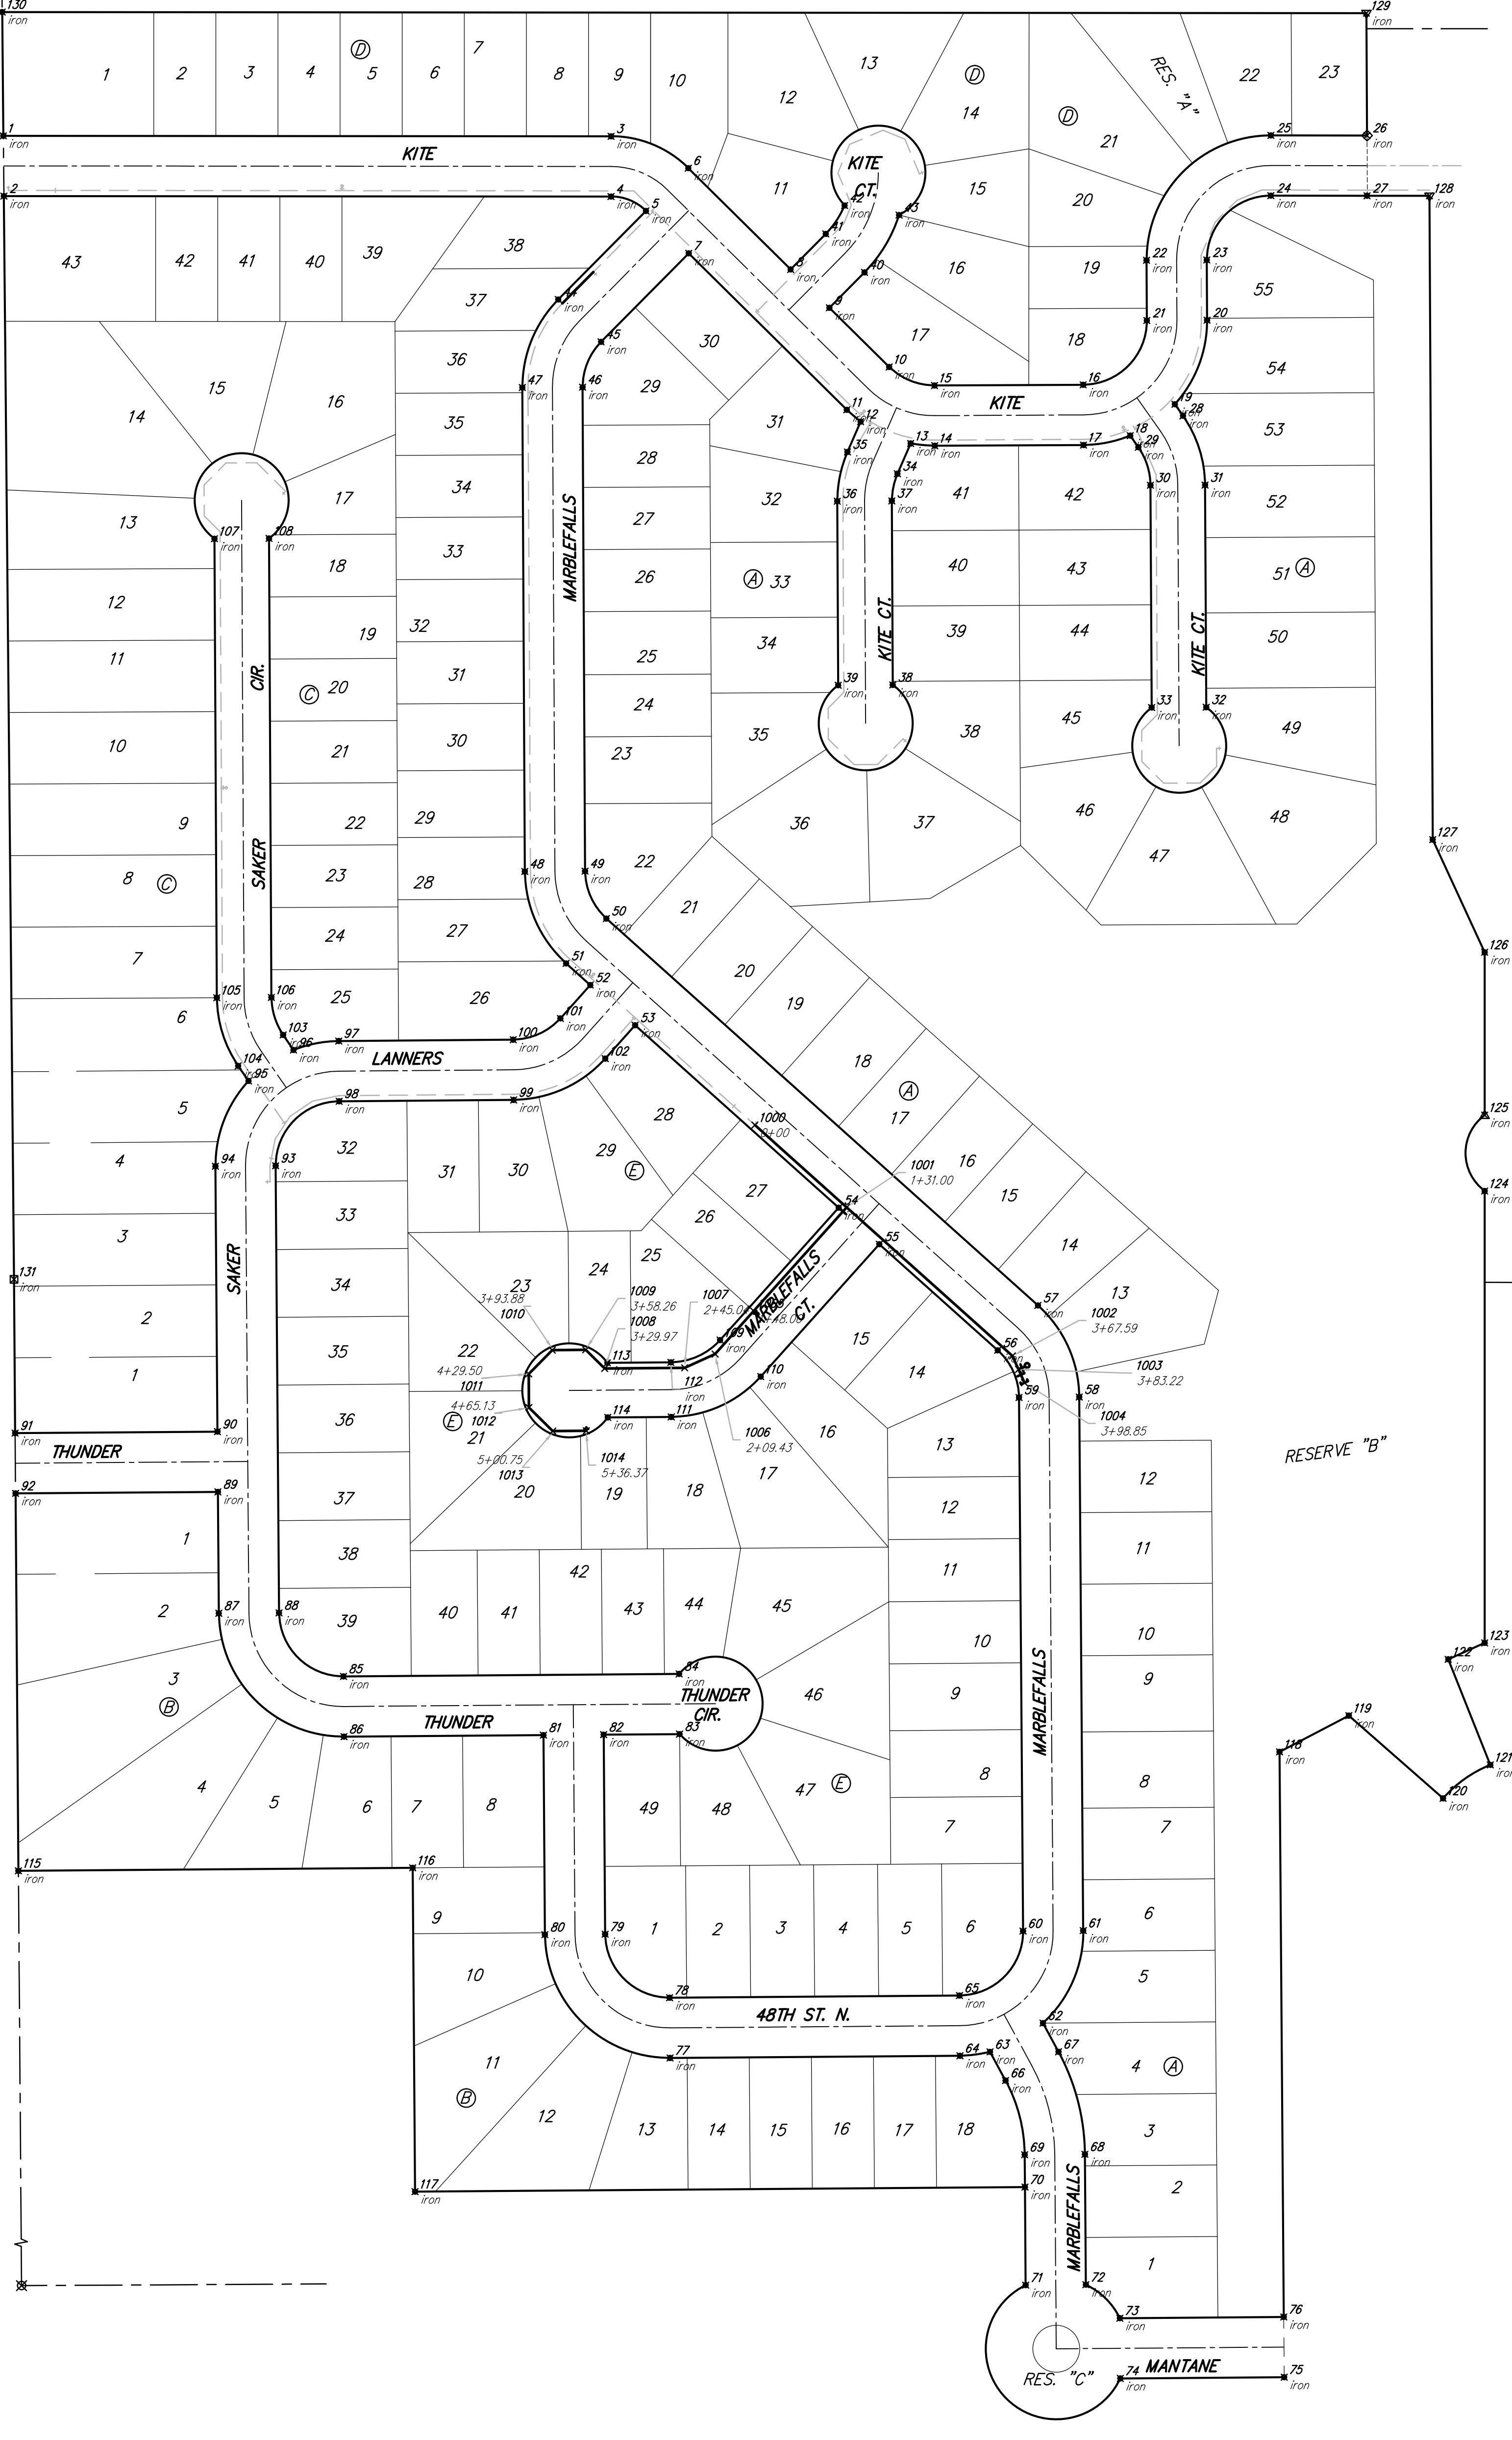

Baughman
 Baughman Company, P.A. SYSTEMS, SURVEYING & LANDSCAPE ARCHITECTURE
 PROJECT NUMBER: 48-00108
 REVISIONS:

FALCON FALLS 2ND ADD. - PH. 3A
COORDINATE SHEET
 WATER DISTRIBUTION SYSTEM

DESIGN: AEG
 TMS
 APPROVED: DATE: 12/13
 SCALE: Noted
 SHEET: 11 OF 12

00082366
