

IRONS
Point Table


Point #	Northing	Easting	Desc
1	25023.60	14983.63	SECCOR
2	27656.32	15008.87	SECCOR
3	27656.32	16331.22	1/16
5	27601.63	15072.90	COWBM
6	25010.09	15021.23	COW BM
7	26056.98	15501.10	BM #1
8	25442.43	16320.80	BM #2
100	26139.86	15112.34	Iron
101	26126.27	15487.22	IRON
102	26140.47	15049.34	4B
103	26056.47	15048.53	BPIN
104	26396.57	15496.28	BPIN
105	25157.66	15303.63	IRON
106	25290.93	15171.20	IRON
107	25413.93	15172.38	IRON
108	27596.36	16330.44	BPIN
109	25027.97	16299.54	4B
110	27101.29	15860.38	BPIN
111	26770.14	15848.75	BGRN CAP
112	26716.32	15803.88	4B
113	26055.87	15111.53	Iron
114	26065.19	15182.62	Iron
115	26129.18	15183.24	Iron
116	26128.63	15241.23	Iron
117	26064.63	15240.62	Iron
118	26279.54	15184.68	Iron
119	26270.29	15242.59	Iron
120	25870.24	15180.75	Iron
121	25878.37	15238.83	Iron
122	26256.04	15488.47	Iron
123	26276.32	15552.81	Iron
124	26212.32	15552.05	Iron
125	26212.32	15804.78	Iron
126	26212.32	15862.78	Iron
127	26033.03	15802.62	Iron
128	26032.33	15860.61	Iron
129	26276.32	16068.22	Iron
130	26212.32	16068.22	Iron
131	26163.74	16116.21	Iron
132	26162.97	16180.21	Iron
133	25941.27	16113.53	Iron
134	25940.50	16177.53	Iron
135	26396.32	15560.60	Iron
136	26674.04	15264.92	Iron
137	26616.04	15264.92	Iron
138	26616.04	15284.18	Iron
139	26674.04	15284.18	Iron
140	26646.43	15356.68	Iron
141	26603.12	15318.11	Iron
142	26606.83	15434.99	Iron
143	26550.09	15422.97	Iron
144	26587.15	15527.93	Iron
145	26530.41	15515.91	Iron
146	26578.59	15591.66	Iron
147	26521.31	15579.34	Iron
148	26574.05	15657.19	Iron
149	26516.19	15653.18	Iron
150	26577.44	15722.49	Iron
151	26520.31	15732.46	Iron
152	26585.32	15813.44	Iron

IRONS
Point Table

Point #	Northing	Easting	Desc
153	26527.32	15813.44	Iron
154	26585.32	16102.22	Iron
155	26527.32	16102.22	Iron
156	26651.27	15544.26	Iron
157	26634.15	15605.92	Iron
158	26775.58	15609.60	Iron
159	26786.94	15619.11	Iron
160	26734.49	15658.67	Iron
161	26831.41	15656.35	Iron
162	26896.15	15488.69	Iron
163	26940.62	15525.92	Iron
164	26994.04	15378.91	Iron
165	26936.04	15378.91	Iron
166	26936.04	15267.98	Iron
167	26994.04	15267.98	Iron
168	26971.08	15856.77	Iron
169	25758.44	15483.70	Iron
170	25757.82	15547.69	Iron
171	25543.86	15289.79	Iron
172	25480.25	15296.86	Iron
173	25413.32	15236.38	Iron
174	25290.32	15235.20	Iron
175	25221.66	15303.42	Iron
176	25160.13	16046.14	Iron
177	25224.13	16045.93	Iron
178	25167.23	16088.41	Iron
179	25155.44	16096.04	Iron
180	25128.78	16103.74	Iron
181	25128.01	16167.73	Iron
182	25190.21	16149.77	Iron
183	25202.00	16142.14	Iron
184	25291.19	16113.70	Iron
185	25290.54	16177.69	Iron
186	25394.68	16178.95	Iron
187	25458.68	16179.72	Iron
188	25457.33	16304.71	Iron
189	25393.33	16303.94	Iron
190	25532.02	16180.60	Iron
191	25484.79	16116.03	Iron

SWS POINTS
Point Table

Point #	Northing	Easting	Desc
7000	25381.96	15911.71	0+00
7001	25386.28	15926.07	15' O/S
7002	25377.63	15897.35	15' O/S
7003	25347.58	15922.07	MH
7004	25210.86	15919.86	cen i/s fc
7005	25172.52	15913.70	cen i/s fc
7006	25191.71	15919.92	street cl
7007	25191.69	15913.63	street cl
7008	25051.68	15911.43	MH
7009	25051.10	15734.98	INLET
7010	25165.93	16104.53	cen i/s fc
7011	25176.35	16120.63	street cl
7012	25077.65	16115.95	cen i/s fc
7013	25077.19	16154.29	cen i/s fc
7014	25077.42	16135.12	street cl
7100	25059.35	15140.83	esmt
7101	25059.29	15189.68	esmt
7102	25059.69	15309.95	esmt
7103	25061.41	15393.94	esmt
7104	25060.30	15478.00	esmt
7105	25060.52	15561.95	esmt
7106	25060.79	15646.03	esmt
7107	25061.36	15813.95	esmt
7108	25061.67	15906.40	esmt
7109	25061.97	15998.40	esmt
7110	25342.92	15380.87	esmt
7111	25403.06	15459.84	esmt
7112	25470.36	15548.19	esmt
7113	25504.44	15592.95	esmt
7114	25566.49	15619.78	esmt
7115	25676.43	15667.32	esmt
7116	25782.63	15668.60	esmt
7117	25866.62	15669.61	esmt
7118	25903.48	15670.05	esmt

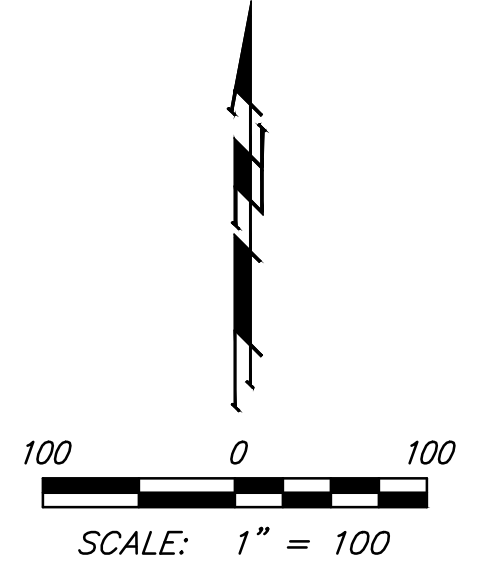

BENCHMARKS:
 " □ " Cut in top of curb south end of east curb return 10th St. & Forestview adjacent to Lot 9, Block A, Liberty Park 3rd Addition Elev. = 168.43 (City Datum)
 " □ " Cut in top of curb 10' east of end of existing pavement adjacent to Lot 52, Block C, Liberty Park 3rd Addition Elev. = 164.21 (City Datum)
 C.O.W. Benchmark Disk. 56' E and 55' N of E 135th St. W. & 13th St. N. Elev. = 167.83 (City Datum)
 C.O.W. Benchmark Disk. 1/2 mile south of 13th St. 39' east of E 135th St. 18' south of hedge row. Elev. = 159.71 (City Datum)

Baughman Liberty Park 3rd Addition - Phase 2B
COORDINATE SHEET
 Street & SWS Improvements

Baughman Company, P.A. 315 Ellis St. Wichita, KS 67211 P 316-262-7271 F 316-262-0149
 ENGINEERING | SURVEYING | PLANNING | LANDSCAPE ARCHITECTURE

PROJECT NUMBER 472-84069	DESIGN JAK	DRAWN JAK
REVISIONS:	APPROVED	DATE 3/11/14
	SCALE Noted	SHEET 21 OF 24

E:\Projects\Liberty Park 3rd\0403\F304\Engineering\Phase 2B\STR_V21_Coord.dwg