



PLOTTED: Saturday, August 03, 2013 @ 12:00PM

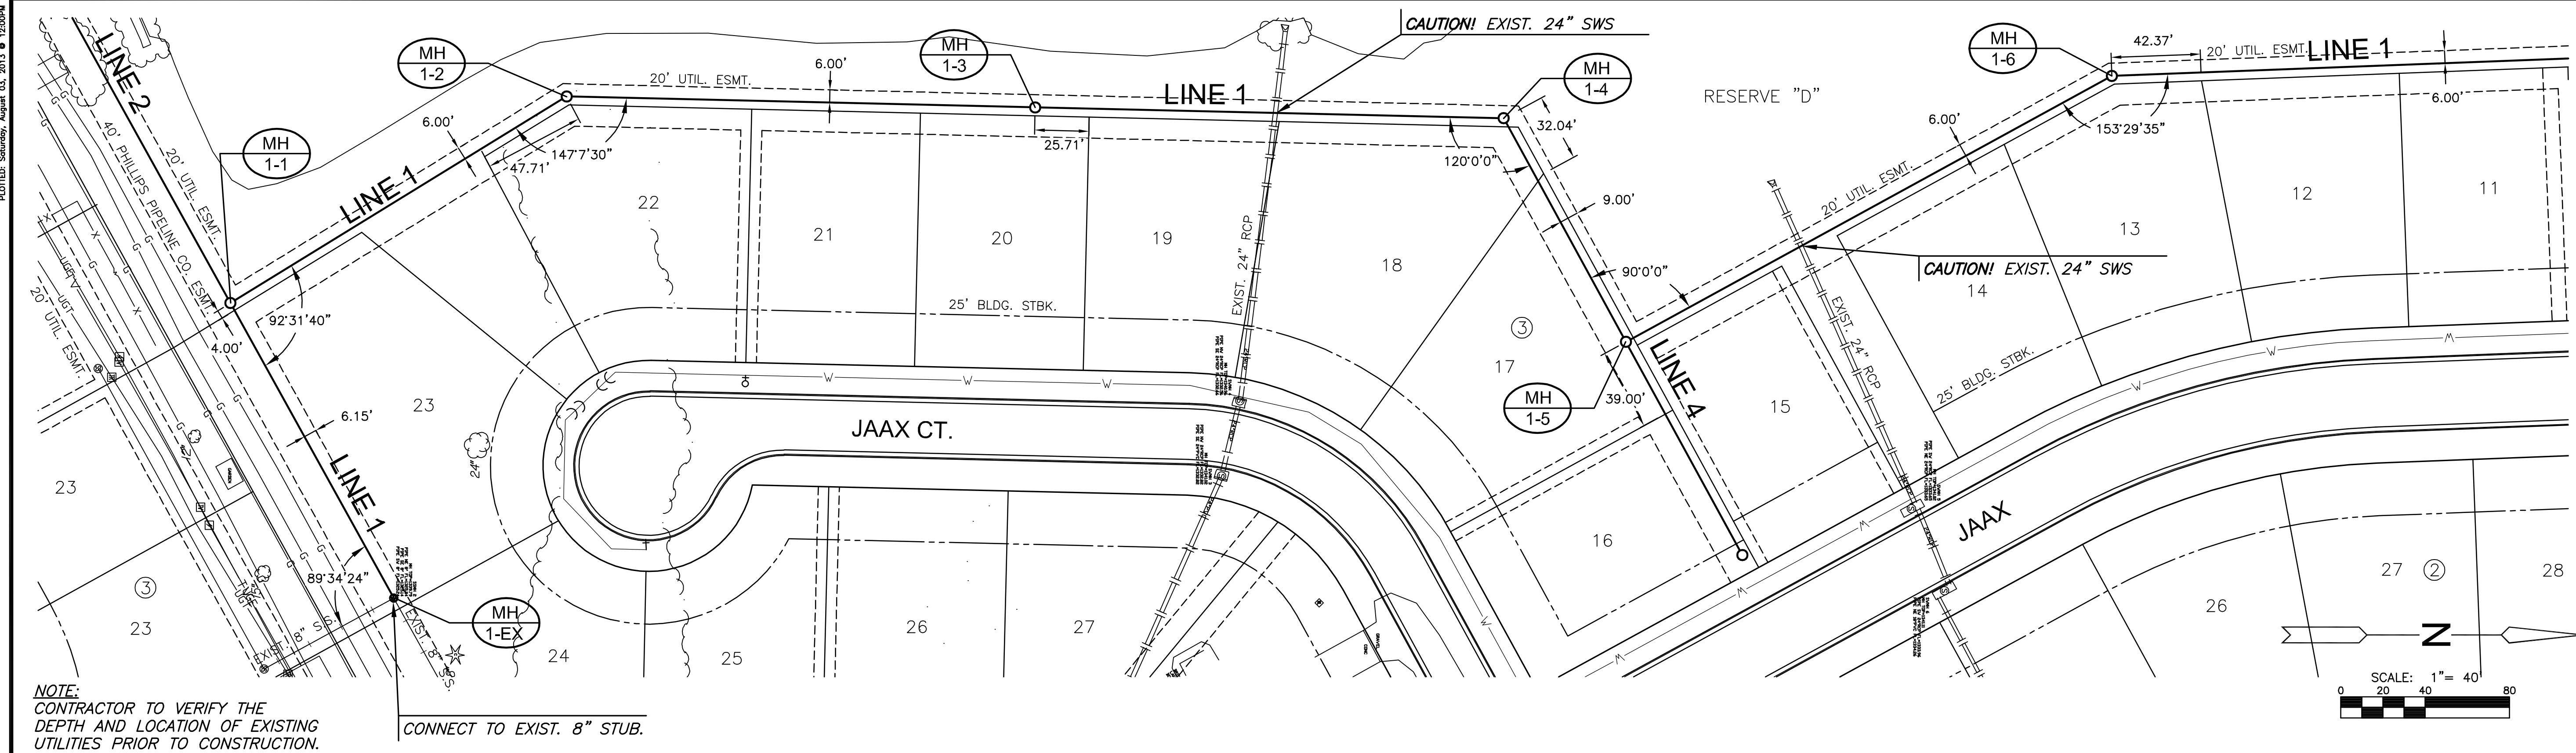

PLAN SS LINE 1  
PROFILE SS LINE 1

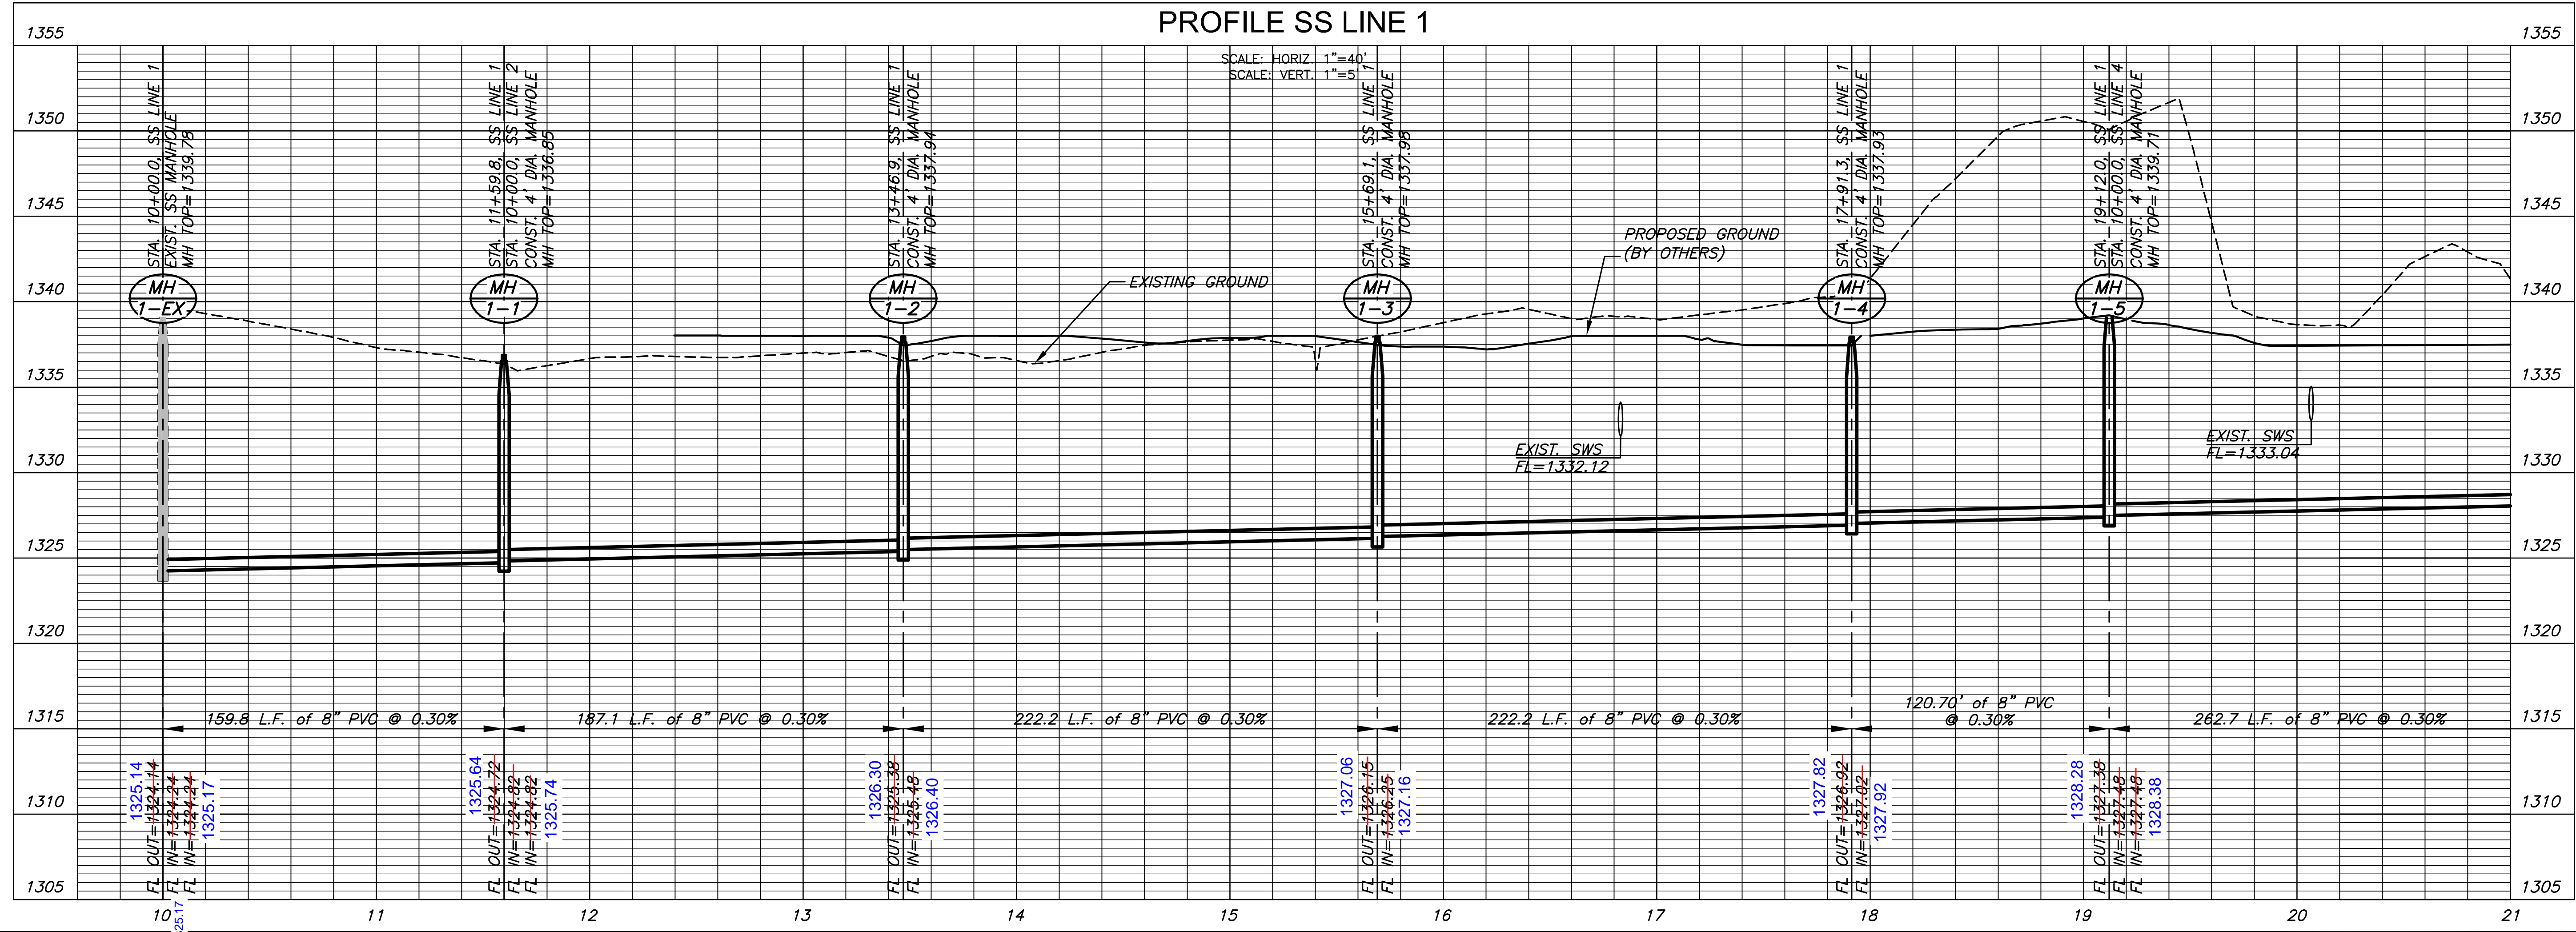

SANITARY SEWER PLANS FOR  
**BAY COUNTRY ADDITION**  
PHASE 1

©2013 MKEC Engineering All Rights Reserved  
www.mkec.com  
These drawings and their contents, including, but not limited to, all concepts, designs, & ideas are the exclusive property of MKEC Engineering (MKEC), and may not be used or reproduced in any way without the express consent of MKEC.

LINE 1 PLAN & PROFILE

PROJECT NO.	468-84890	
DATE	AUGUST 2013	
SCALE	1"=40'	
DESIGNED	DRAWN	CHECKED
SPE	SPE	GJA
#	REVISION	DATE
NO.		