



PLOTTED: Saturday, August 03, 2013 @ 1:00PM

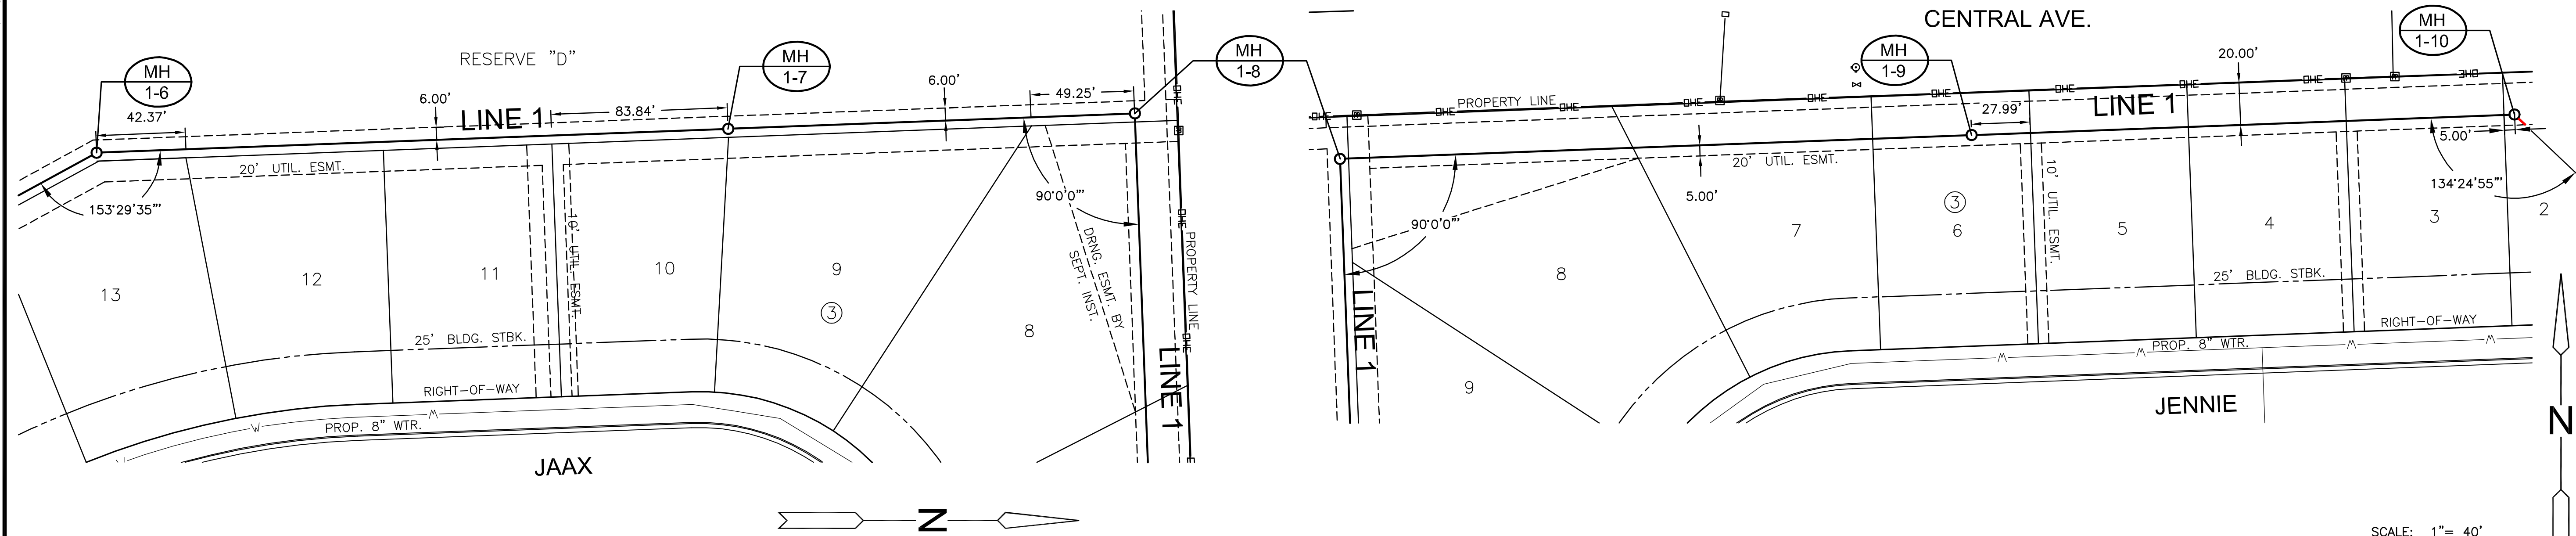

NOTE:
CONTRACTOR TO VERIFY THE
DEPTH AND LOCATION OF EXISTING
UTILITIES PRIOR TO CONSTRUCTION.

PLAN SS LINE 1 CONT.
PROFILE SS LINE 1 CONT.

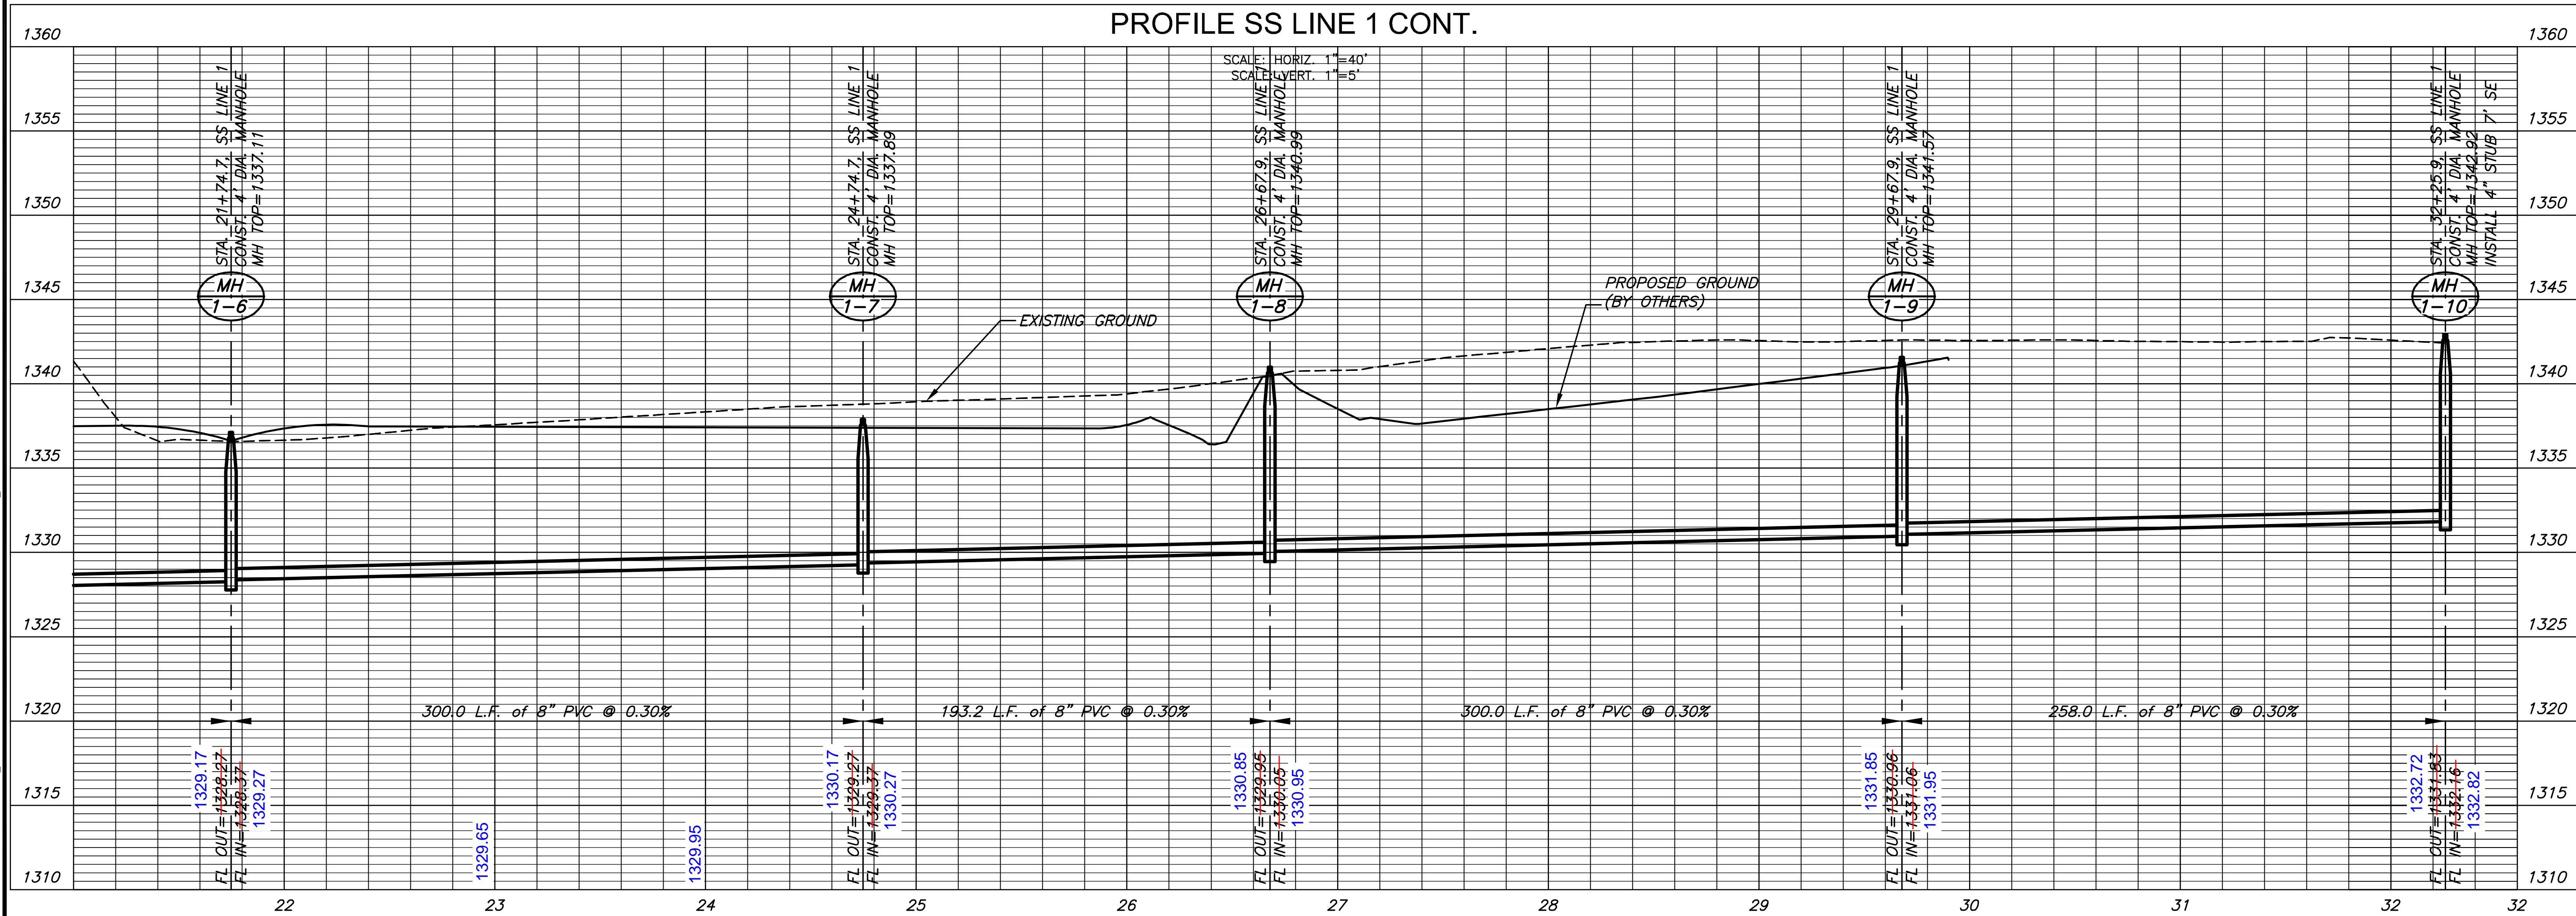

SANITARY SEWER PLANS FOR

BAY COUNTRY ADDITION

PHASE 1

©2013
MKEC Engineering
All Rights Reserved
www.mkec.com
These drawings and their contents,
including, but not limited to, all concepts,
designs, & ideas are the exclusive
property of MKEC Engineering (MKEC),
and may not be used or reproduced in any
way without the express consent of MKEC.

LINE 1 PLAN &
PROFILE

PROJECT NO.	468-84890	
DATE	AUGUST 2013	
SCALE	1"=40'	
DESIGNED	DRAWN	CHECKED
SPE	SPE	GJA

NO.	REVISION	DATE

SHEET NO.