





BENCHMARKS:
 "□" Cut in top of curb south end of east curb return 10th St. & Forestview adjacent to Lot 9, Block A, Liberty Park 3rd Addition Elev. = 168.43 (City Datum)

"□" Cut in top of curb 10' east of end of existing pavement adjacent to Lot 52, Block C, Liberty Park 3rd Addition Elev. = 164.21 (City Datum)

C.O.W. Benchmark Disk. 56' E and 55' N of Q 135th St. W. & 13th St. N. Elev. = 167.83 (City Datum)

C.O.W. Benchmark Disk. 1/2 mile south of 13th St. 39' east of Q 135th St. 18' south of hedge row. Elev. = 159.71 (City Datum)

LIBERTY PARK 3RD ADDITION

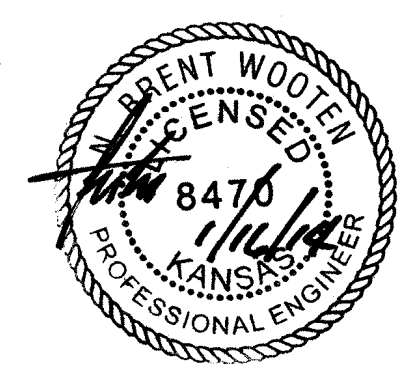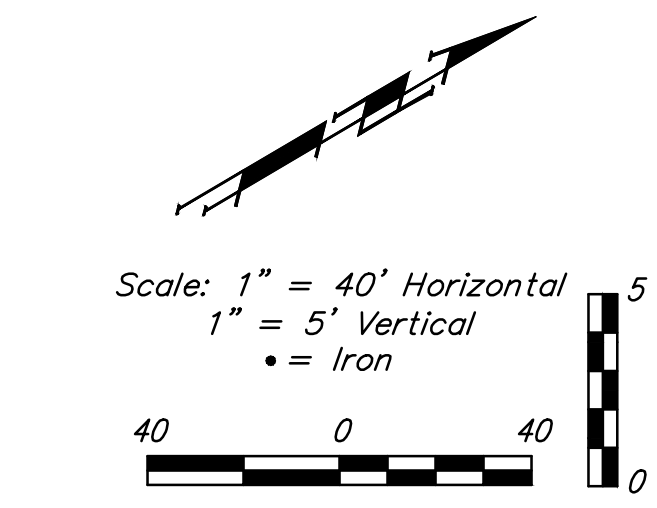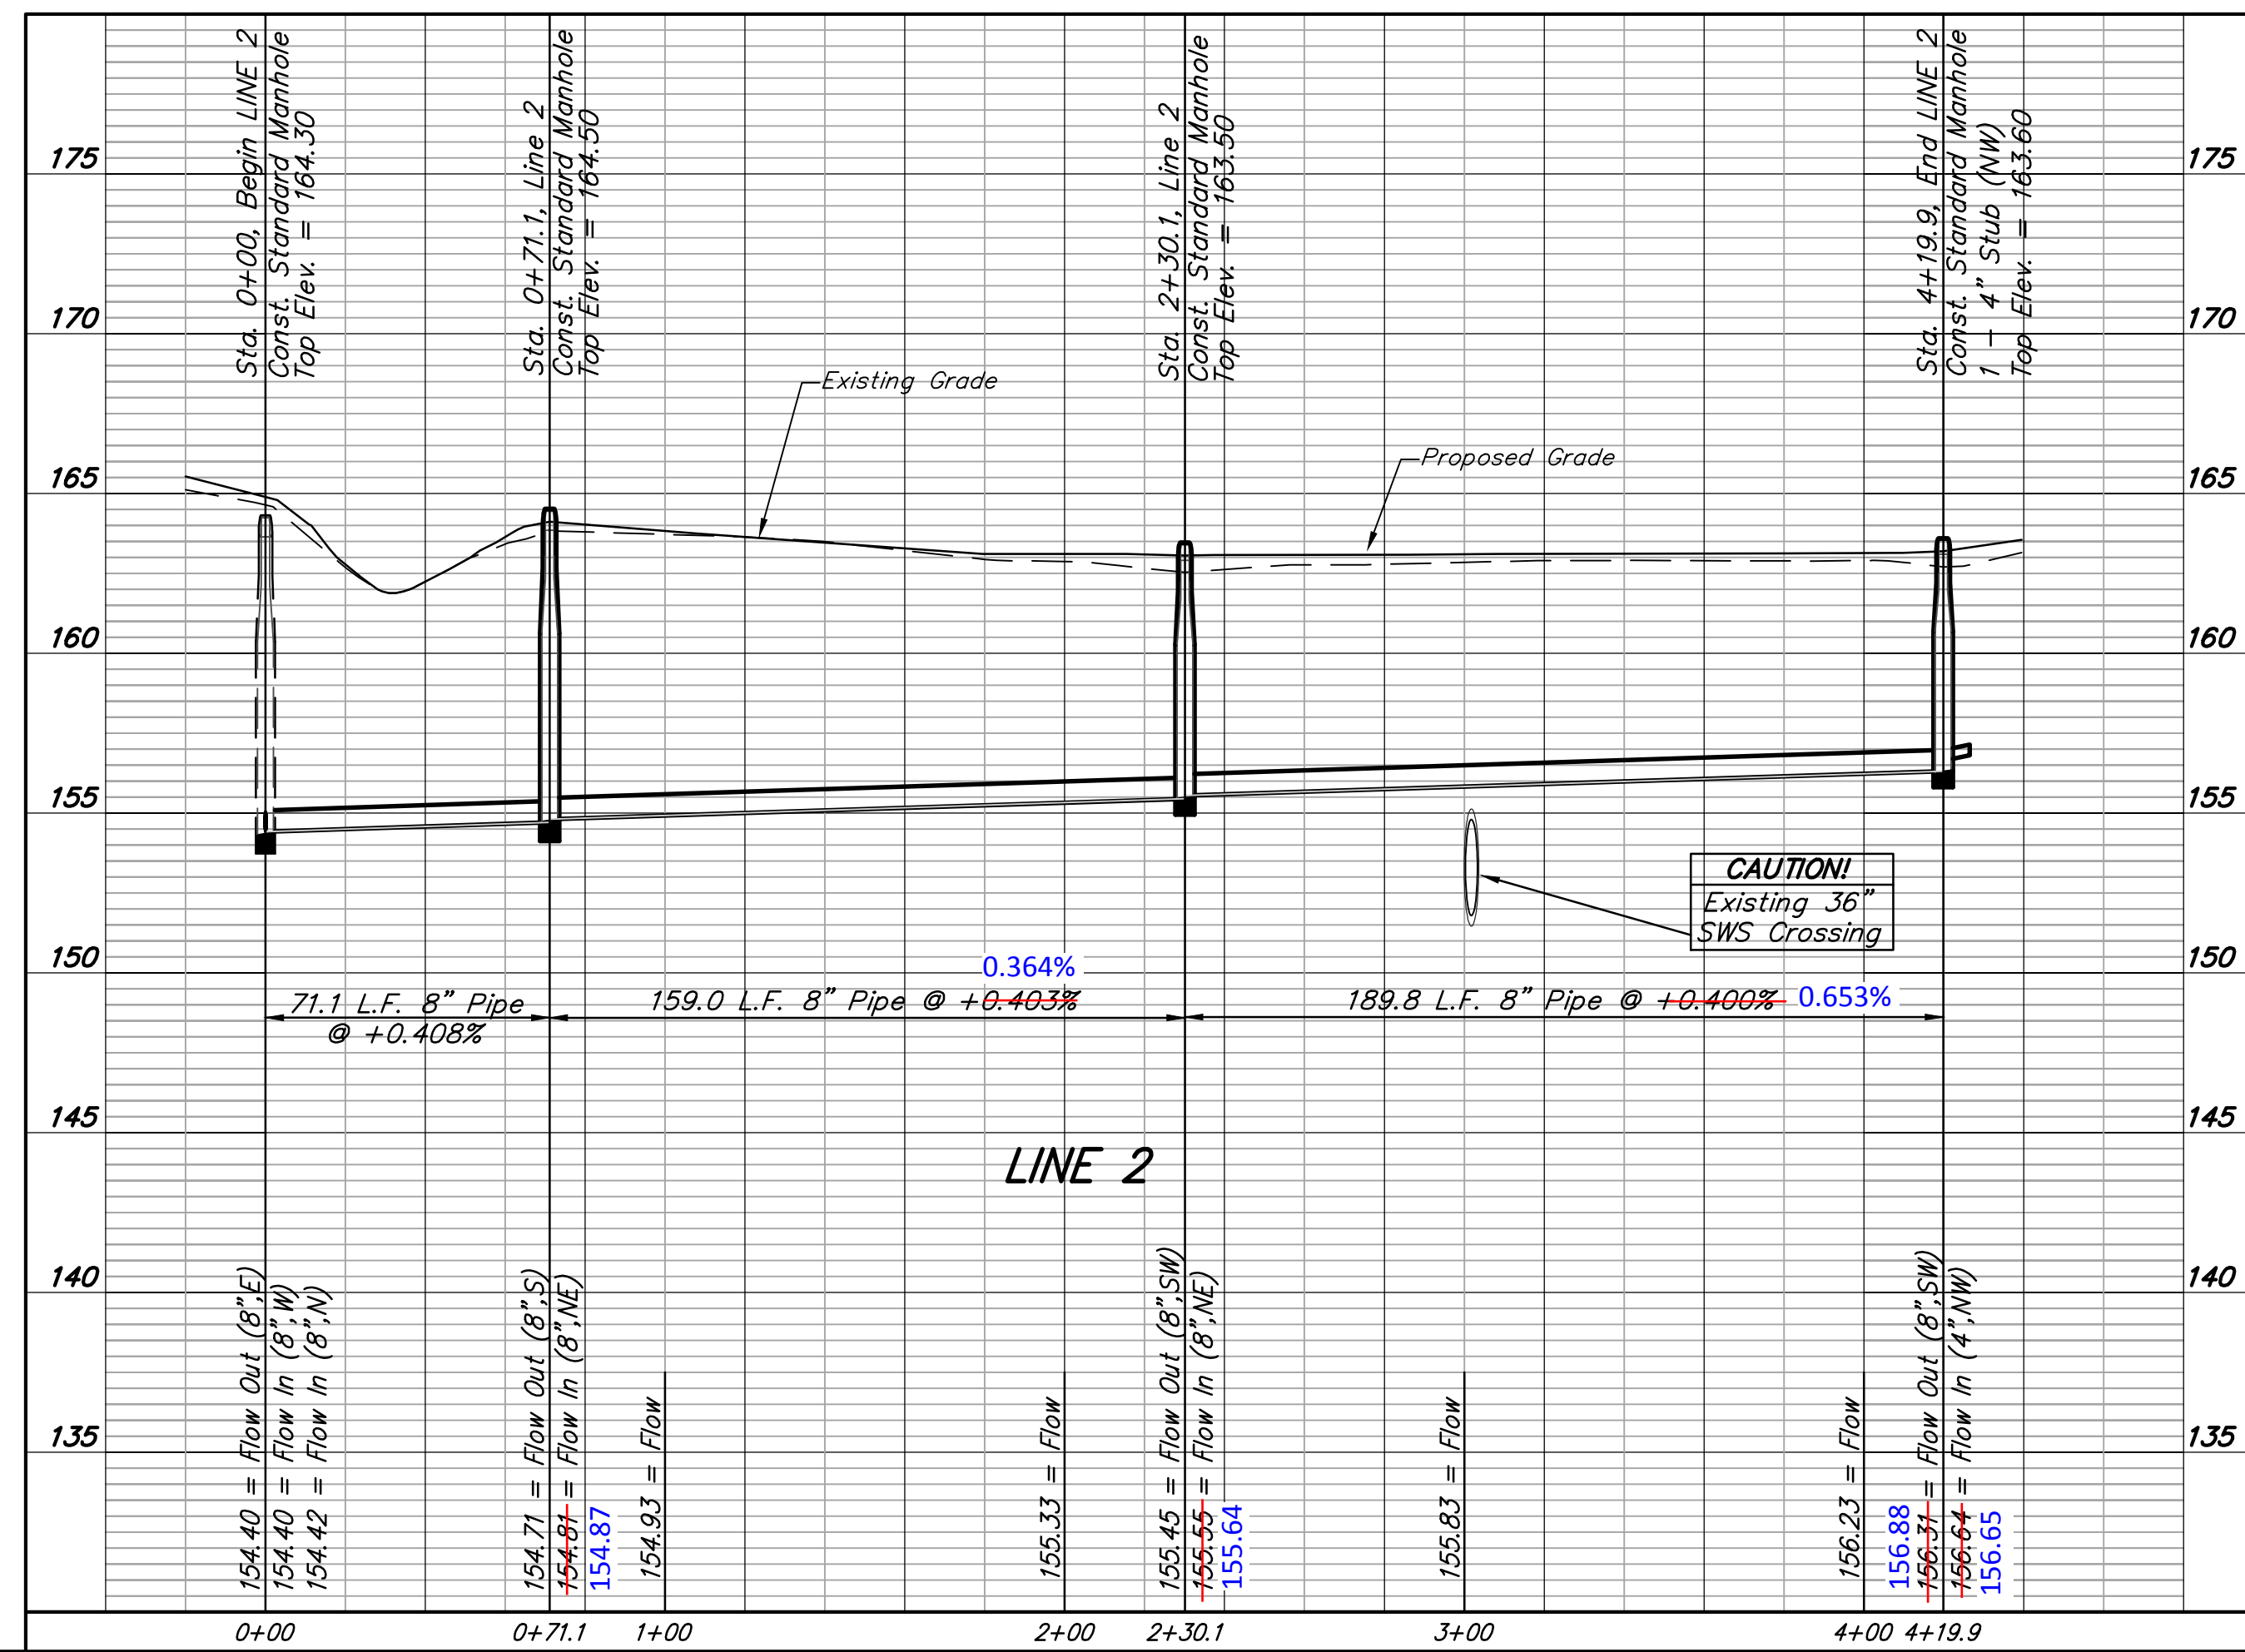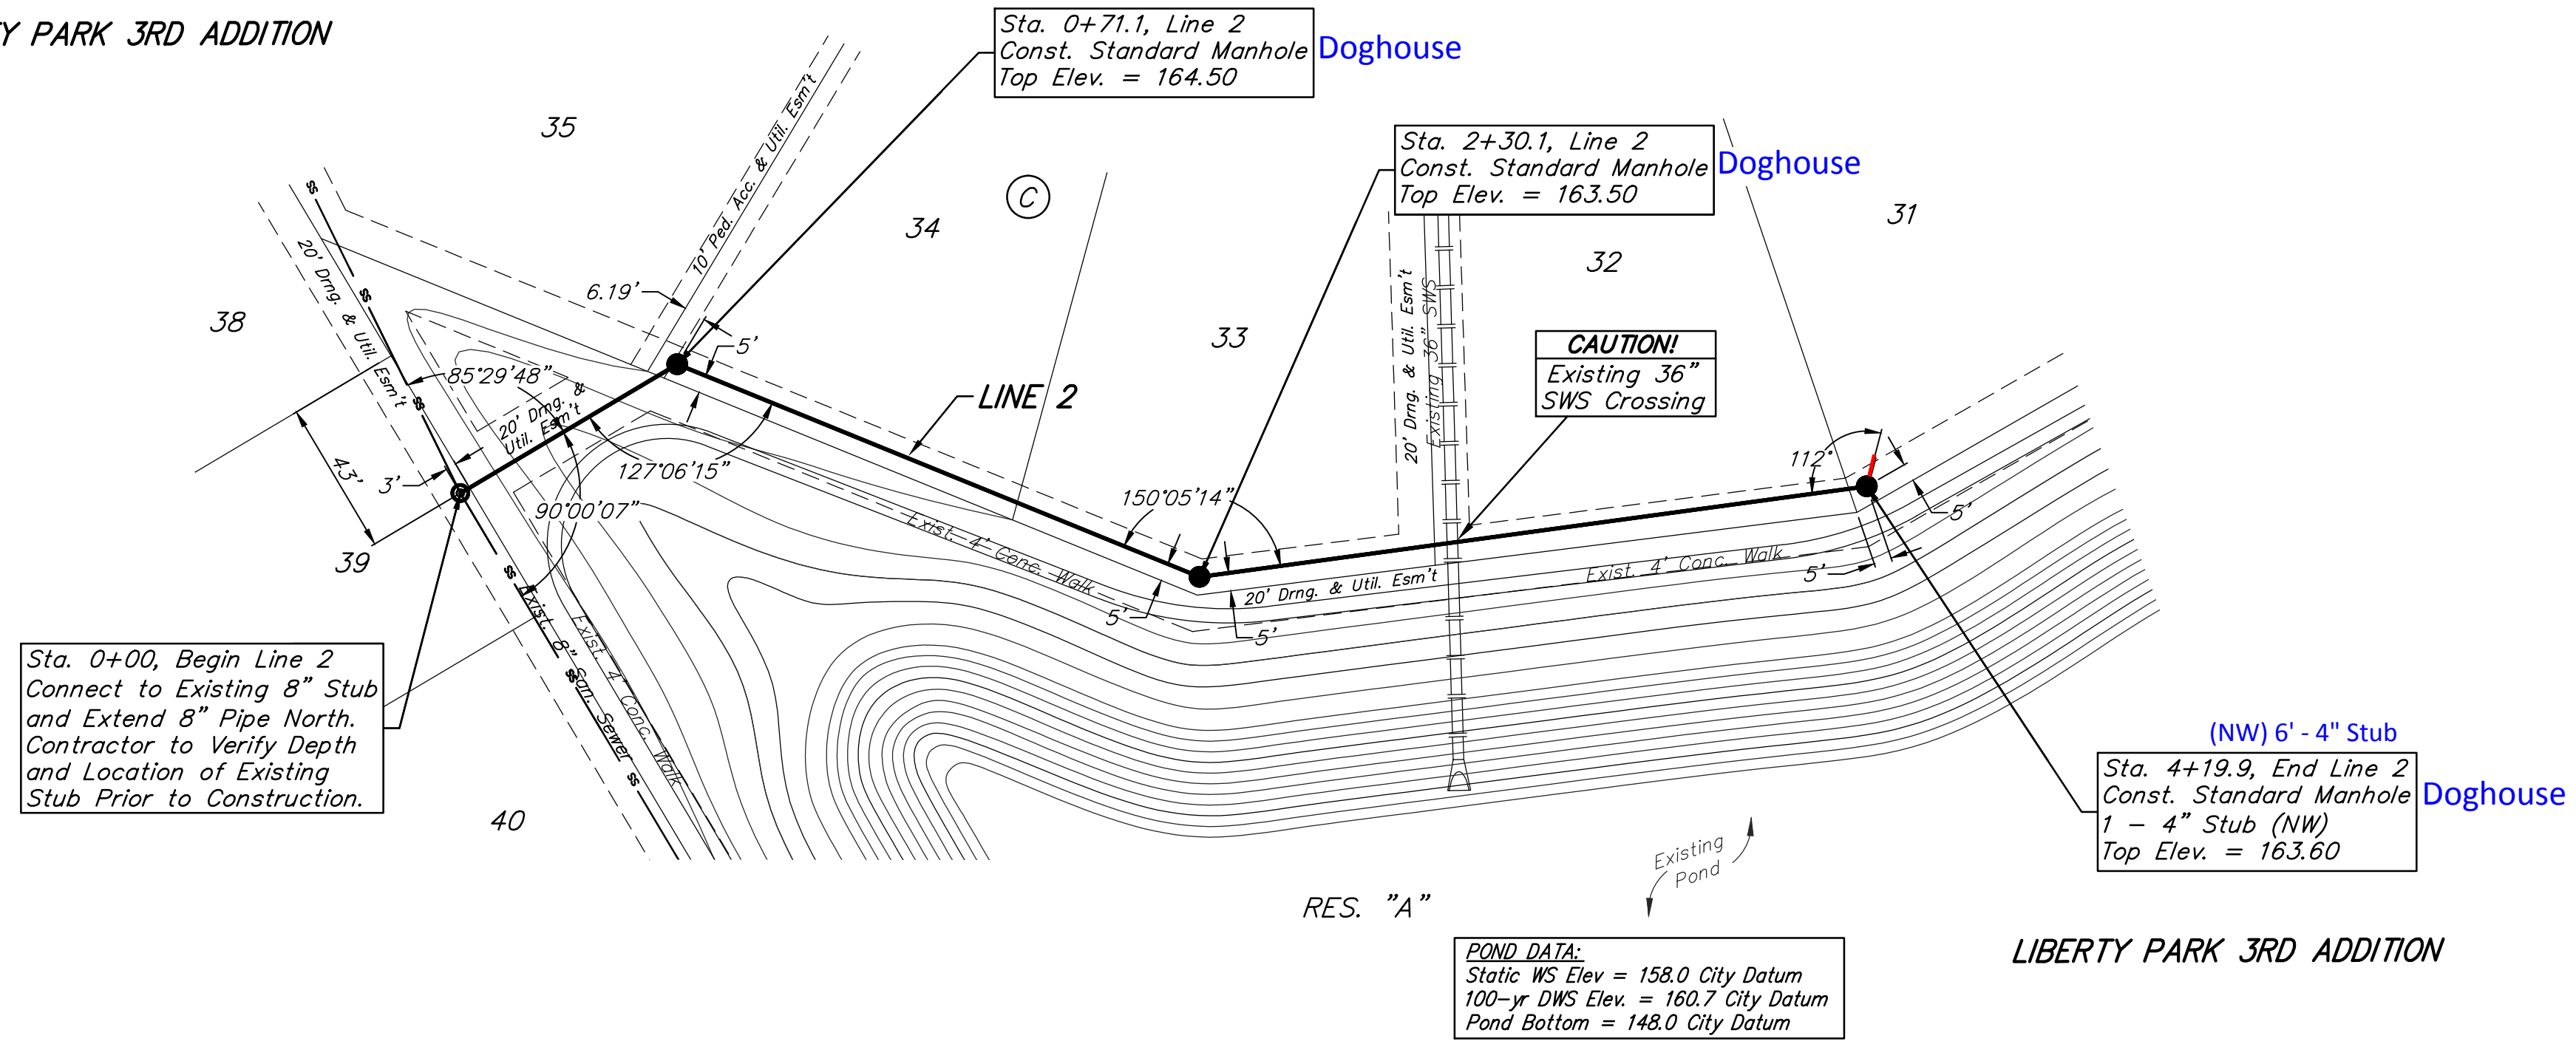

Baughman		Liberty Park 3rd Addition - Phase IIB	
PROJECT NUMBER 468-83853		DESIGN DRAWN	
REVISIONS:		APPROVED DATE	
		SCALE Noted	
		SHEET 3 OF 13	