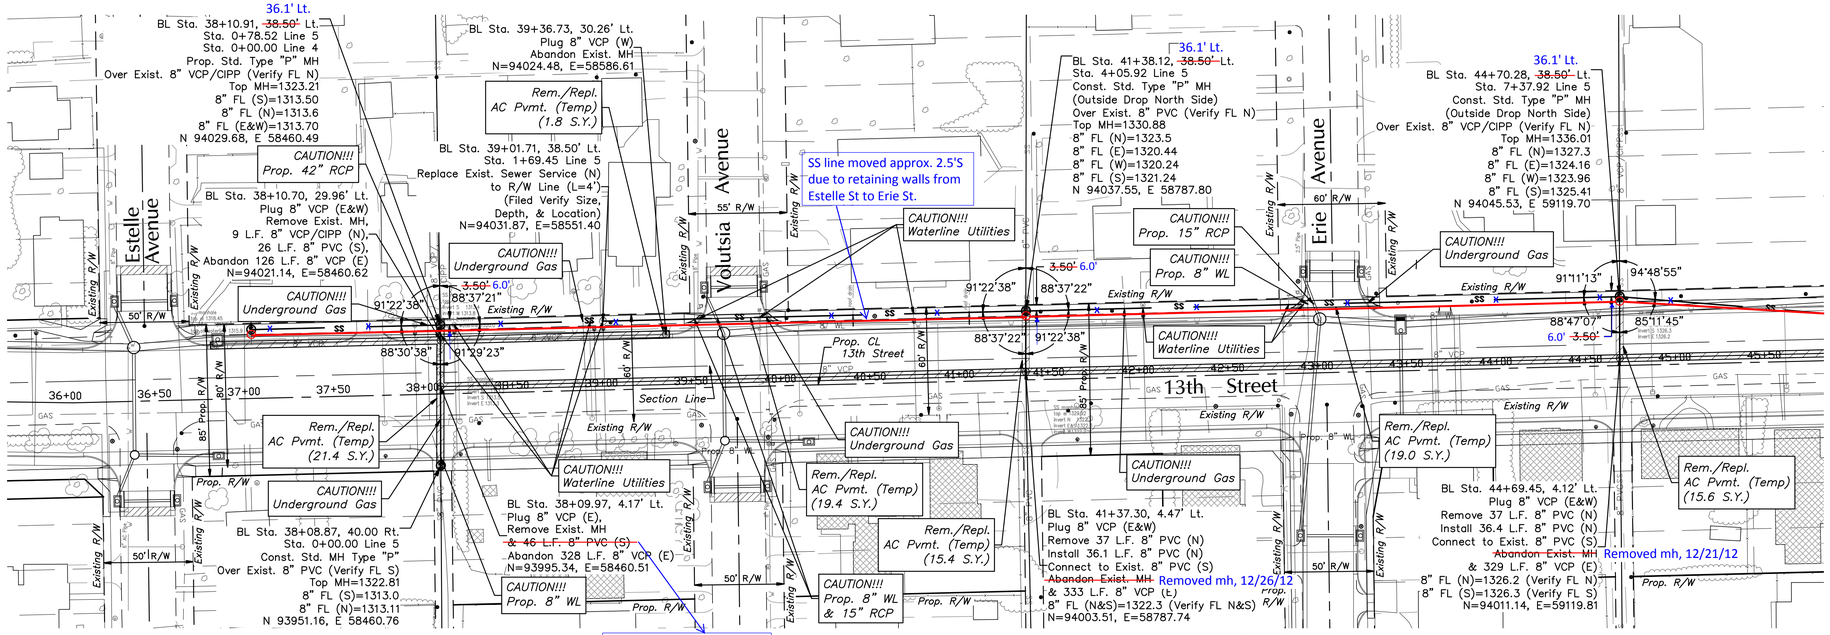

NOTES:
1. Contractor to Field Verify location and Depth of All Utilities Prior to Construction and Report Findings to Project Engineer.

Remove Trees Only as Needed for Construction. Cost Shall be Subsidiary to Site Clearing.

LEGEND

Sanitary Sewer to be Abandoned in Place or Removed as Noted in Plan

Existing Building to be Removed by Others

GRAPHIC SCALE

HORIZ. (IN FEET) 1 INCH = 40 FT. — 40 0 20 40 80

VERT. (IN FEET) 1 INCH = 5 FT. — 5 0

LINE #5

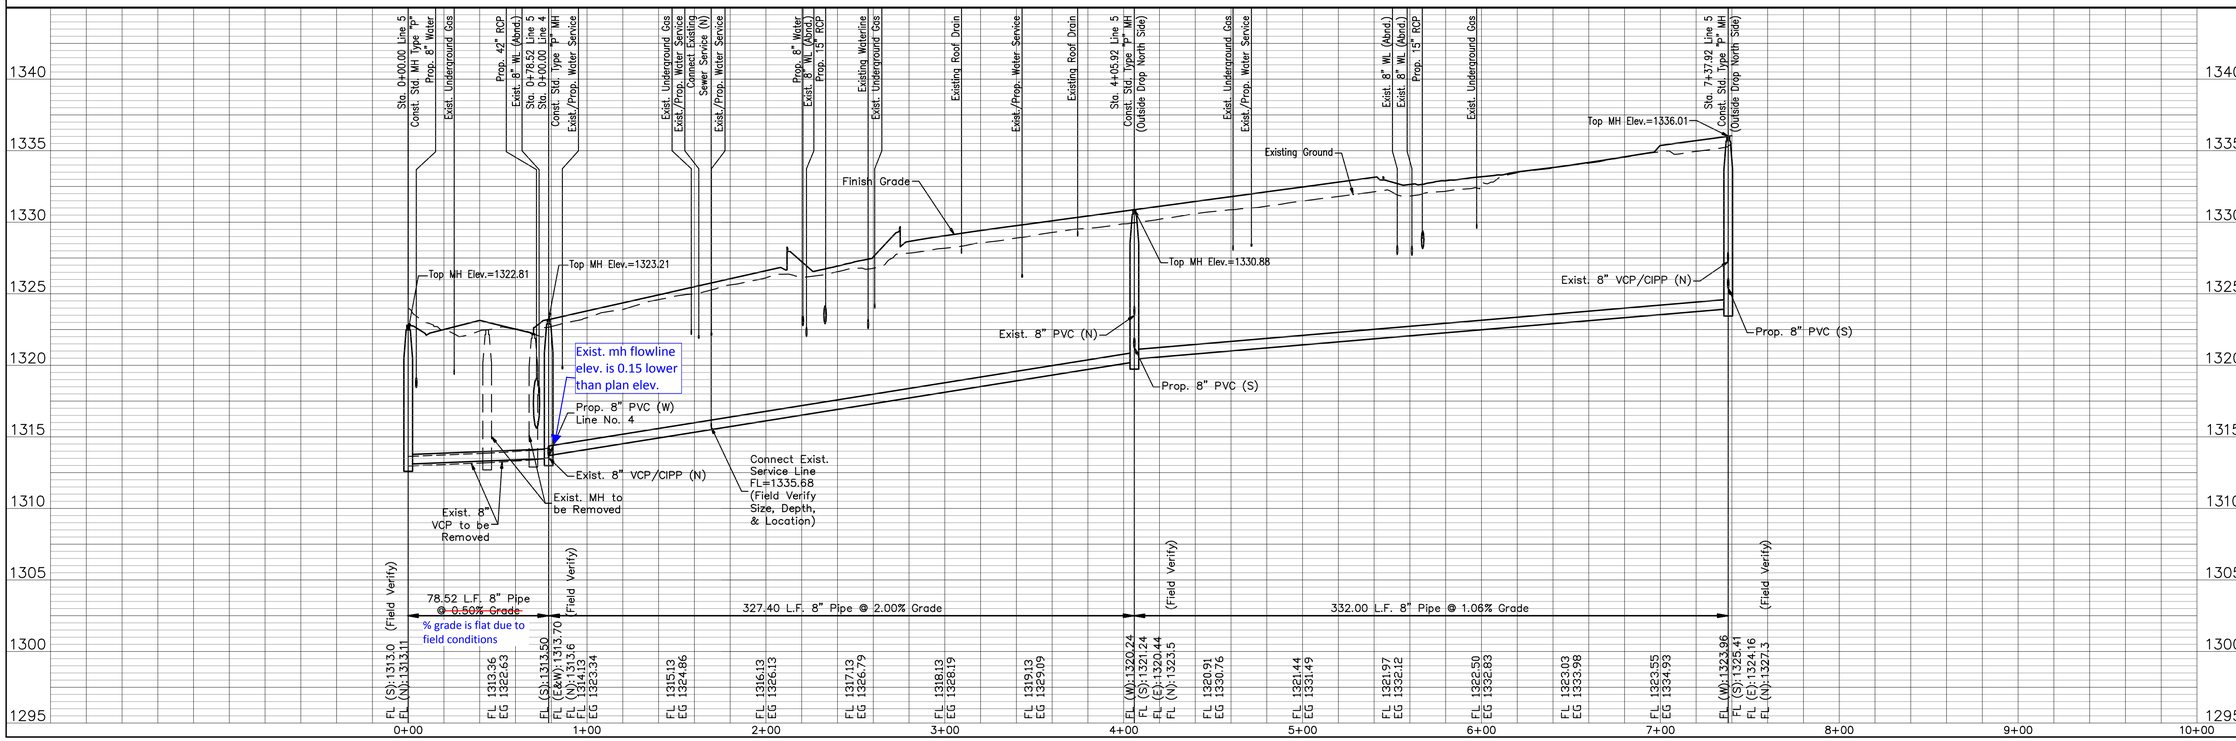

No.	Date	By	Approved	Revision

13TH STREET NORTH FROM HYDRAULIC TO OLIVER
SANITARY SEWER EXTENSIONS
LINE NO. 5

CITY OF WICHITA, KANSAS

JAMES L. ARMOUR, P.E. – CITY ENGINEER
C.O.W. Proj. No. 468-84816 OCA No. 762410

POE & ASSOCIATES, INC.
CONSULTING ENGINEERS
5940 E. Central, Suite 200 ■ Wichita, KS 67208-4242
Phone 316/685-4114 ■ FAX 316/685-4444

FINAL

Designed By: J. DICKMAN
Drawn By: M. TUCKER
Poe Job No.: 1871A
Date: March, 2012