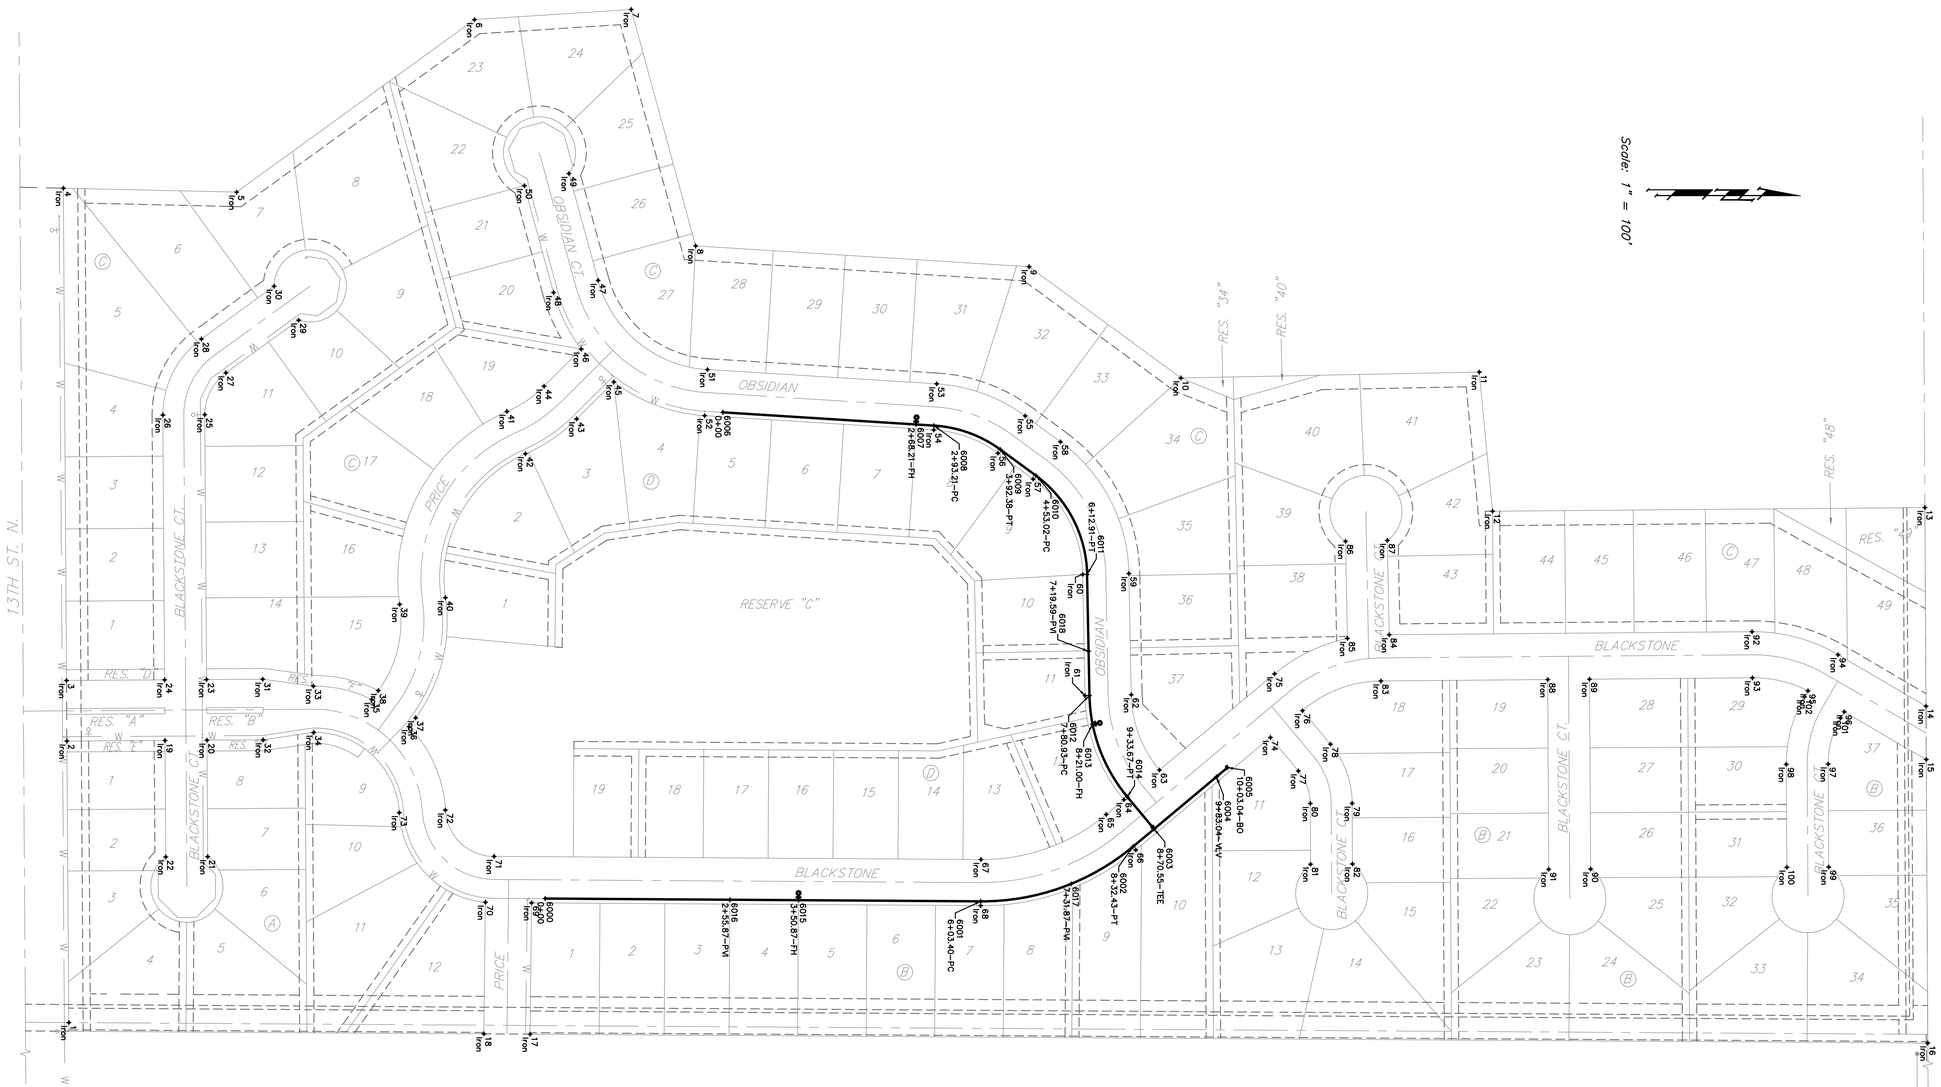

Point #	Northing	Easting	Desc
1	2267.73.92	7357.36	Iron
2	2267.71.39	6967.36	Iron
3	2267.0.85	6883.37	Iron
4	2266.6.42	6201.15	Iron
5	2263.6.62	6206.65	Iron
6	2232.6.23	5967.59	Iron
7	2345.3.40	5953.47	Iron
8	2354.2.71	6281.04	Iron
9	2400.4.88	6309.92	Iron
10	2421.5.27	6464.09	Iron
11	2462.8.73	6456.01	Iron
12	2464.6.98	6648.75	Iron
13	2524.6.21	6643.65	Iron
14	2524.7.72	6918.87	Iron
15	2524.8.13	6992.90	Iron
16	2525.0.29	7385.72	Iron
17	2313.3.21	7373.42	Iron
18	2324.9.21	7373.01	Iron
19	2287.7.39	6966.48	Iron
20	2286.5.39	6966.11	Iron
21	2286.6.43	7127.48	Iron
22	2288.8.43	7127.85	Iron
23	2286.4.84	6882.11	Iron
24	2286.6.84	6882.48	Iron
25	2286.2.46	6515.00	Iron
26	2280.4.46	6515.38	Iron
27	2289.1.77	6457.07	Iron
28	2285.7.72	6410.11	Iron
29	2299.2.56	6383.97	Iron
30	2295.8.51	6337.02	Iron
31	2294.2.84	6881.60	Iron
32	2294.3.38	6965.60	Iron
33	2301.3.02	6891.15	Iron
34	2301.3.43	6955.15	Iron
35	2309.3.99	6909.57	Iron
36	2314.5.68	6947.30	Iron
37	2315.4.66	6935.01	Iron
38	2310.2.96	6897.28	Iron
39	2313.2.57	6777.80	Iron
40	2319.5.90	6768.57	Iron
41	2328.1.22	6510.46	Iron
42	2330.6.80	6569.13	Iron
43	2337.7.75	6520.88	Iron
44	2333.2.60	6475.53	Iron
45	2342.9.35	6469.52	Iron
46	2338.4.20	6424.16	Iron
47	2340.7.54	6328.91	Iron
48	2334.5.79	6345.75	Iron
49	2336.7.16	6180.79	Iron
50	2330.5.41	6197.62	Iron
51	2355.9.15	6452.40	Iron
52	2355.5.16	6516.27	Iron
53	2387.6.73	6472.24	Iron
54	2387.2.74	6536.12	Iron
55	2399.9.39	6516.65	Iron
56	2396.1.56	6568.28	Iron
57	2401.0.48	6604.12	Iron
58	2404.8.31	6552.50	Iron
59	2414.3.14	6735.10	Iron
60	2407.9.15	6736.35	Iron
61	2408.2.43	6904.35	Iron
62	2414.6.42	6903.10	Iron
63	2418.5.42	7007.38	Iron
64	2413.6.31	7048.42	Iron
65	2411.1.67	7069.02	Iron
66	2415.2.71	7118.13	Iron
67	2393.8.10	7131.38	Iron
68	2393.7.69	7195.38	Iron
69	2331.5.27	7191.43	Iron
70	2325.1.28	7190.50	Iron
71	2326.3.37	7127.10	Iron
72	2319.5.91	7062.92	Iron
73	2313.2.01	7066.51	Iron
74	2433.9.17	6962.28	Iron
75	2434.4.93	6874.06	Iron
76	2438.3.67	6925.09	Iron
77	2437.7.93	7008.86	Iron
78	2442.2.43	6971.46	Iron
79	2445.2.45	7053.48	Iron
80	2439.4.45	7053.80	Iron

Point #	Northing	Easting	Desc
81	2439.4.91	7137.90	Iron
82	2445.2.91	7137.58	Iron
83	2449.2.28	6884.07	Iron
84	2450.3.86	6819.97	Iron
85	2444.5.95	6825.04	Iron
86	2444.3.32	6690.41	Iron
87	2450.1.31	6689.27	Iron
88	2472.3.51	6882.11	Iron
89	2478.1.51	6881.61	Iron
90	2478.2.95	7144.58	Iron
91	2472.4.95	7144.90	Iron
92	2500.6.59	6815.70	Iron
93	2500.7.14	6879.69	Iron
94	2512.5.91	6847.55	Iron
95	2508.4.15	6887.65	Iron
96	2513.4.35	6926.69	Iron
97	2511.2.16	6999.12	Iron
98	2505.4.16	6999.44	Iron
99	2511.2.94	7141.77	Iron
100	2505.4.94	7142.09	Iron
101	2512.9.30	6935.32	Iron
102	2507.9.26	6905.98	Iron

Point #	Northing	Easting	Desc
6000	2333.4.34	7185.55	0+00
6001	2393.7.73	7189.38	6+03.40–PC
6002	2414.8.86	7113.52	8+32.43–PT
6003	2417.8.11	7089.08	8+70.55–TEE
6004	2428.4.42	7016.94	9+83.04–WLV
6005	2427.8.77	7004.11	10+03.04–BO
6006	2358.0.48	6511.84	0+00
6007	2384.8.17	6528.57	2+68.21–FH
6008	2387.3.12	6530.13	2+93.21–PC
6009	2396.5.11	6563.44	3+92.28–PT
6010	2401.4.03	6599.28	4+53.02–PC
6011	2408.5.15	6736.24	6+12.91–PT
6012	2408.8.43	6904.23	7+80.93–PC
6013	2409.2.75	6944.01	8+21.00–FH
6014	2414.0.91	7044.58	9+33.67–PT
6015	2368.5.20	7187.78	3+50.87–FH
6016	2359.0.20	7187.17	2+55.87–PM
6017	2408.3.05	7165.19	7+31.87–PM
6018	2408.7.23	6942.90	7+19.59–PM

Baughman

Blackston Addition - Phase II

Coordinates

Water Districution System

Baughman Company, P.A. 315 Ellis St. Wichita, KS 67211 P 316.262.7271 F 316.262.0149
ENGINEERING | SURVEYING | PLANNING | LANDSCAPE ARCHITECTURE

PROJECT NUMBER: 448-90186

REVISIONS:

DESIGN	DRAWN
NBW/JAK	JAK
APPROVED	DATE
AEG	9/11/14

SCALE: 1" = 100'

SHEET 12 OF 13

E:\Projects\Blackstone\Engineering\Phase 2\Wtr_08-06-E136\12_ Coord.dwg