
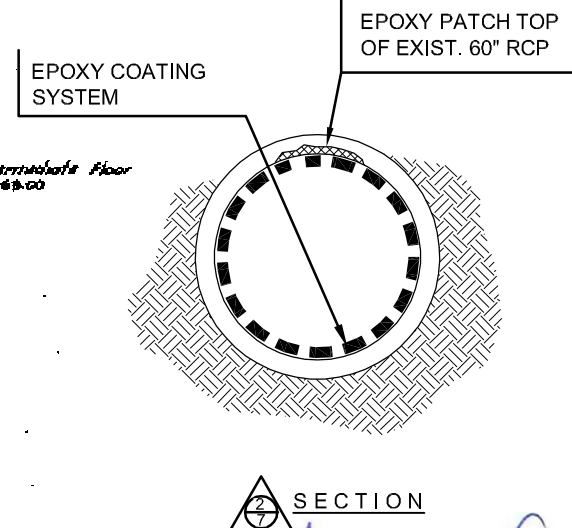


CITY OF WICHITA, KANSAS
WASTEWATER TREATMENT PLANT #2
HEADWORKS IMPROVEMENTS

©2014 MKEC Engineering
All Rights Reserved
www.mkec.com
These drawings and their contents, including, but not limited to, all concepts, designs, & ideas are the exclusive property of MKEC Engineering (MKEC), and may not be used or reproduced in any way without the express consent of MKEC.

RAW WATER PUMP STATION SECTION		
PROJECT NO.	1401010275	
DATE	07/31/14	
SCALE	N.T.S.	
DESIGNED	DRAWN	CHECKED
KJS	DPG	KJS
ISSUED FOR CONSTRUCTION	09/18/14	
NO.	REVISION	DATE
SHEET NO.		
7 OF 19		

- DESIGN NOTES:
1. REMOVE THREE SLUICE GATES FROM THE INFLUENT WET WELL. INCLUDE ALL GATE EQUIPMENT AND OPERATORS. THE MATERIAL SHALL BECOME THE PROPERTY OF THE CONTRACTOR AND REMOVED FROM CITY OF WICHITA PROPERTY.
 2. INSTALL NEW SLUICE GATES AS SHOWN IN DETAILS.
 3. THE WALL THIMBLE AT SLUICE GATE "C" SHALL BE REMOVED FLUSH WITH THE INFLUENT WET WELL WALL. THE REPLACEMENT GATE SHALL BE IDENTICAL WITH "A" AND "B" AND BE BOLTED DIRECTLY TO THE WALL.

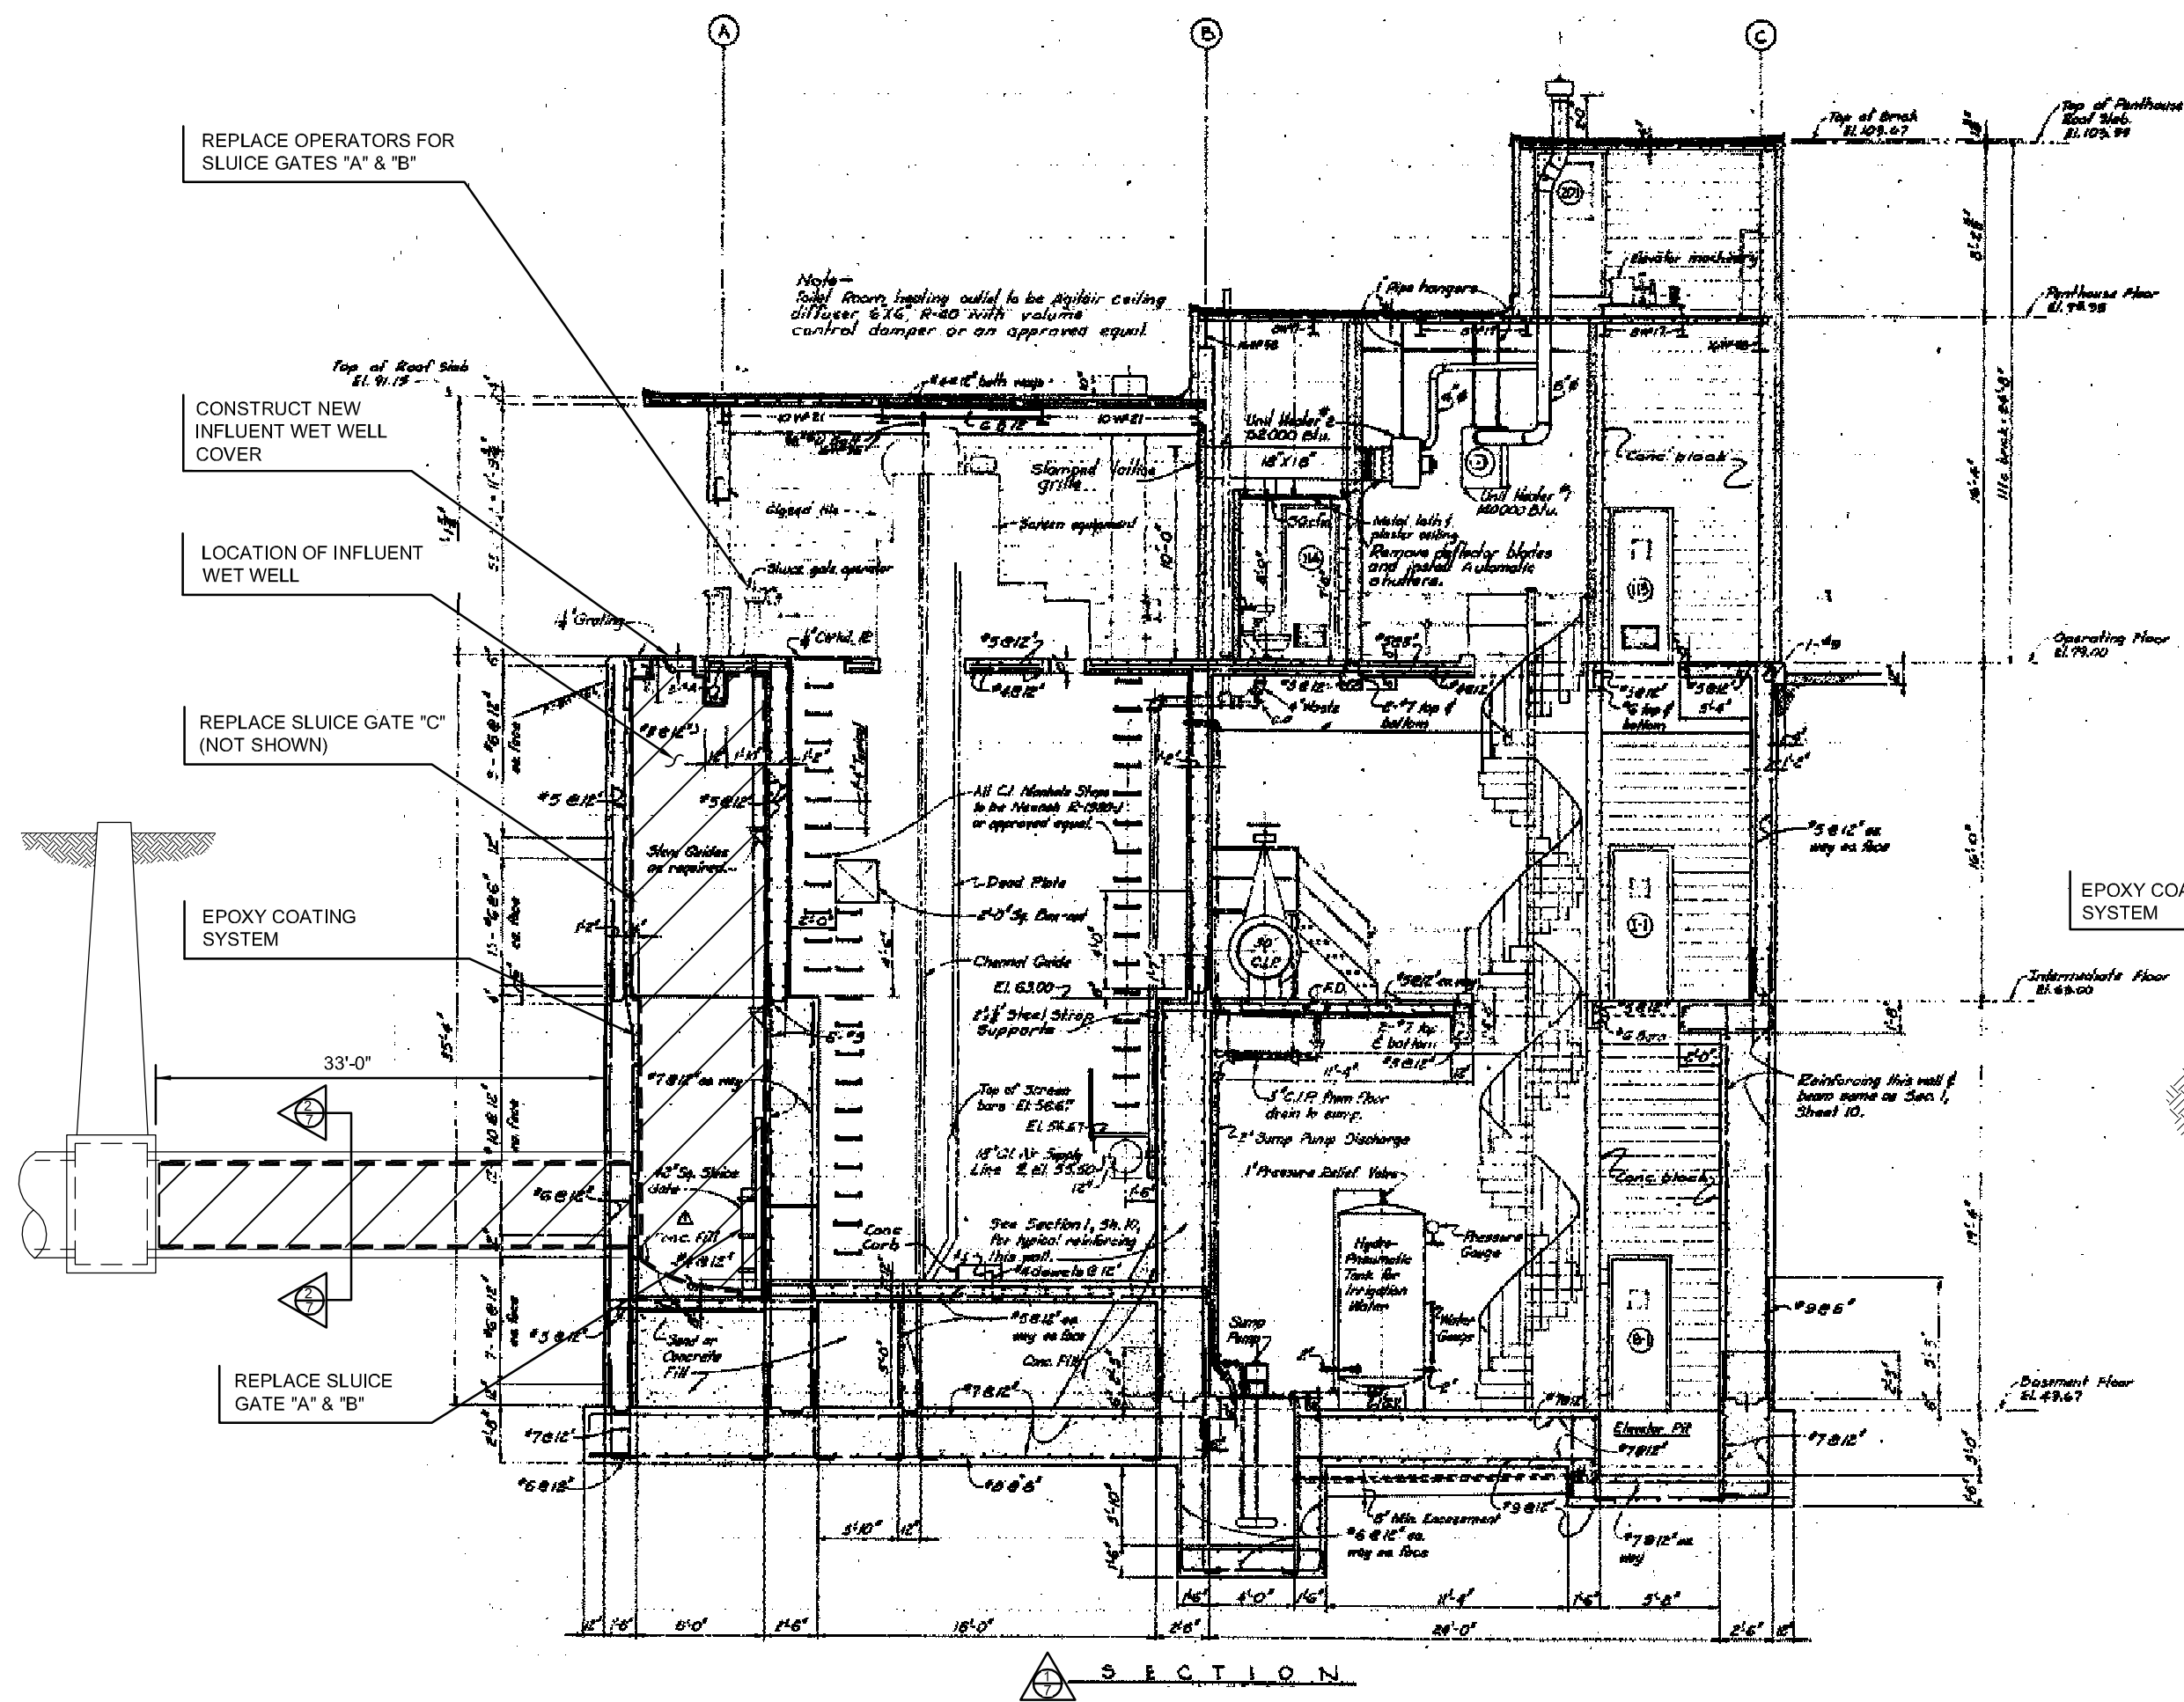

REPLACE OPERATORS FOR SLUICE GATES "A" & "B"

CONSTRUCT NEW INFLUENT WET WELL COVER

LOCATION OF INFLUENT WET WELL

REPLACE SLUICE GATE "C" (NOT SHOWN)

EPOXY COATING SYSTEM

REPLACE SLUICE GATE "A" & "B"

SECTION A-A

SECTION B-B